

8362


OBS
PT. ~~400A~~
PT. ~~2000A~~
18.74Ac

OBS
PT. ~~400A~~
PT. ~~2000A~~
18.74Ac

2000
990

384.58
150
534.58

894.30
-534.58
359.72

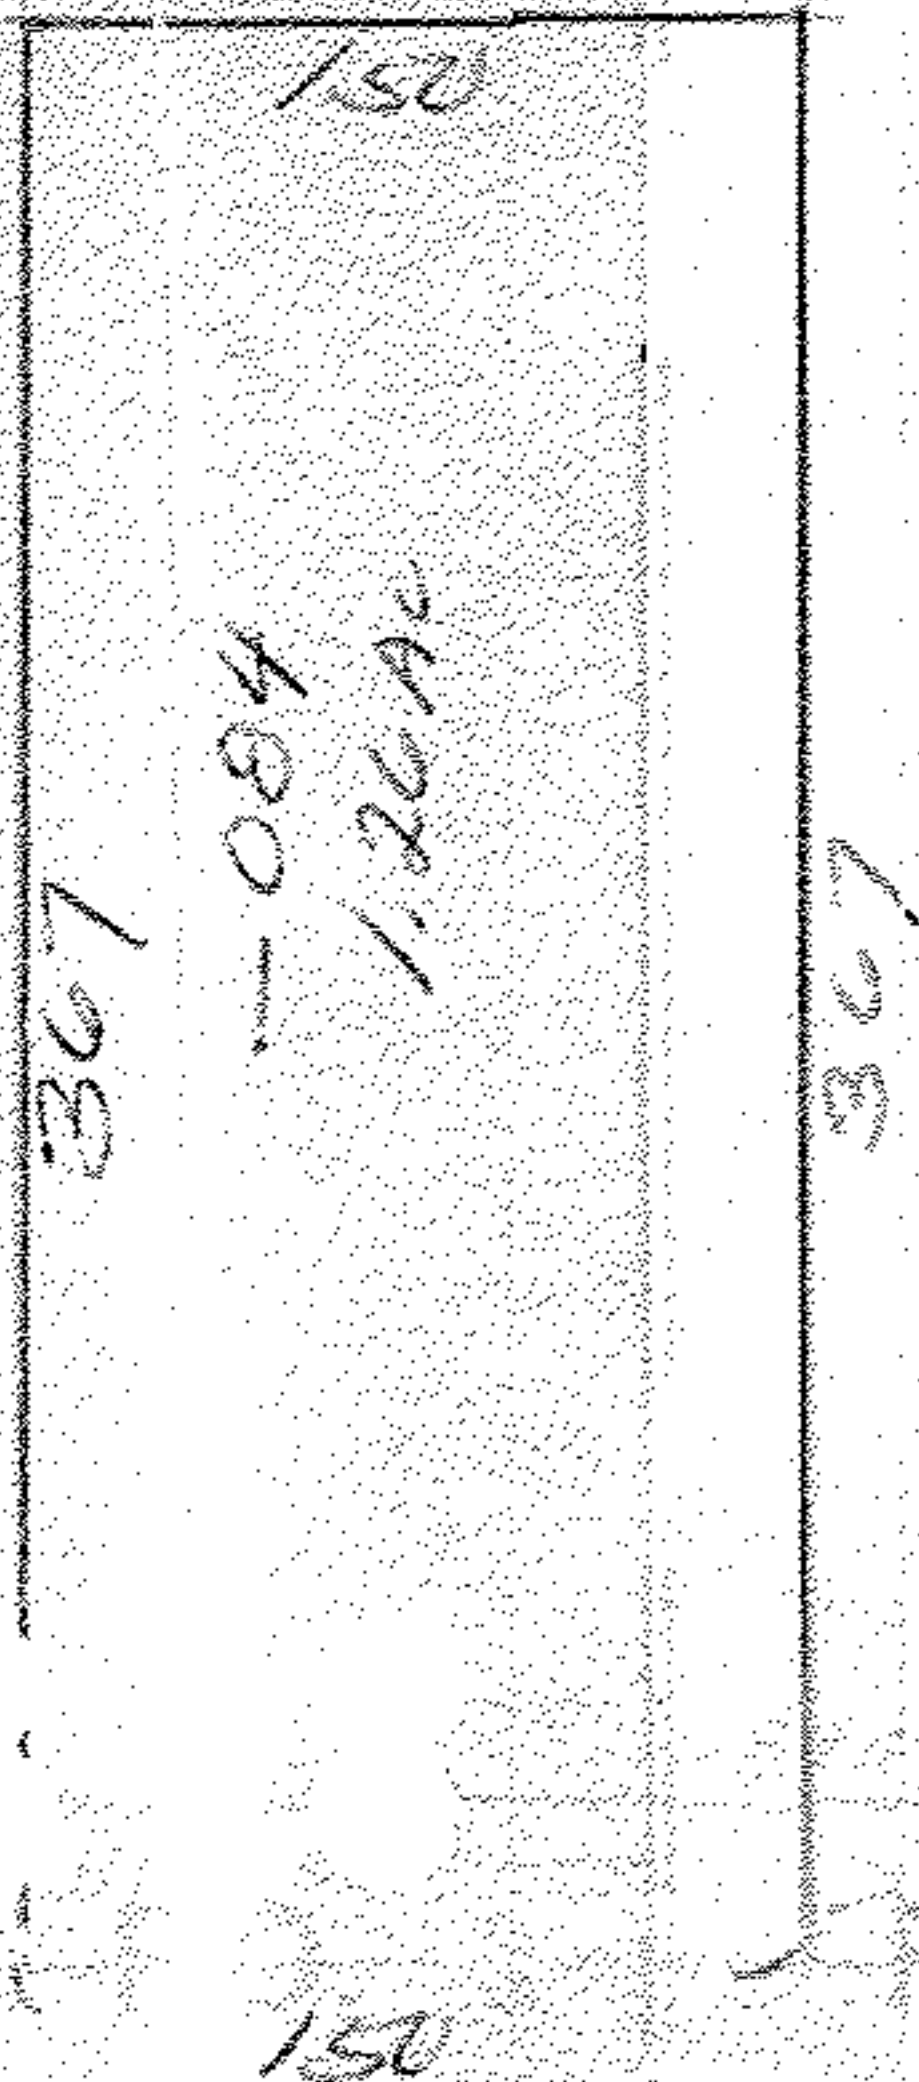

8-1-86 L.L.L.

APPROVED
LORAIN CO.
MAP DIV

MAY 2 1975



10-22-74

04-00-009 E + F

4-00-009 E

359.72

4-00-009 F

384.58

POWDERMAKER

OCT 22 1974