

OCT 28 1974

LAKE

8380


APPROVED
LORAIN CO.
MAP DEPT.

DATE 10-28-74

PAGE 6-4

BY *J. Colbert*

VOID
AFTER

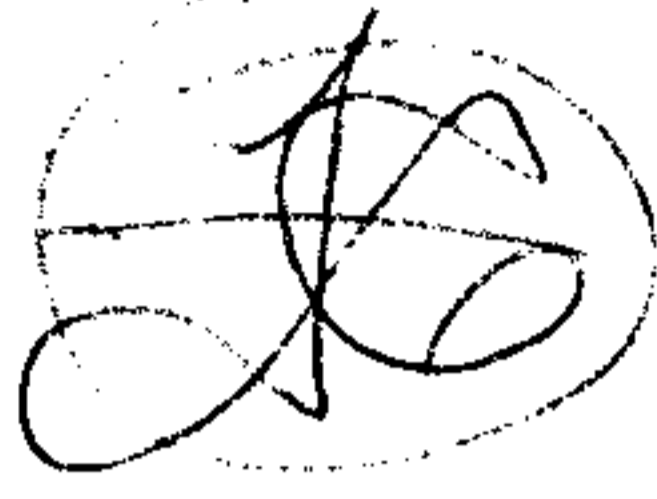


DEC 1 1975

-037

395A

101

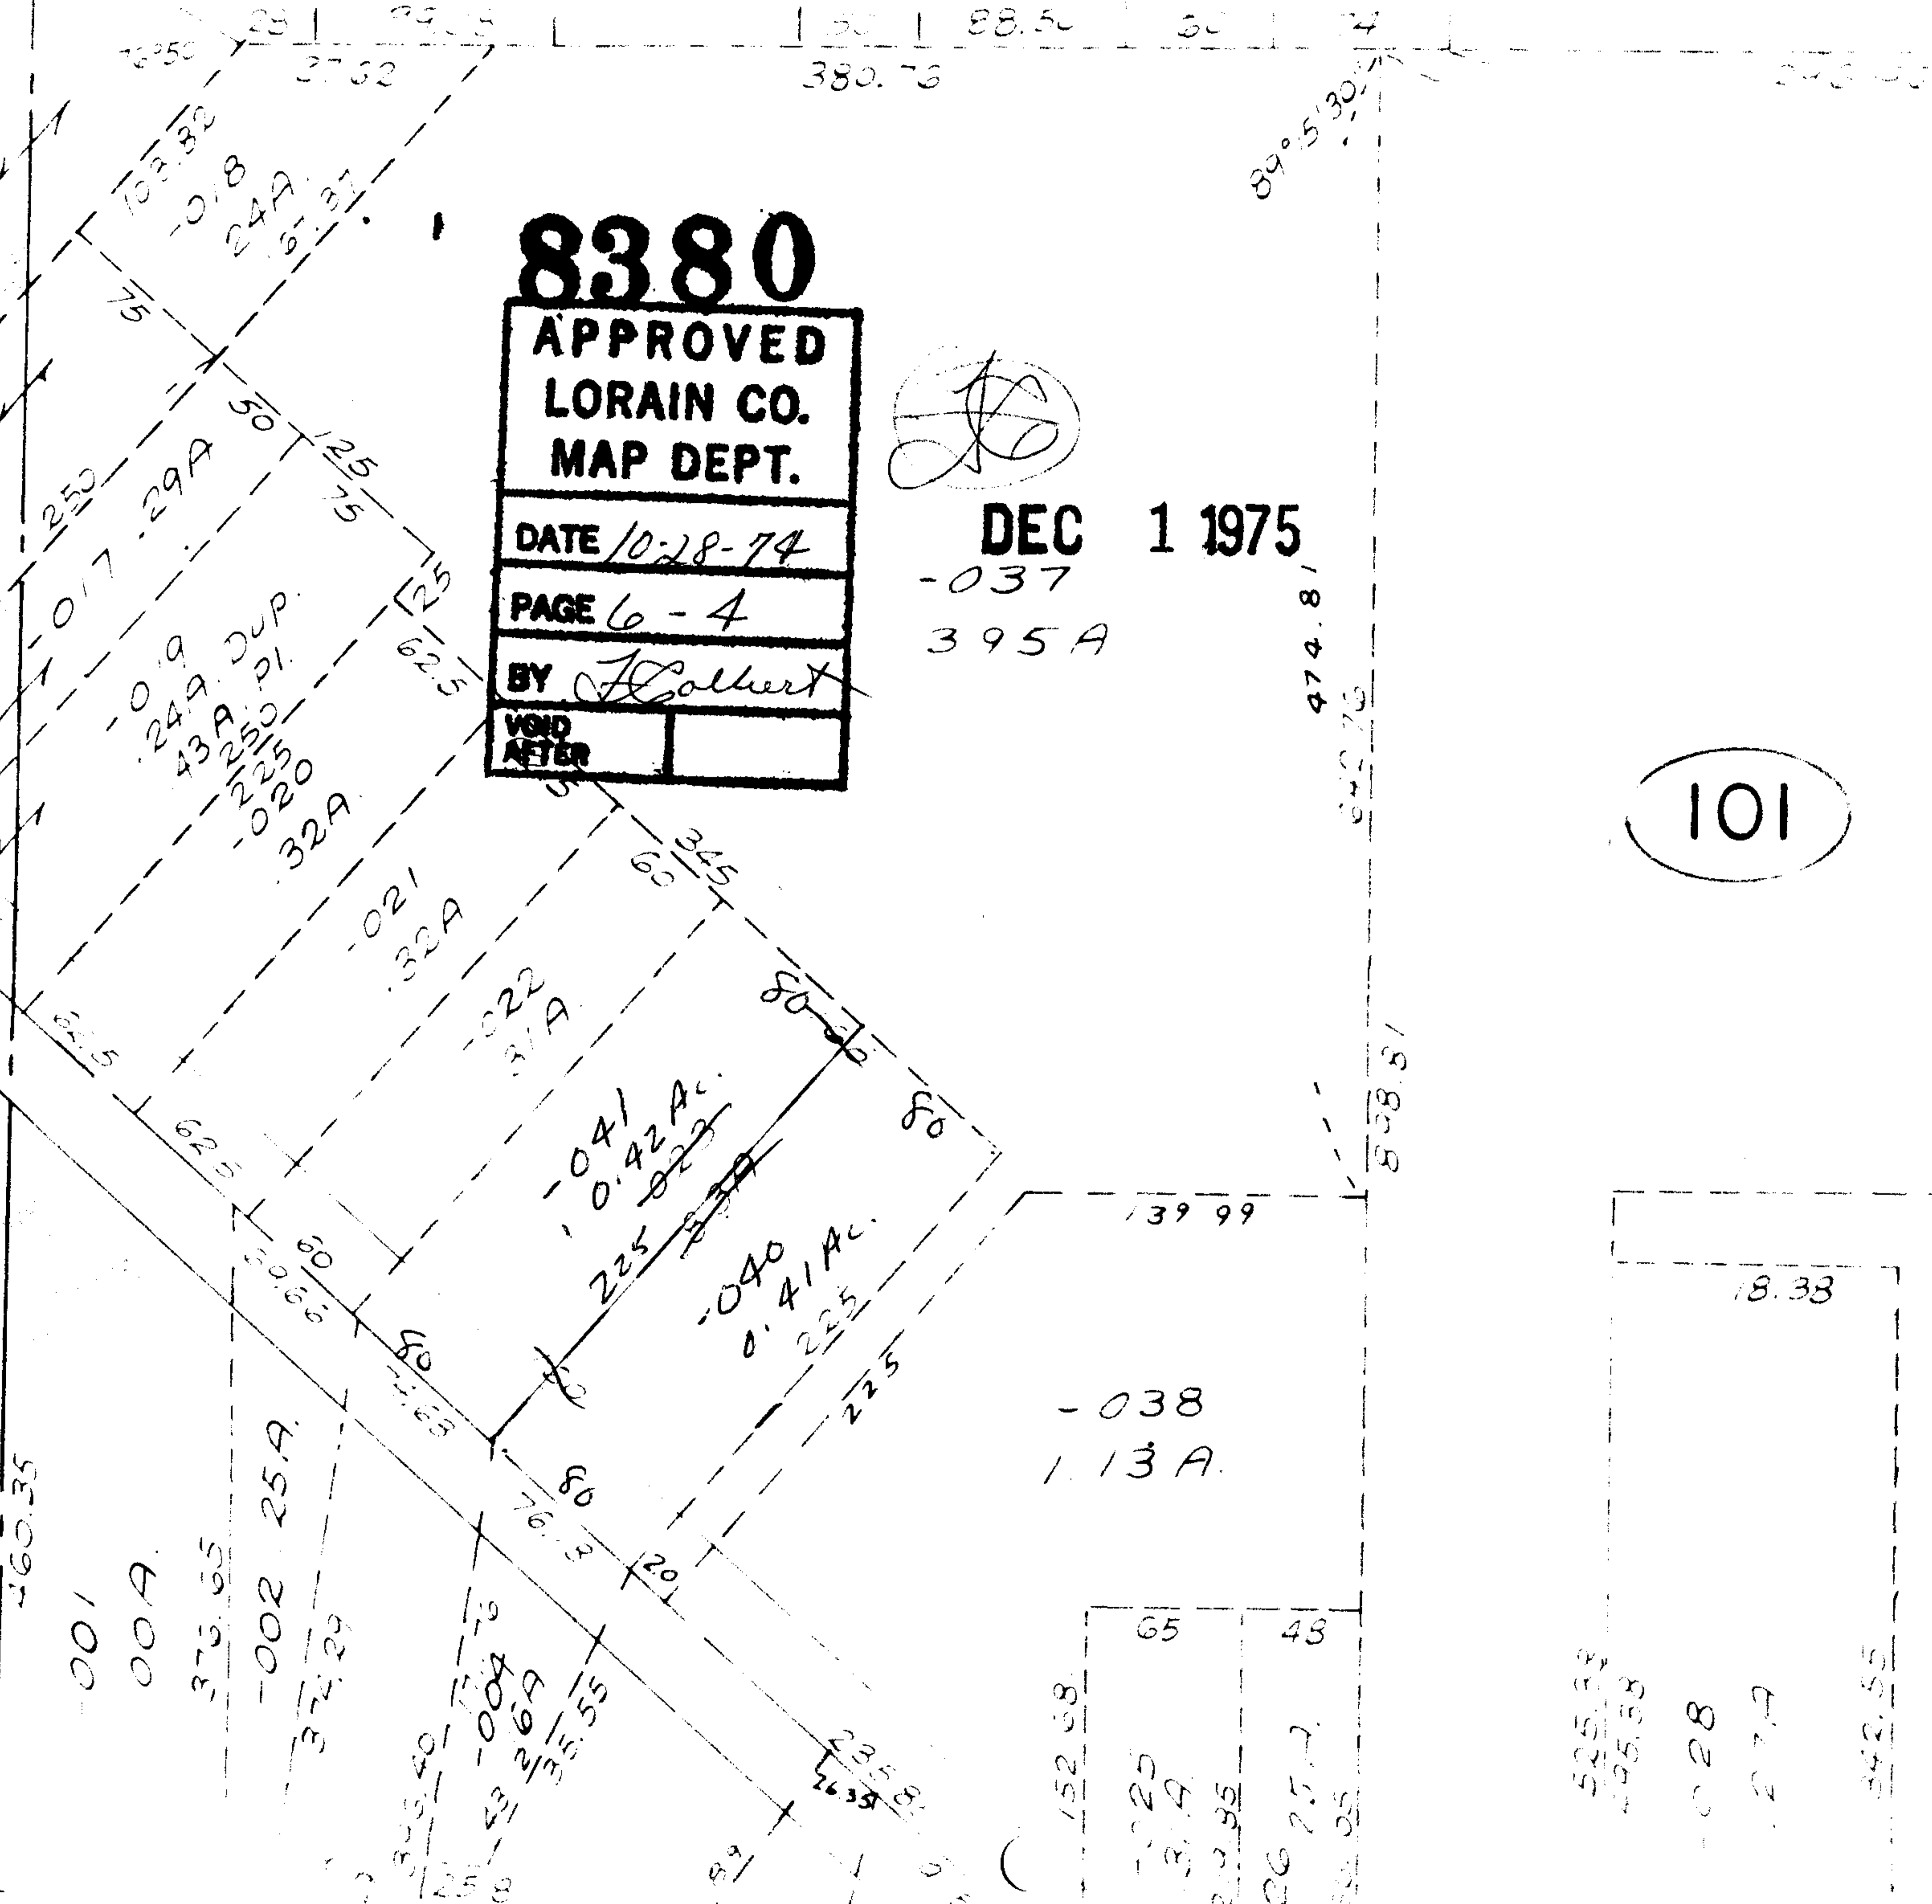

-038
1.13A

18.38

525.33
495.58
820
277
342.55