

8404

NOV 18 1974

145
13
132


DEC 1 1975



8404

APPROVED
LORAIN CO.
MAP DEPT.
DATE 11-7-74
PAGE 6-17
BY L.W. H. [Signature]
VOID AFTER

S.F.M.

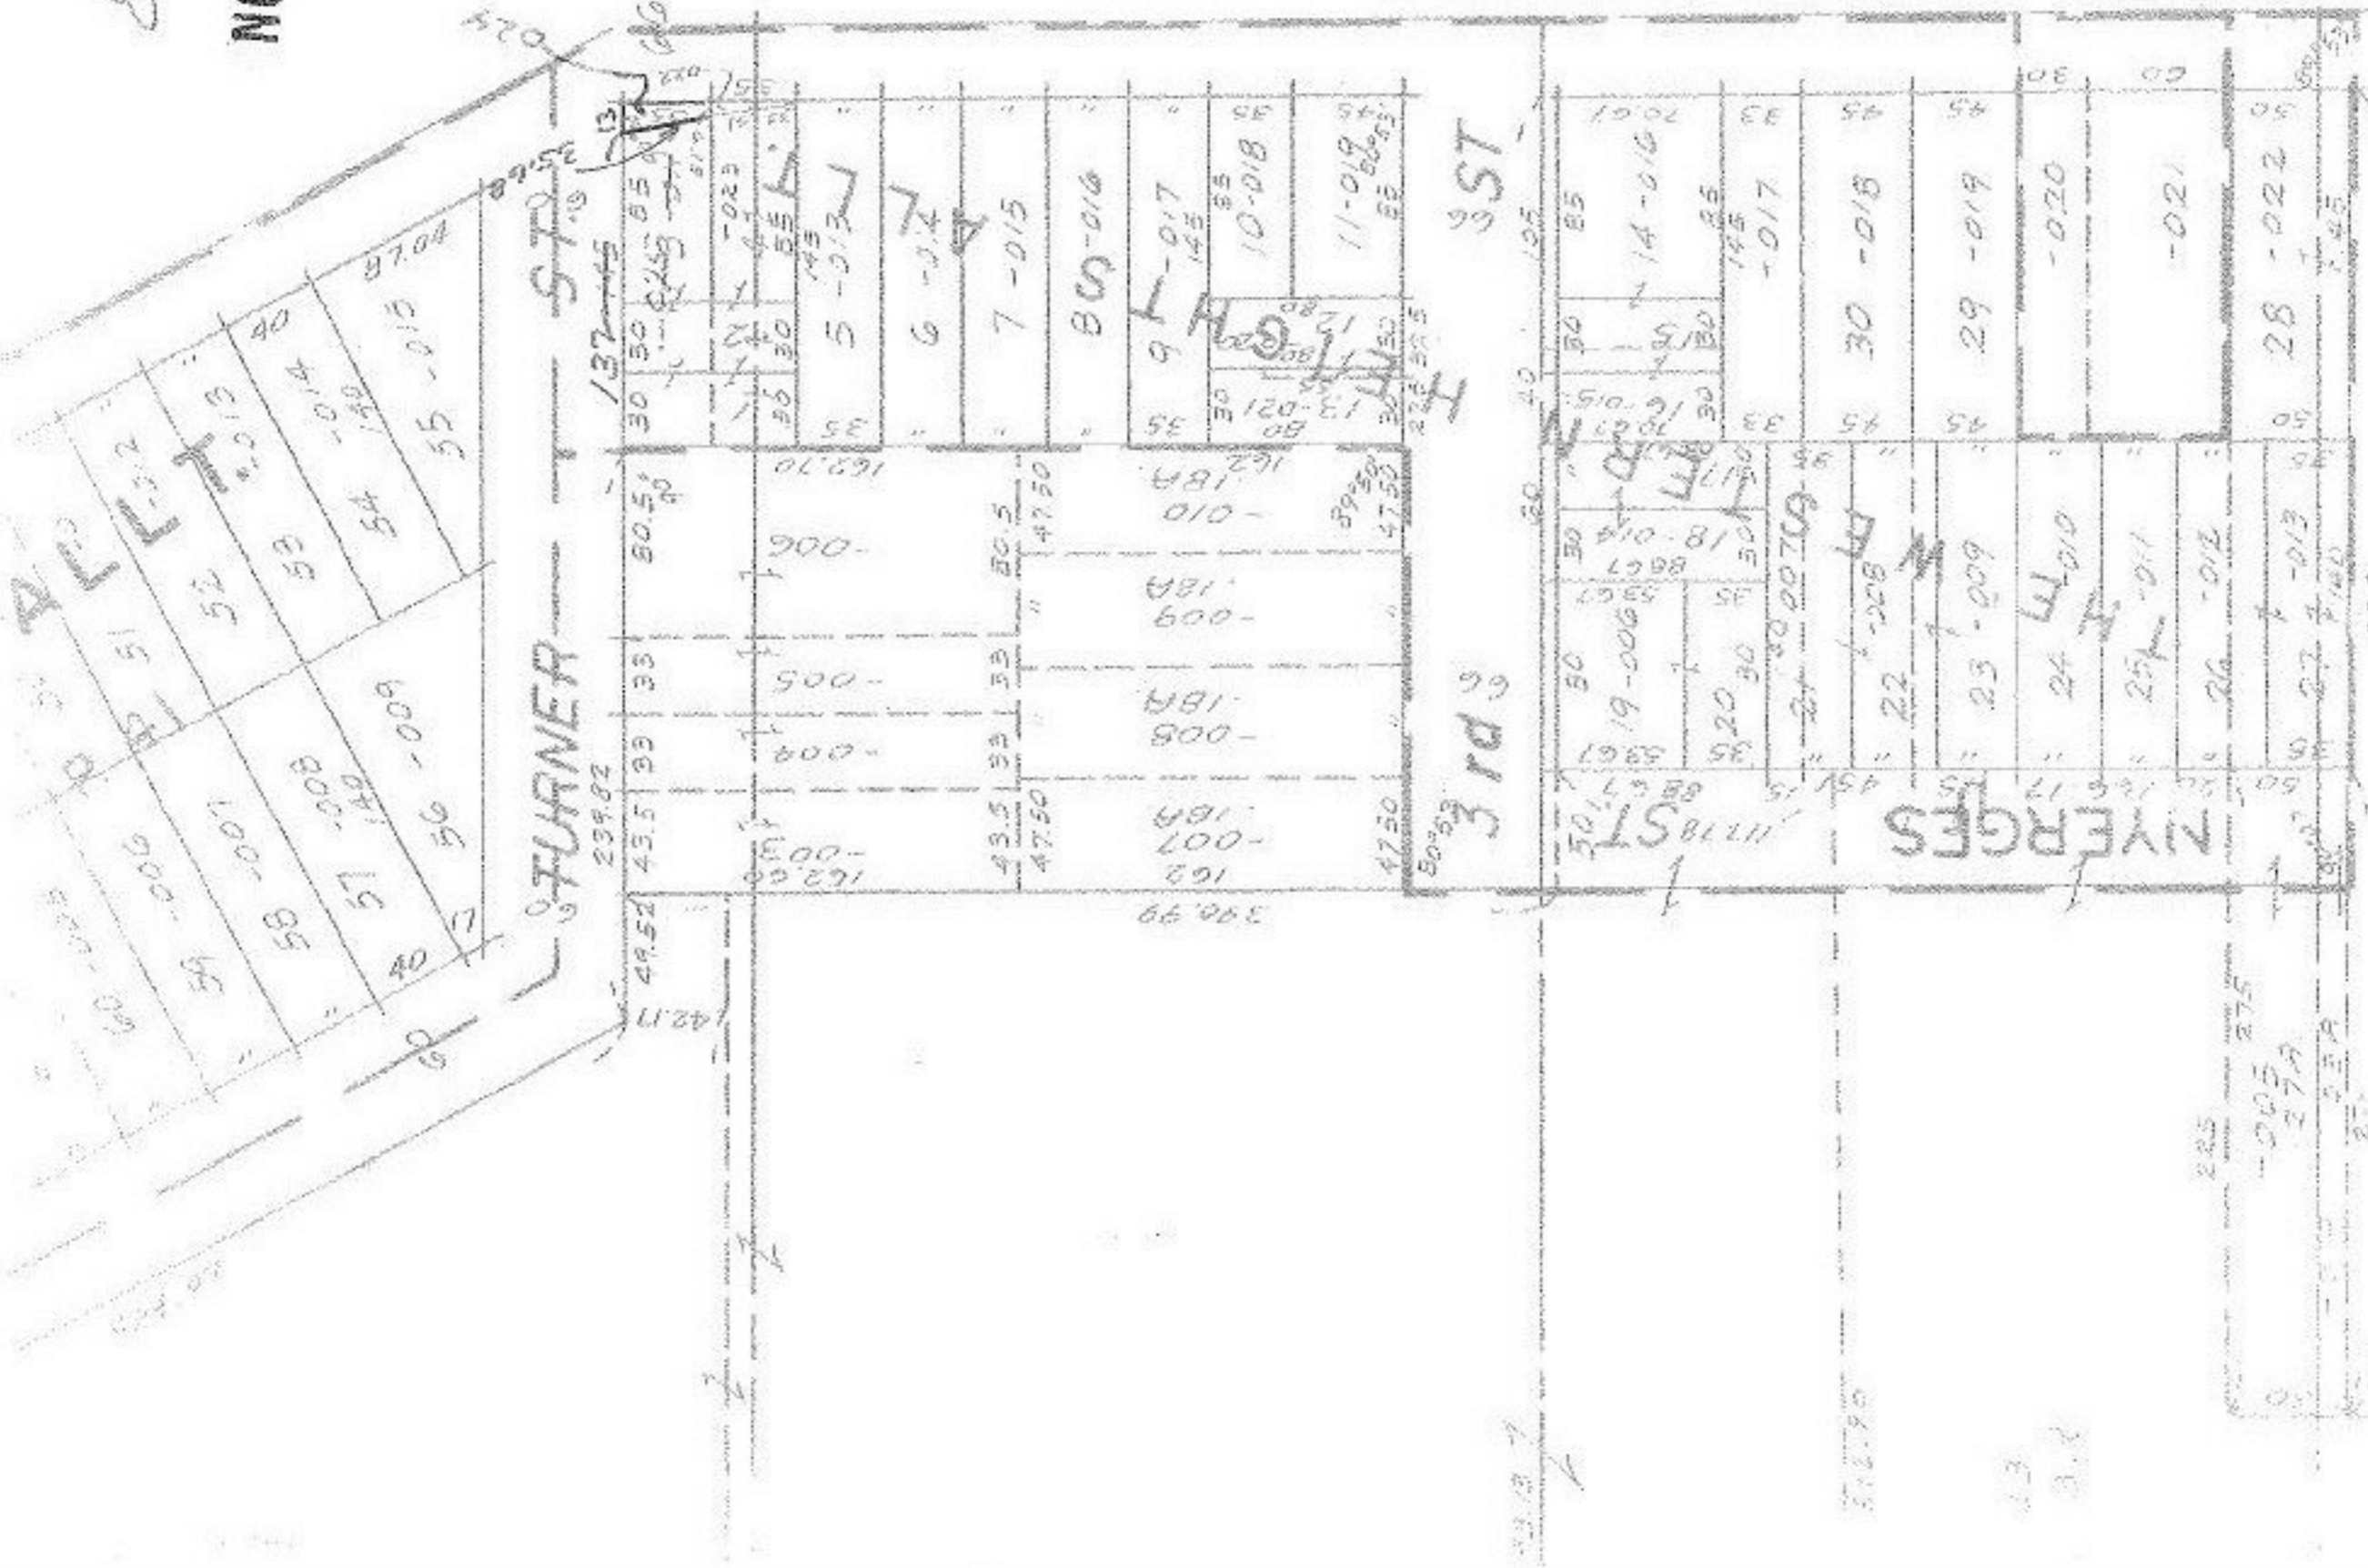

312.90

1.3
0.2

225
-005
275
275
275

500