


8414

NOV 14 1974

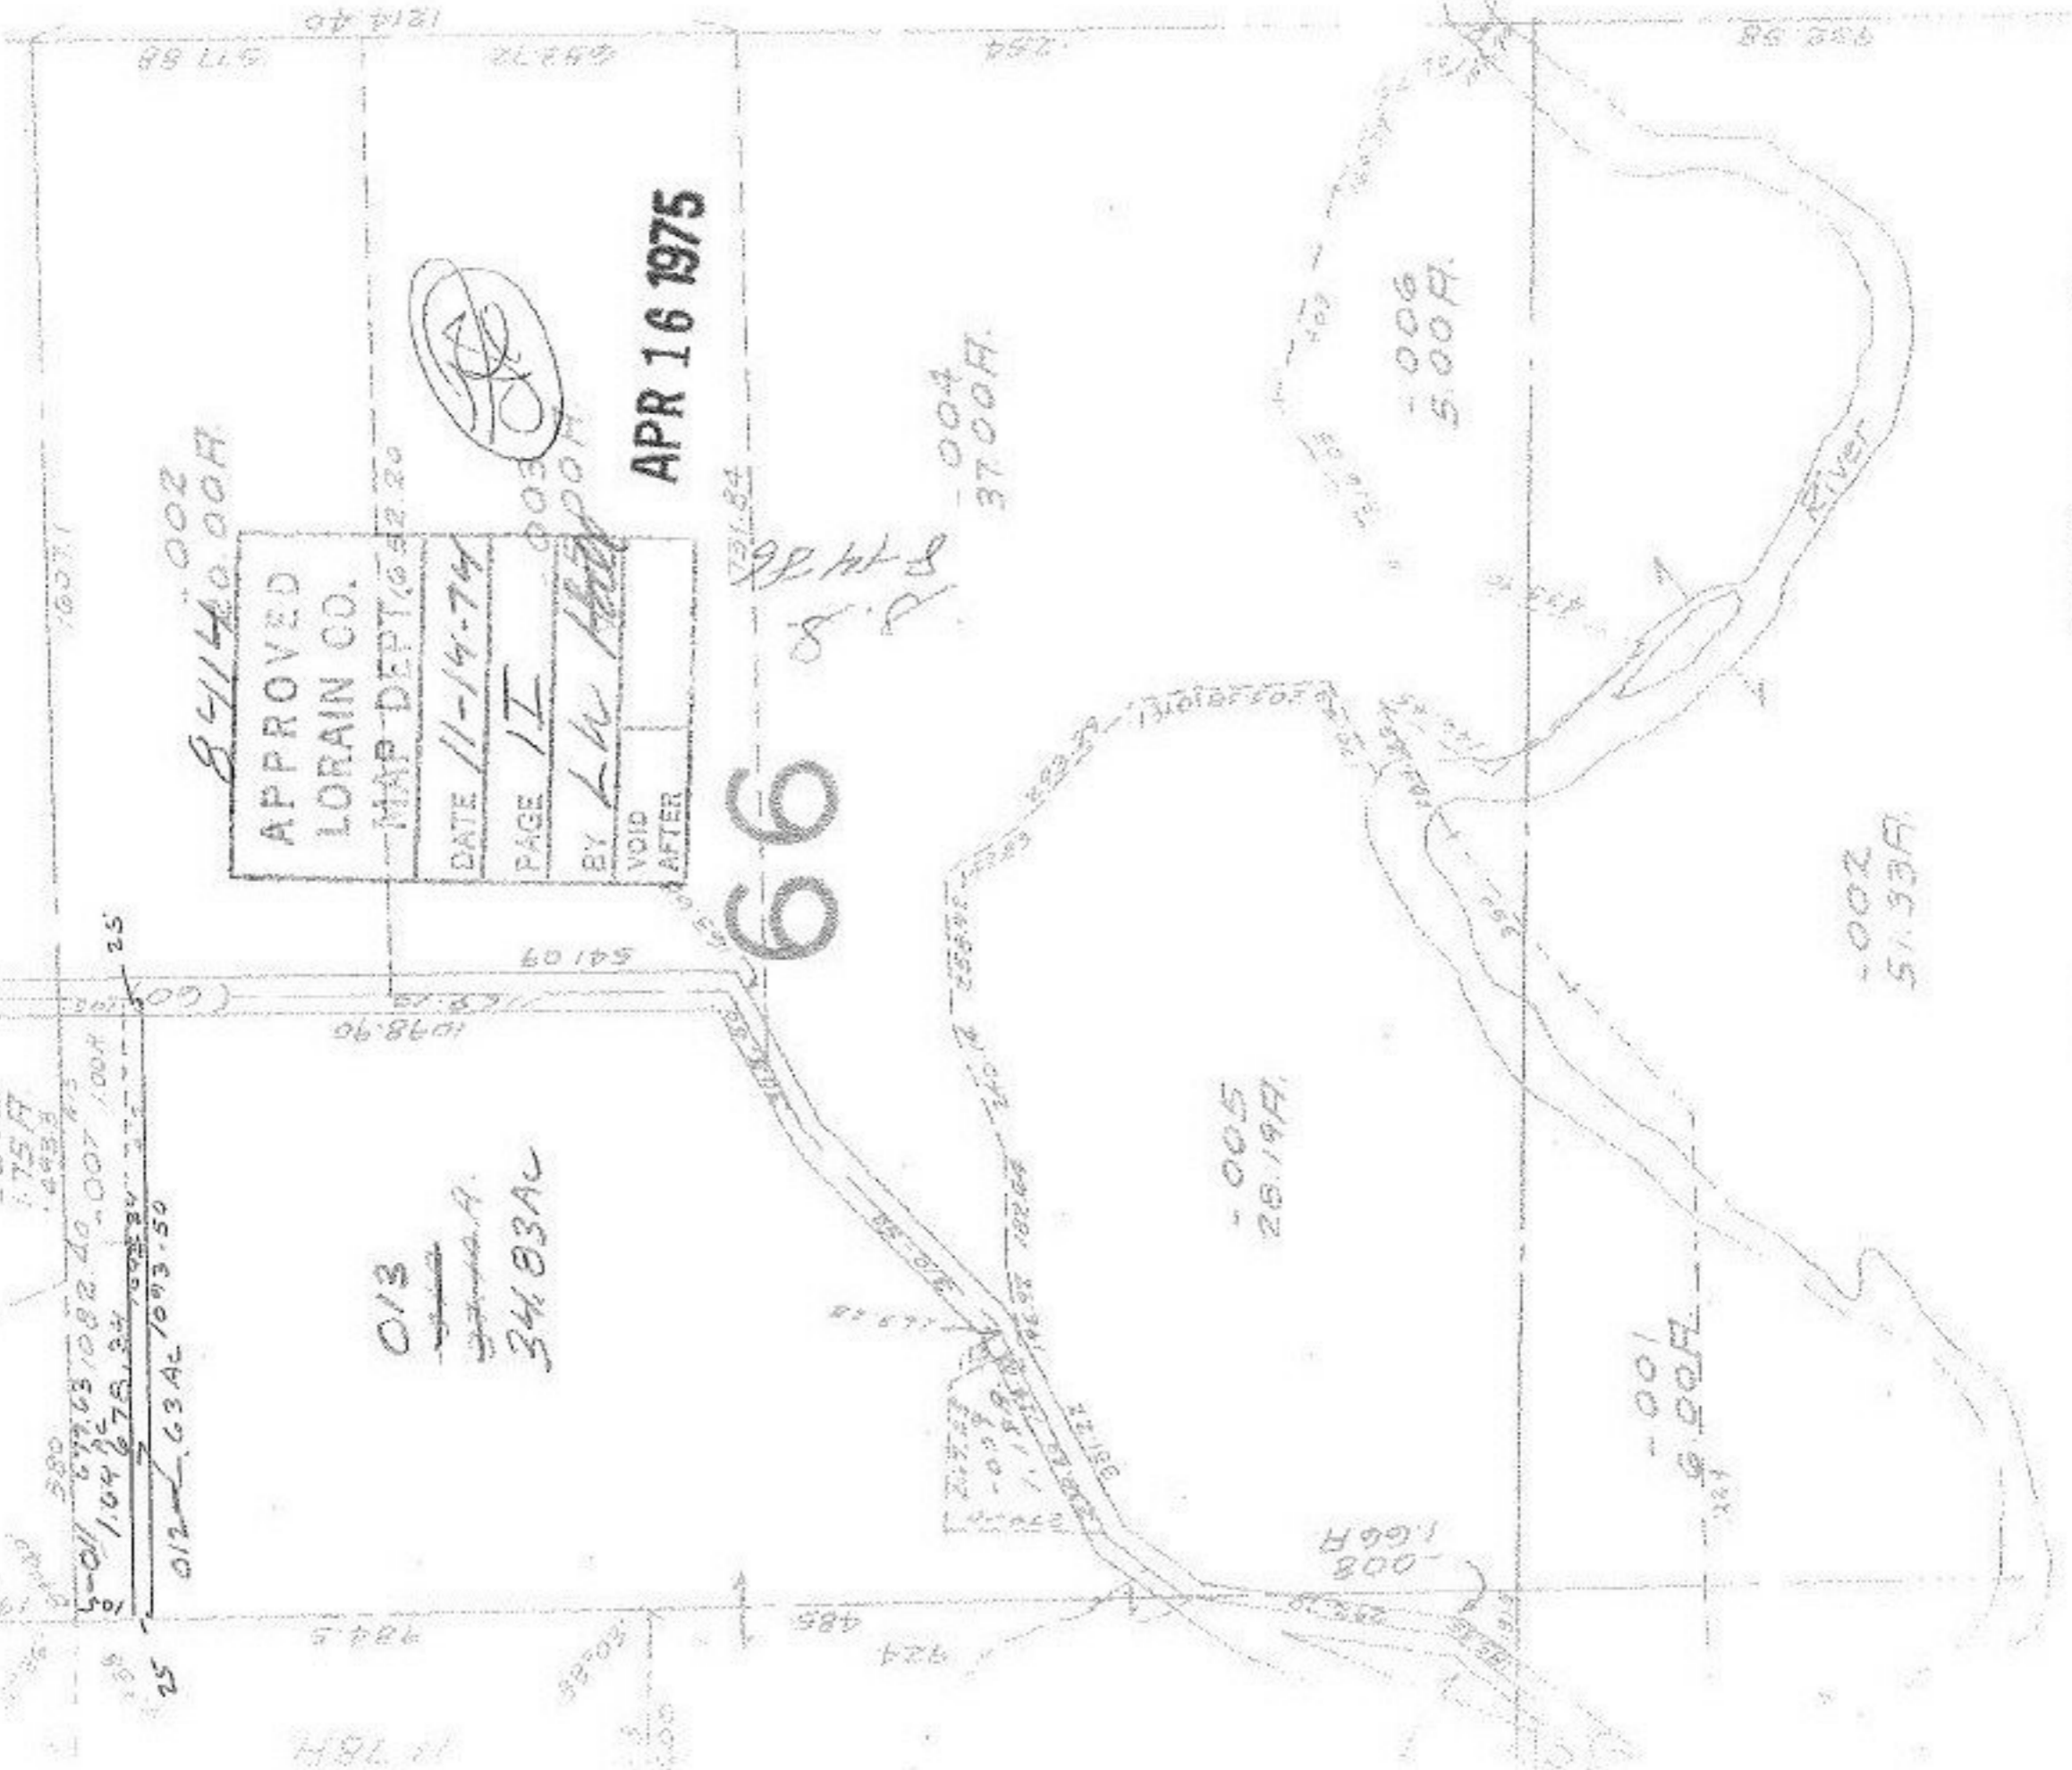

84140.00F

APPROVED
 LORAIN CO.
 MAP DEPT 652.20

DATE	11-14-74
PAGE	11
BY	LW
VOID AFTER	

APR 16 1975

66

013
 J. A. A.
 34.83AC

515
 1.02F
 1.75F
 1.493

580
 5-011 677.63 1082.40 .007 100F
 1.04 675.34 1078.34
 012 63AC 1093.50

21.753
 1.1819
 31.182
 31.182

-005
 26.19F

-008
 1.66F

-001
 6.00F

-002
 51.93F

-004
 37.00F

-006
 5.00F

517.88
 1214.40

254.72

254

932.58

622

25

541.09

1098.90

731.84

S.P. 8

395.30