

8418

NOV 19 1974

AVC

102

DEVONSHIRE WEST


101

AVC

8418

APPROVED
 LORAIN CO.
 MAP DEPT.
 DATE 11-15-74
 PAGE 3-00-047
 BY L.W. Hall
 VOID AFTER

DEC 31 1975

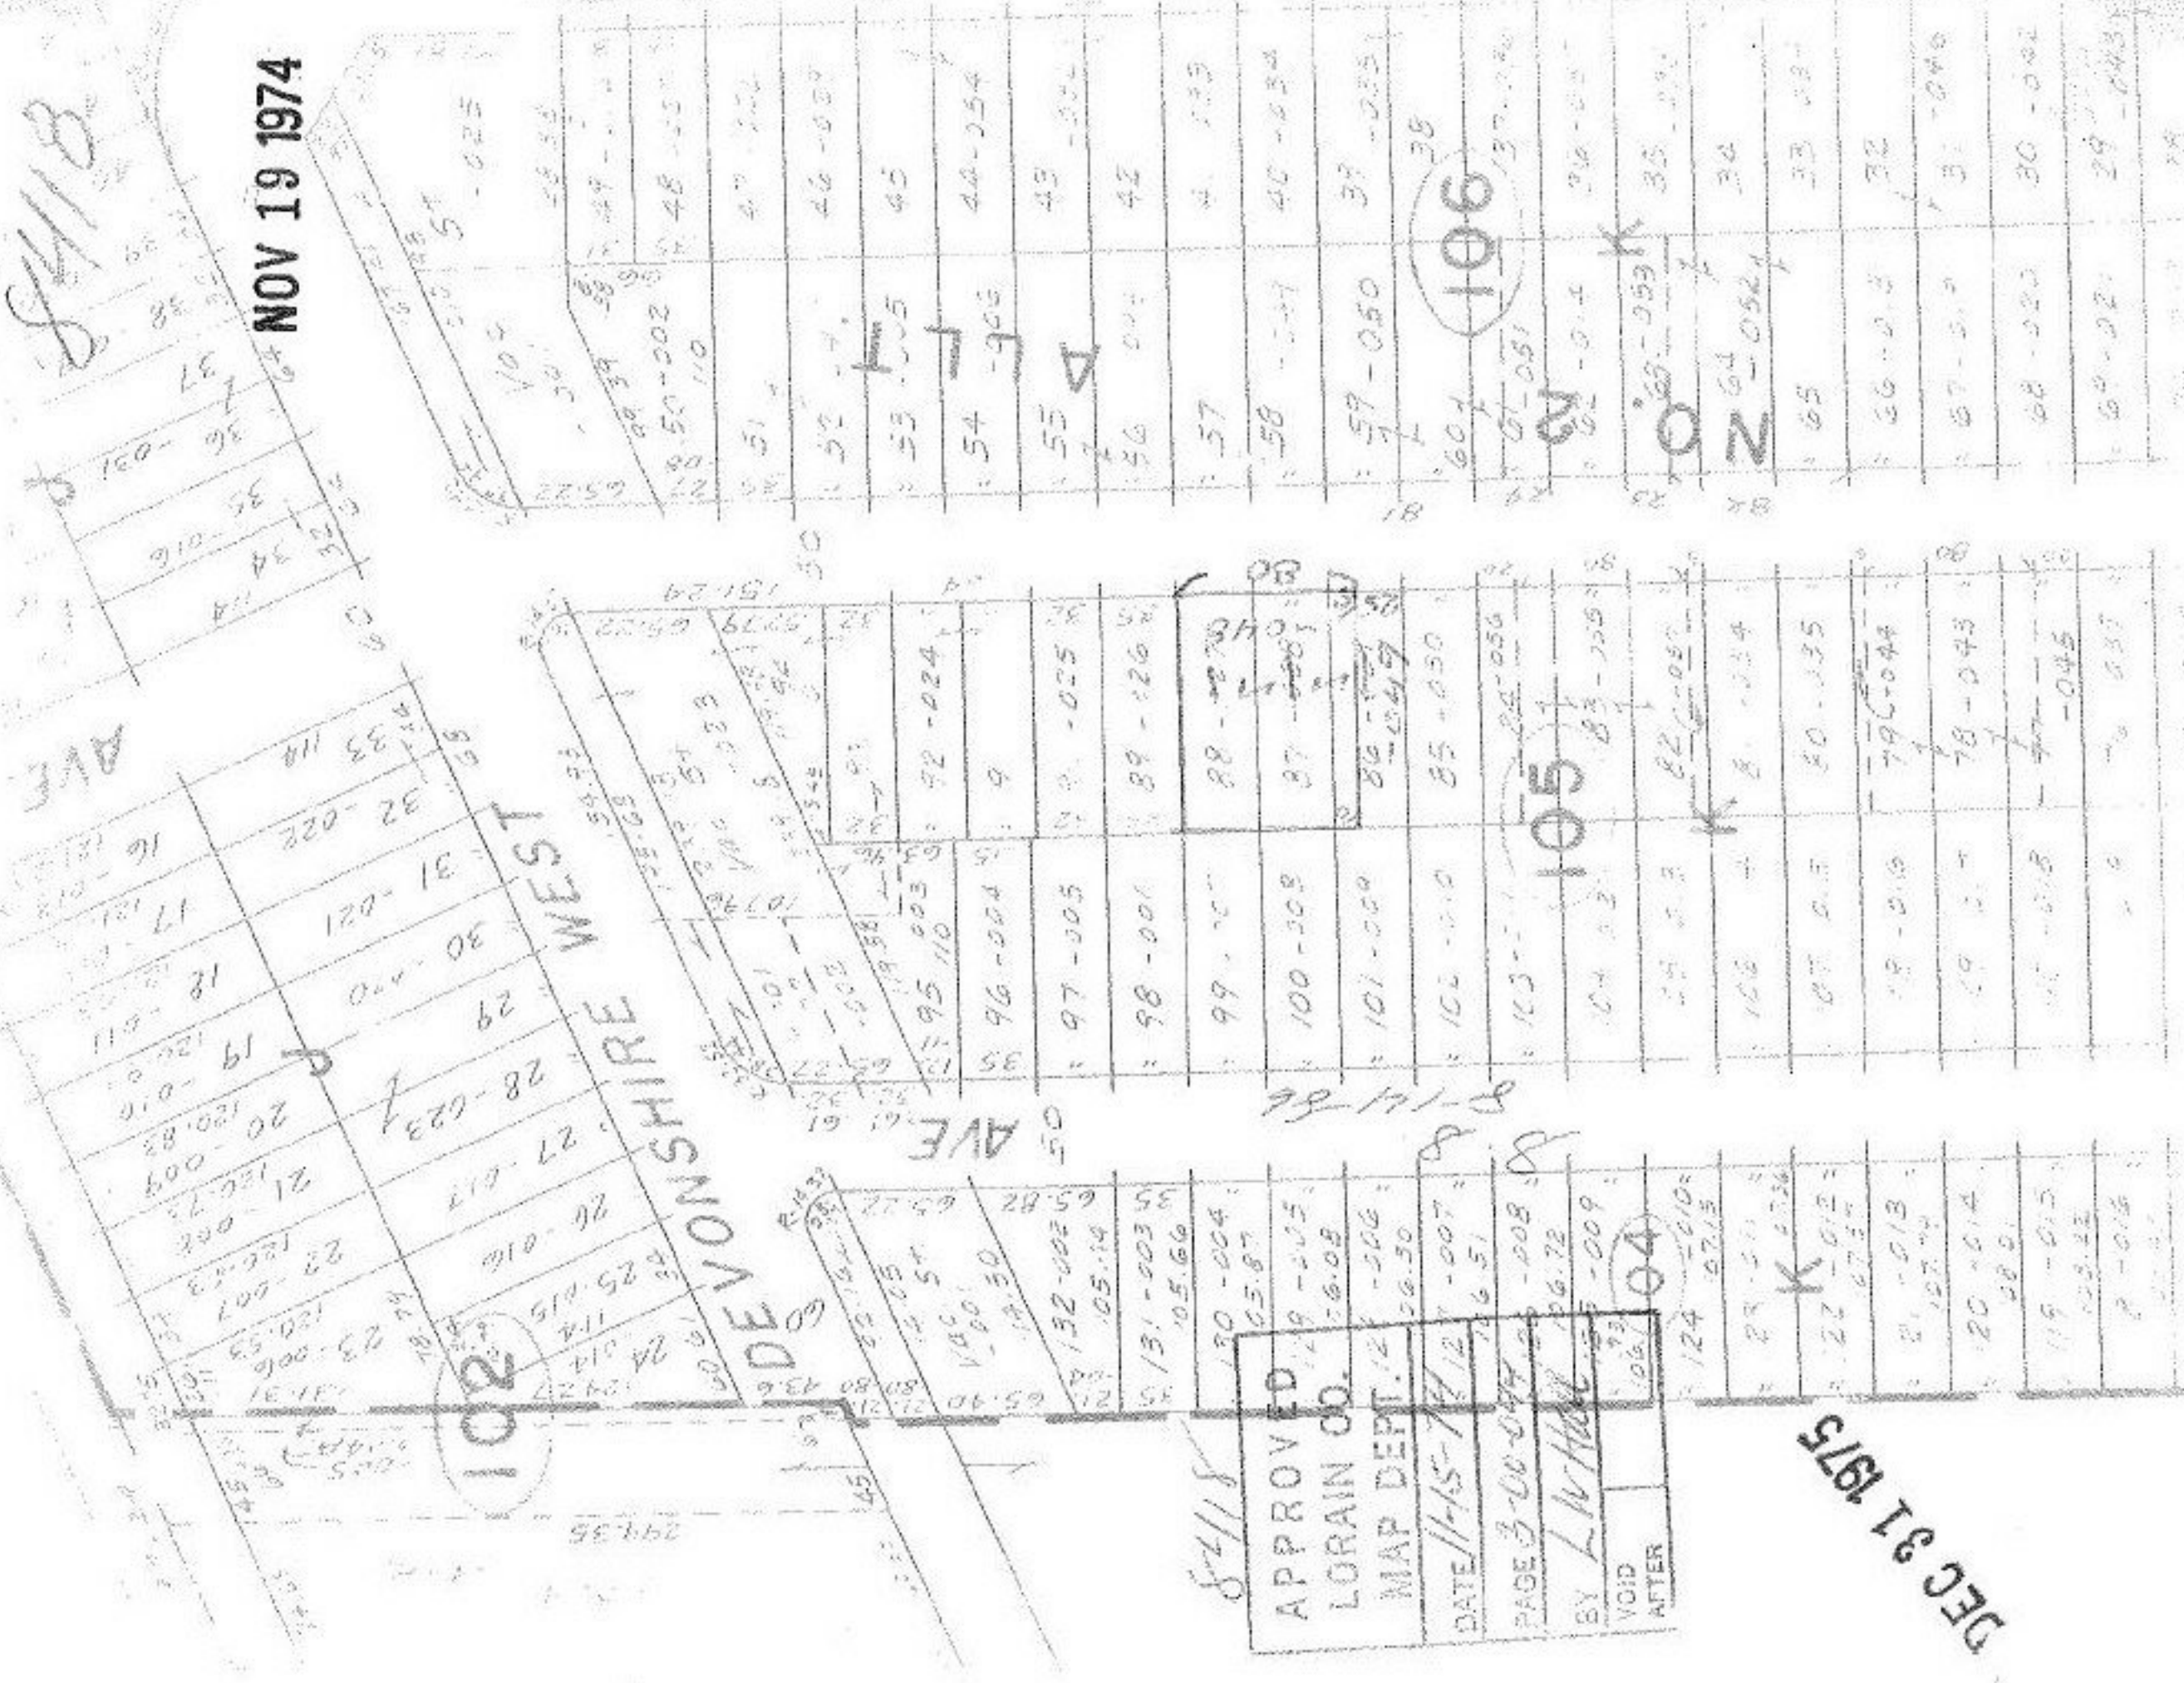

106

105

104

28

28

