


2062.53
1982.59 6727 R
1984.10
1989.10
Frontage
Real Line
B423

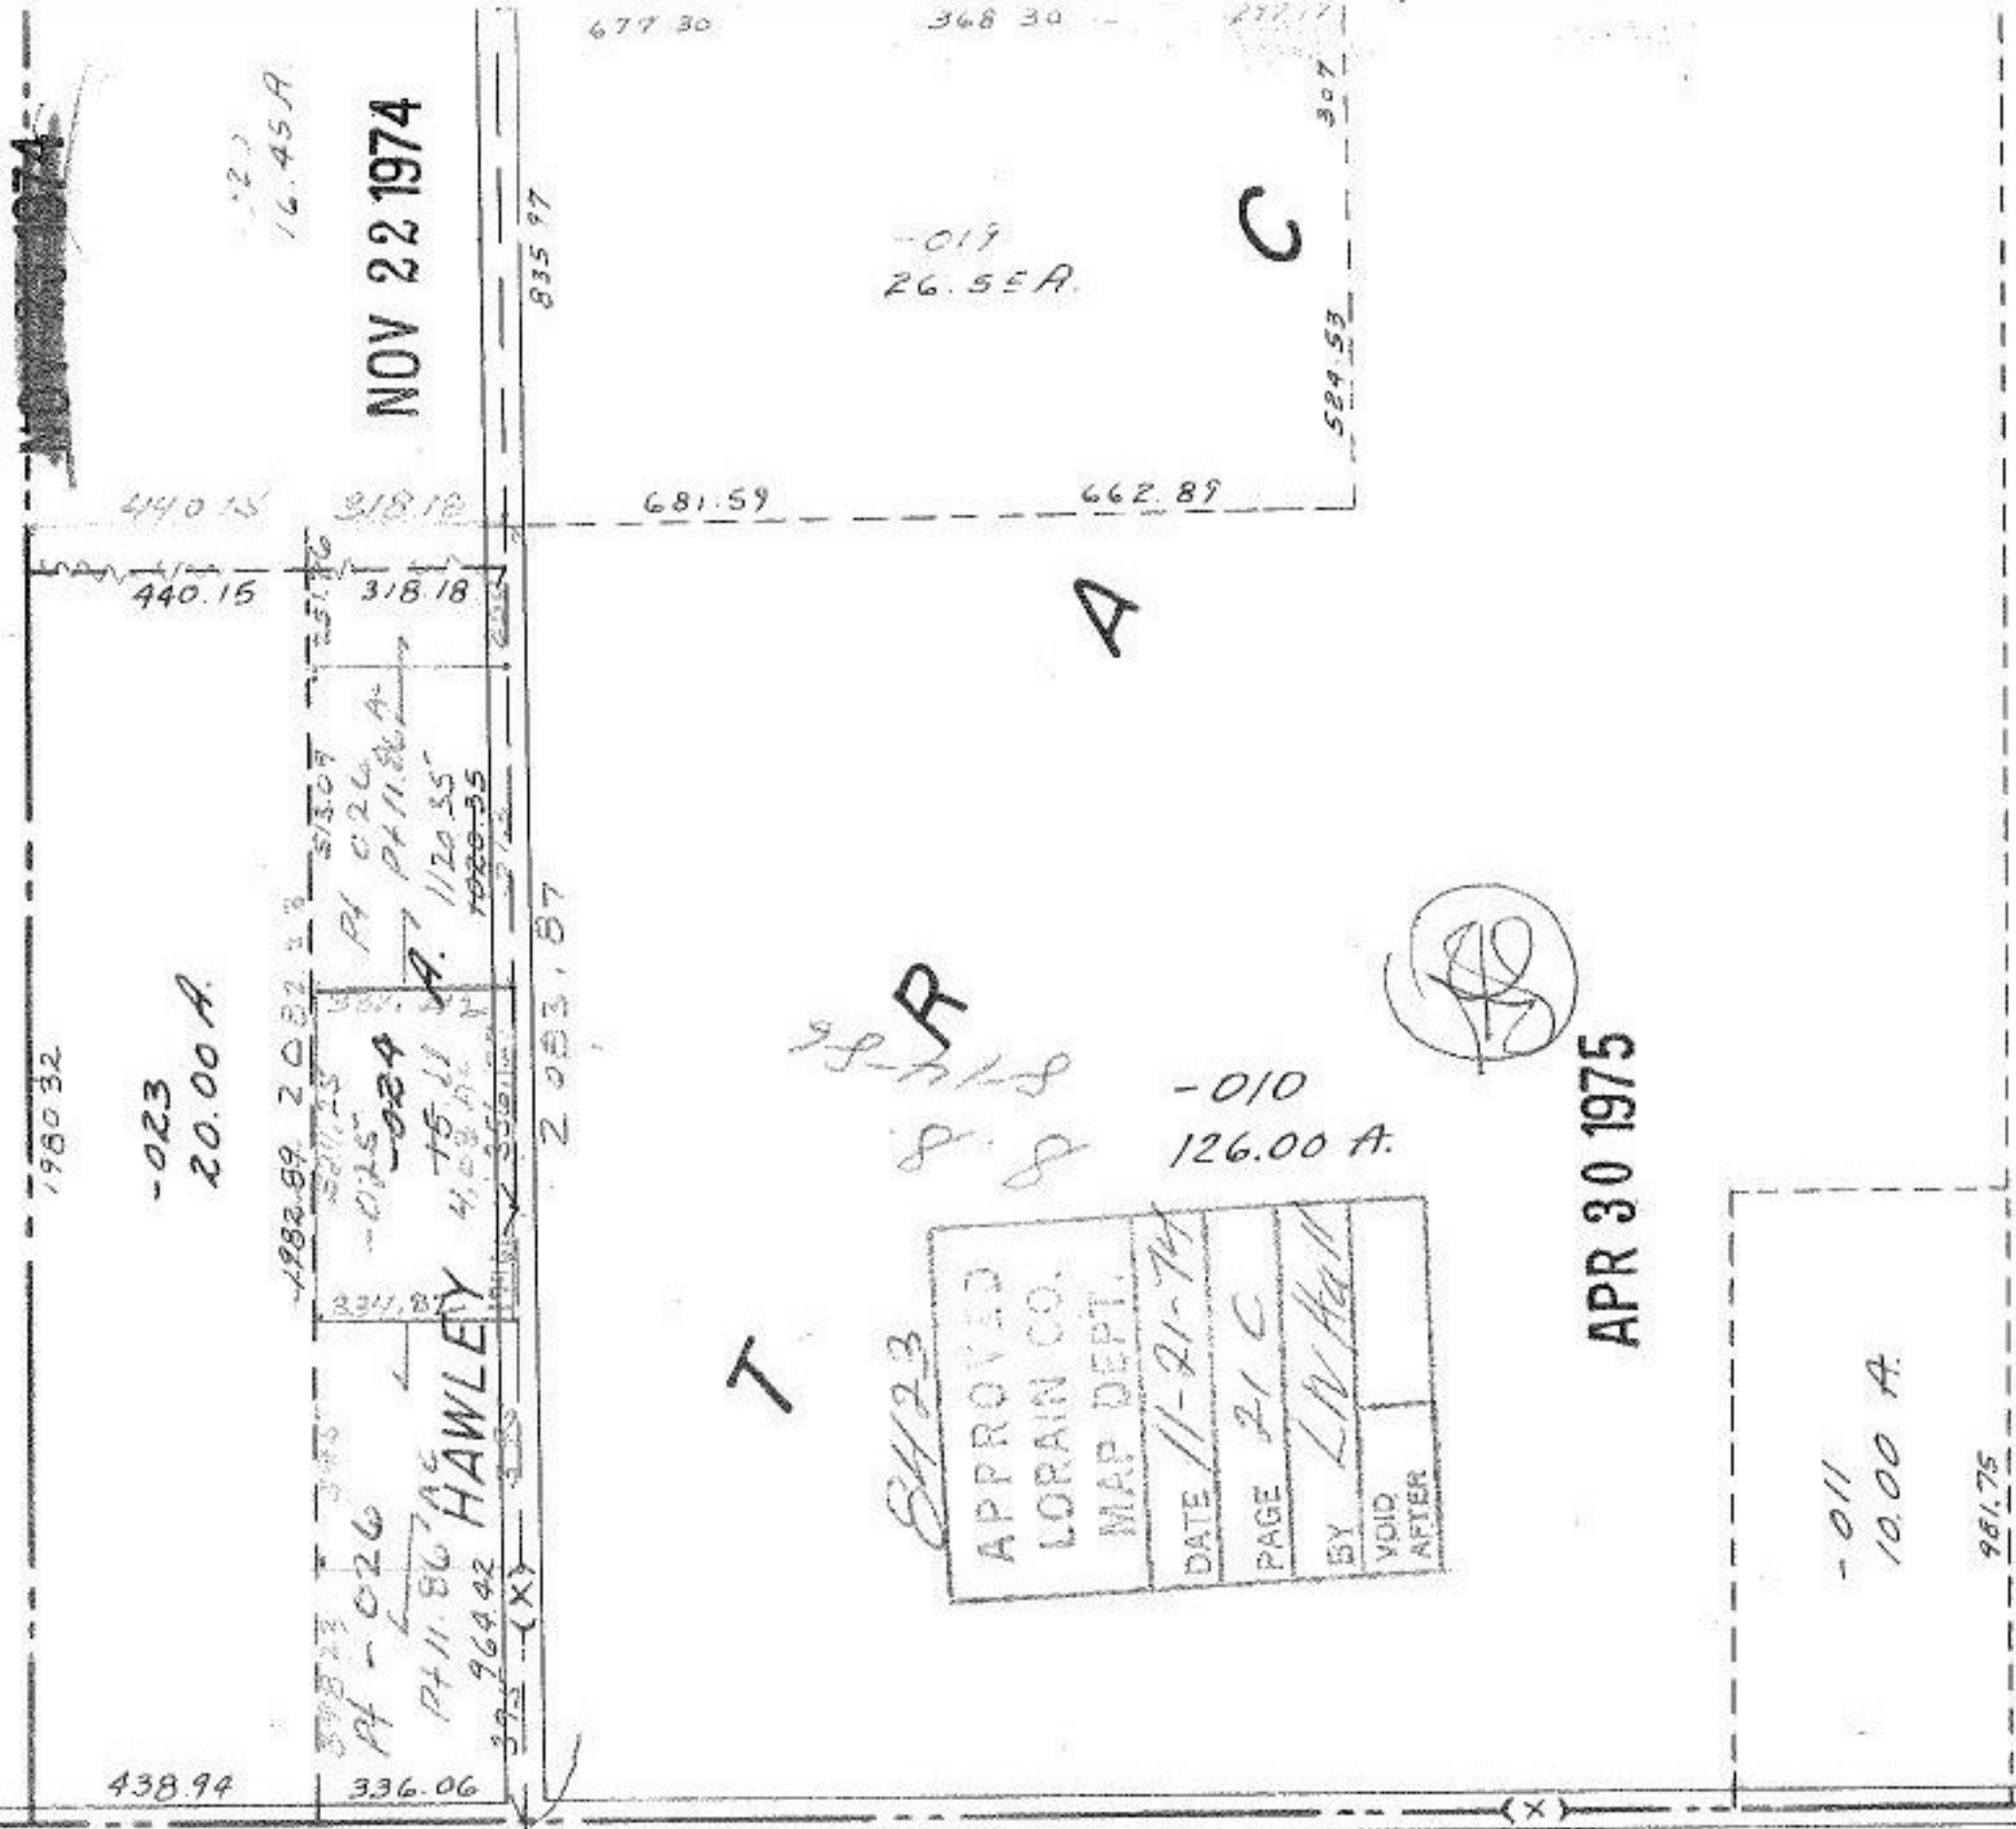

11/2/25

16.45 A

NOV 22 1974

835 97

-019
26.55 A.

C

440.15
440.15

318.18
318.18

681.59

662.89

A

-023
20.00 A.

1982.89 20.82 2.8

1982.89 20.82 2.8
Pt 0.26
Pt 11.86 A.
Pt 11.86 A.
1120.35
1020.35

15.11 A.
4.08 A.
1020.35

HAWLEY

2053.87

J.P.H.S.
S.S.

-010
126.00 A.

(S)

APR 30 1975

B423

APPROVED
LORAIN CO.
MAP DEPT.
DATE 11-21-74
PAGE 21 C
BY L.V. Hall
VOID AFTER

-011
10.00 A.

961.75

438.94

336.06

T

RD.

162

TRACTS 6, 7 & WLY. PT. 12
TRACT 17 LOTS 3, 4 & 5