

8440
8441

98.47

ST RIVER 80 98.47

333
-002
0.74 A.

333

-015
1.05 AC

399.94

-017 91 AC

399.96

-013 73 AC

402

-010
6.56 A.

APPROVED LORAIN CO. MAP DEPT.	
DATE	11-29-74
PAGE	6-11
BY	LW Hall
VOID AFTER	

APPROVED LORAIN CO. MAP DEPT.	
DATE	11-29-74
PAGE	6-11
BY	LW Hall
VOID AFTER	

8440

-001
3.18 A

536.54

~~-003~~
~~2.44 A~~

~~-004~~
~~3.18 A~~

~~-005~~
~~3.27 A~~

-006
3.27 A

-007
3.10 A

~~-008~~
~~2.40 A~~

1280.30

-012 1.67 AC

880.46

10

8441

-014
4.57 AC


1033.87

-016
2.36 AC

1059.03

DEC 1 1975

DEC 11 1974

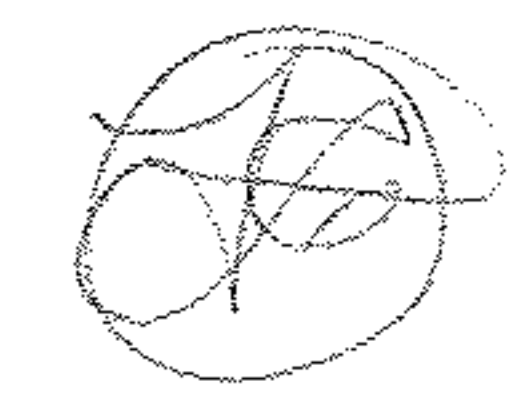

Deed To Metro. Park
Does Not Agree With Deeds
To Adjoining Properties.
See Deed Vol. 927 P. 998

Pt. 06-22-009-101-005
Pt. 45.54 A.

500