


8442

JAN 20 1975



DEC 1 1975

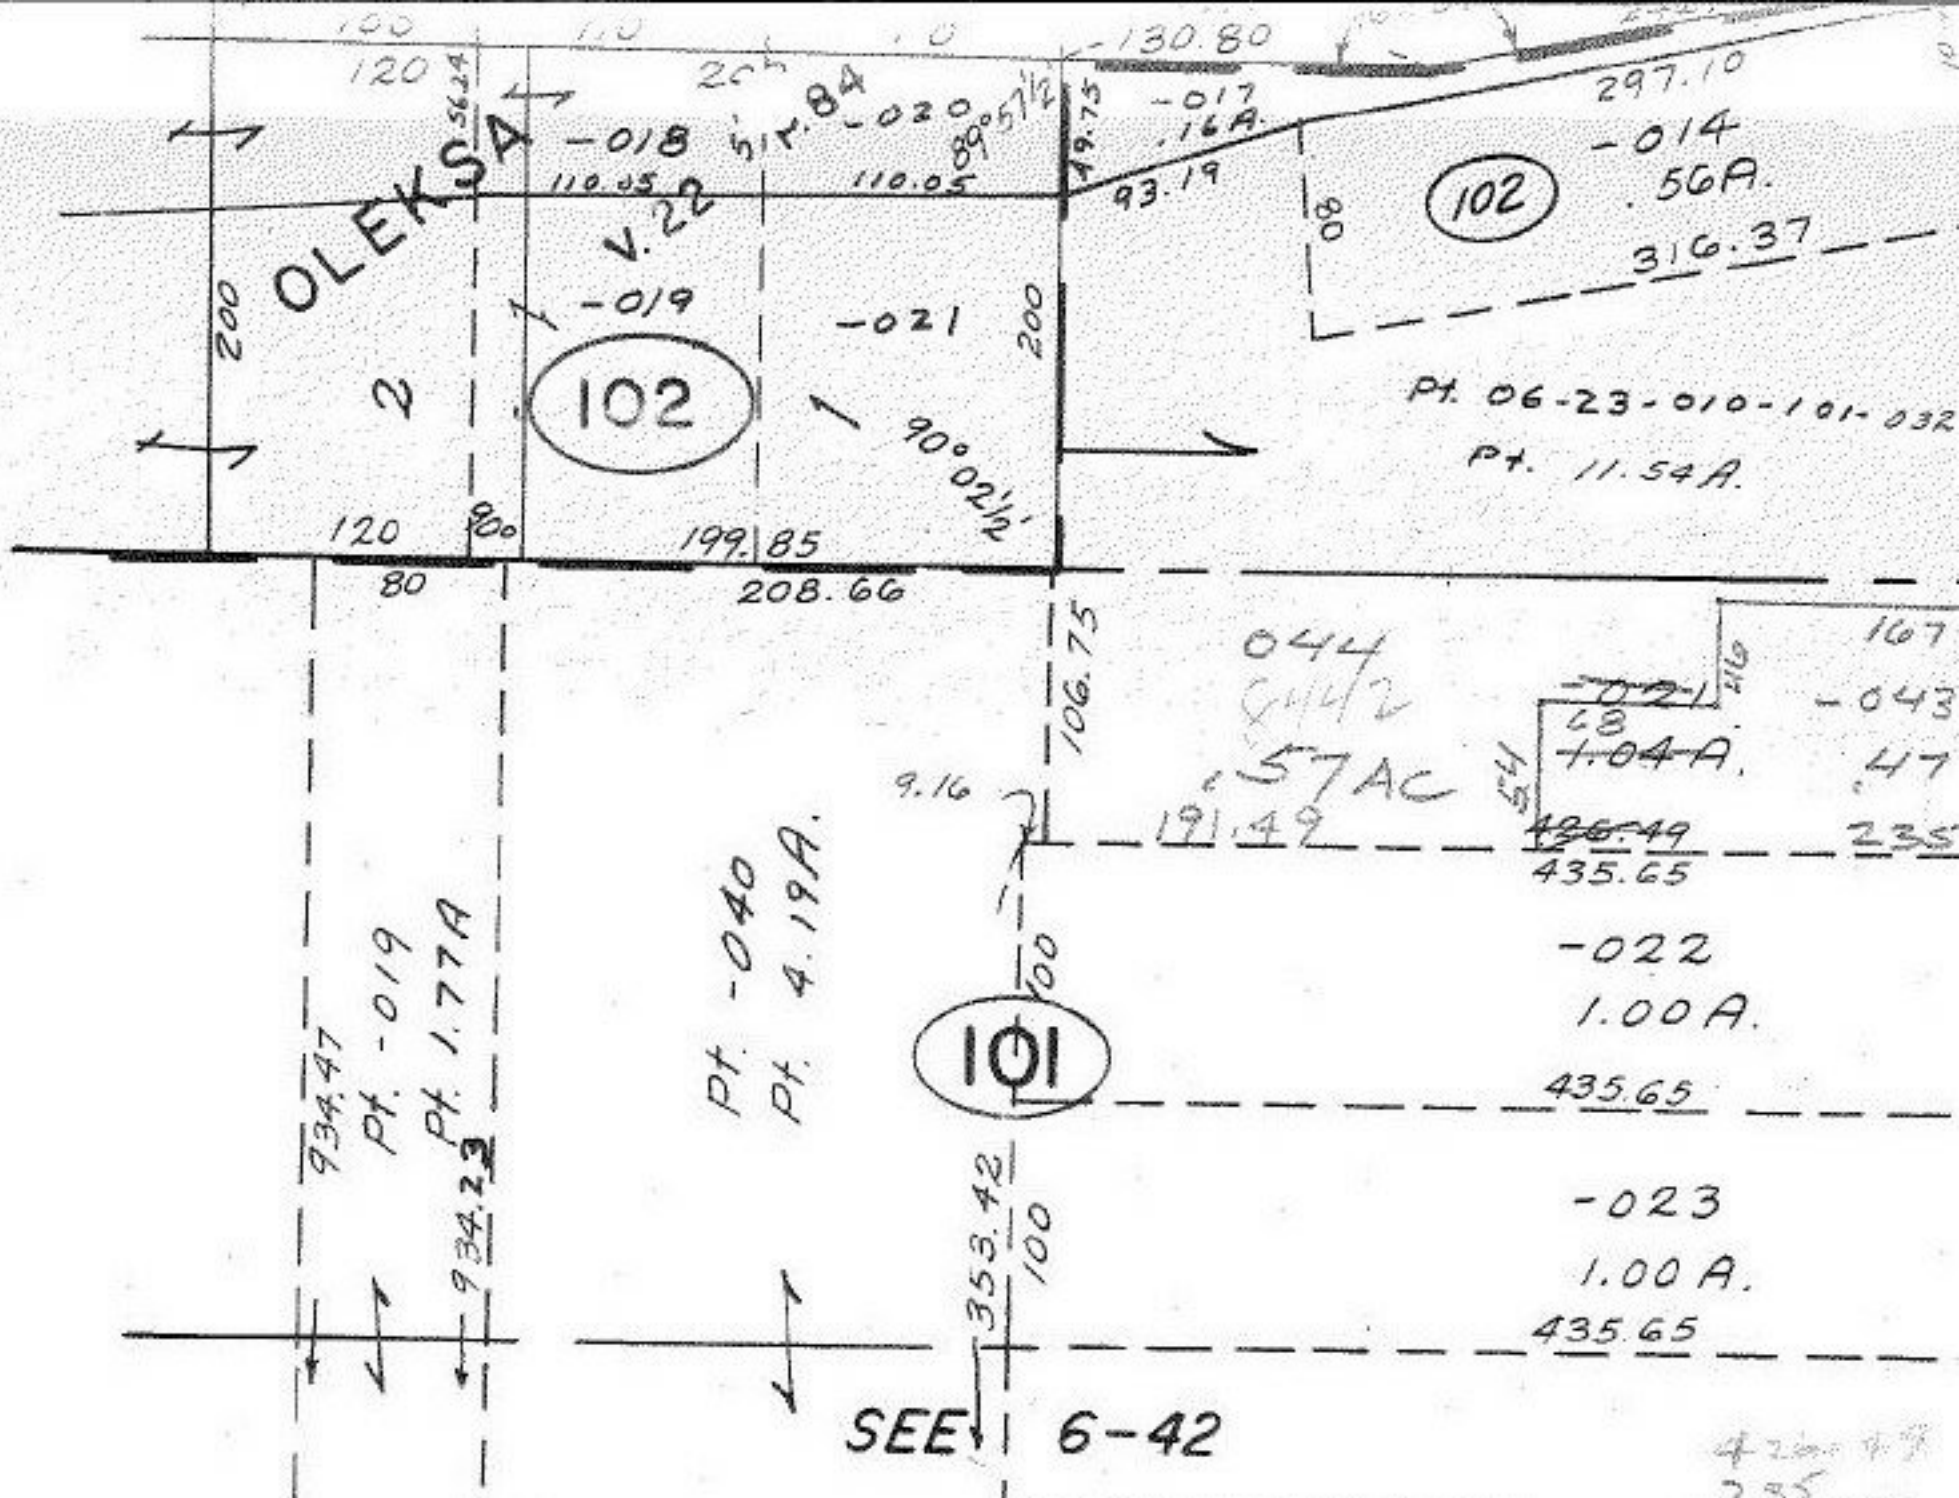

APPROVED
LORAIN CO.
MAP DEPT.
DATE 11-22-74
PAGE 6-25
BY L.H. Hall
VOID AFTER

# ELYRIA TWR.

SCALE: 1" = 100'