

- 002
20.00 A.

- 001
78.50 A.

8449


APPROVED
LORAIN CO.
MAP DEPT.
DATE 12-4-74
PAGE 12 E
BY LW Hall
VOID
AFTER

(1/2) (2/2) (3/2)

MAY 21 1975

89

92

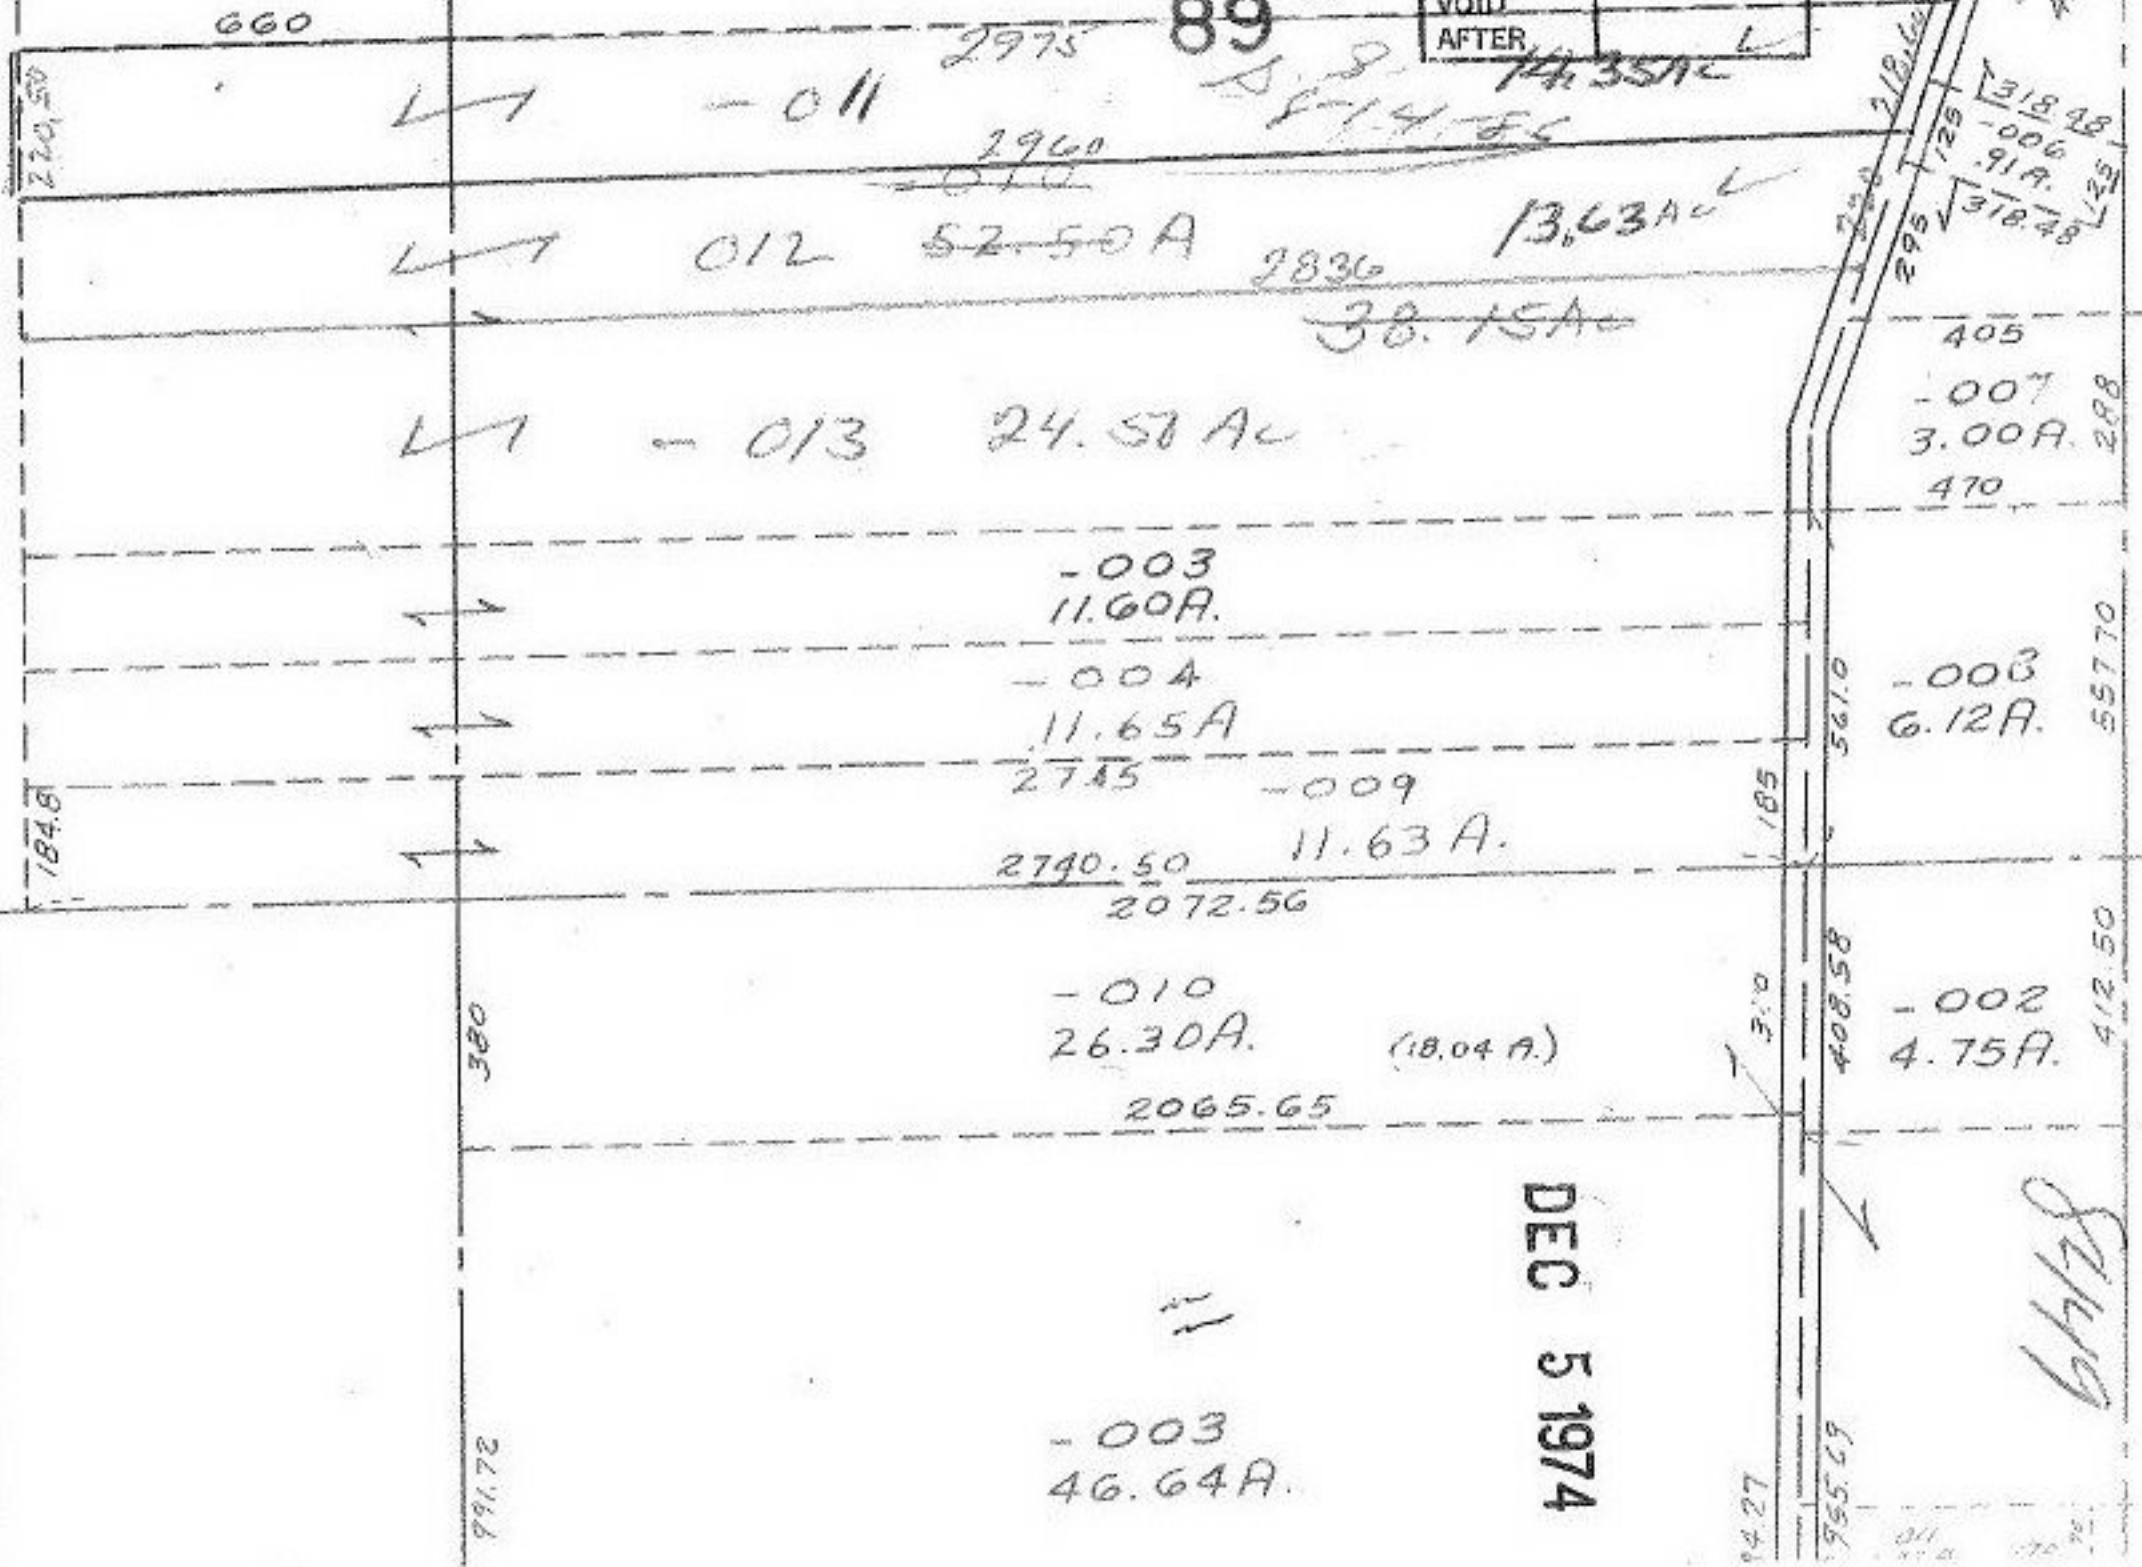

DEC 5 1974

6/1/78

10A.

150

380

241.78

94.27

955.59

185

408.58

561.0

295

218.66

288

557.0

412.50

106

318.48

405

470

6.12 A.

4.75 A.

318.48

91 A.

318.48

218.66

218.66