


8451

DEC 9 1974

OBERLIN - NORTH

58

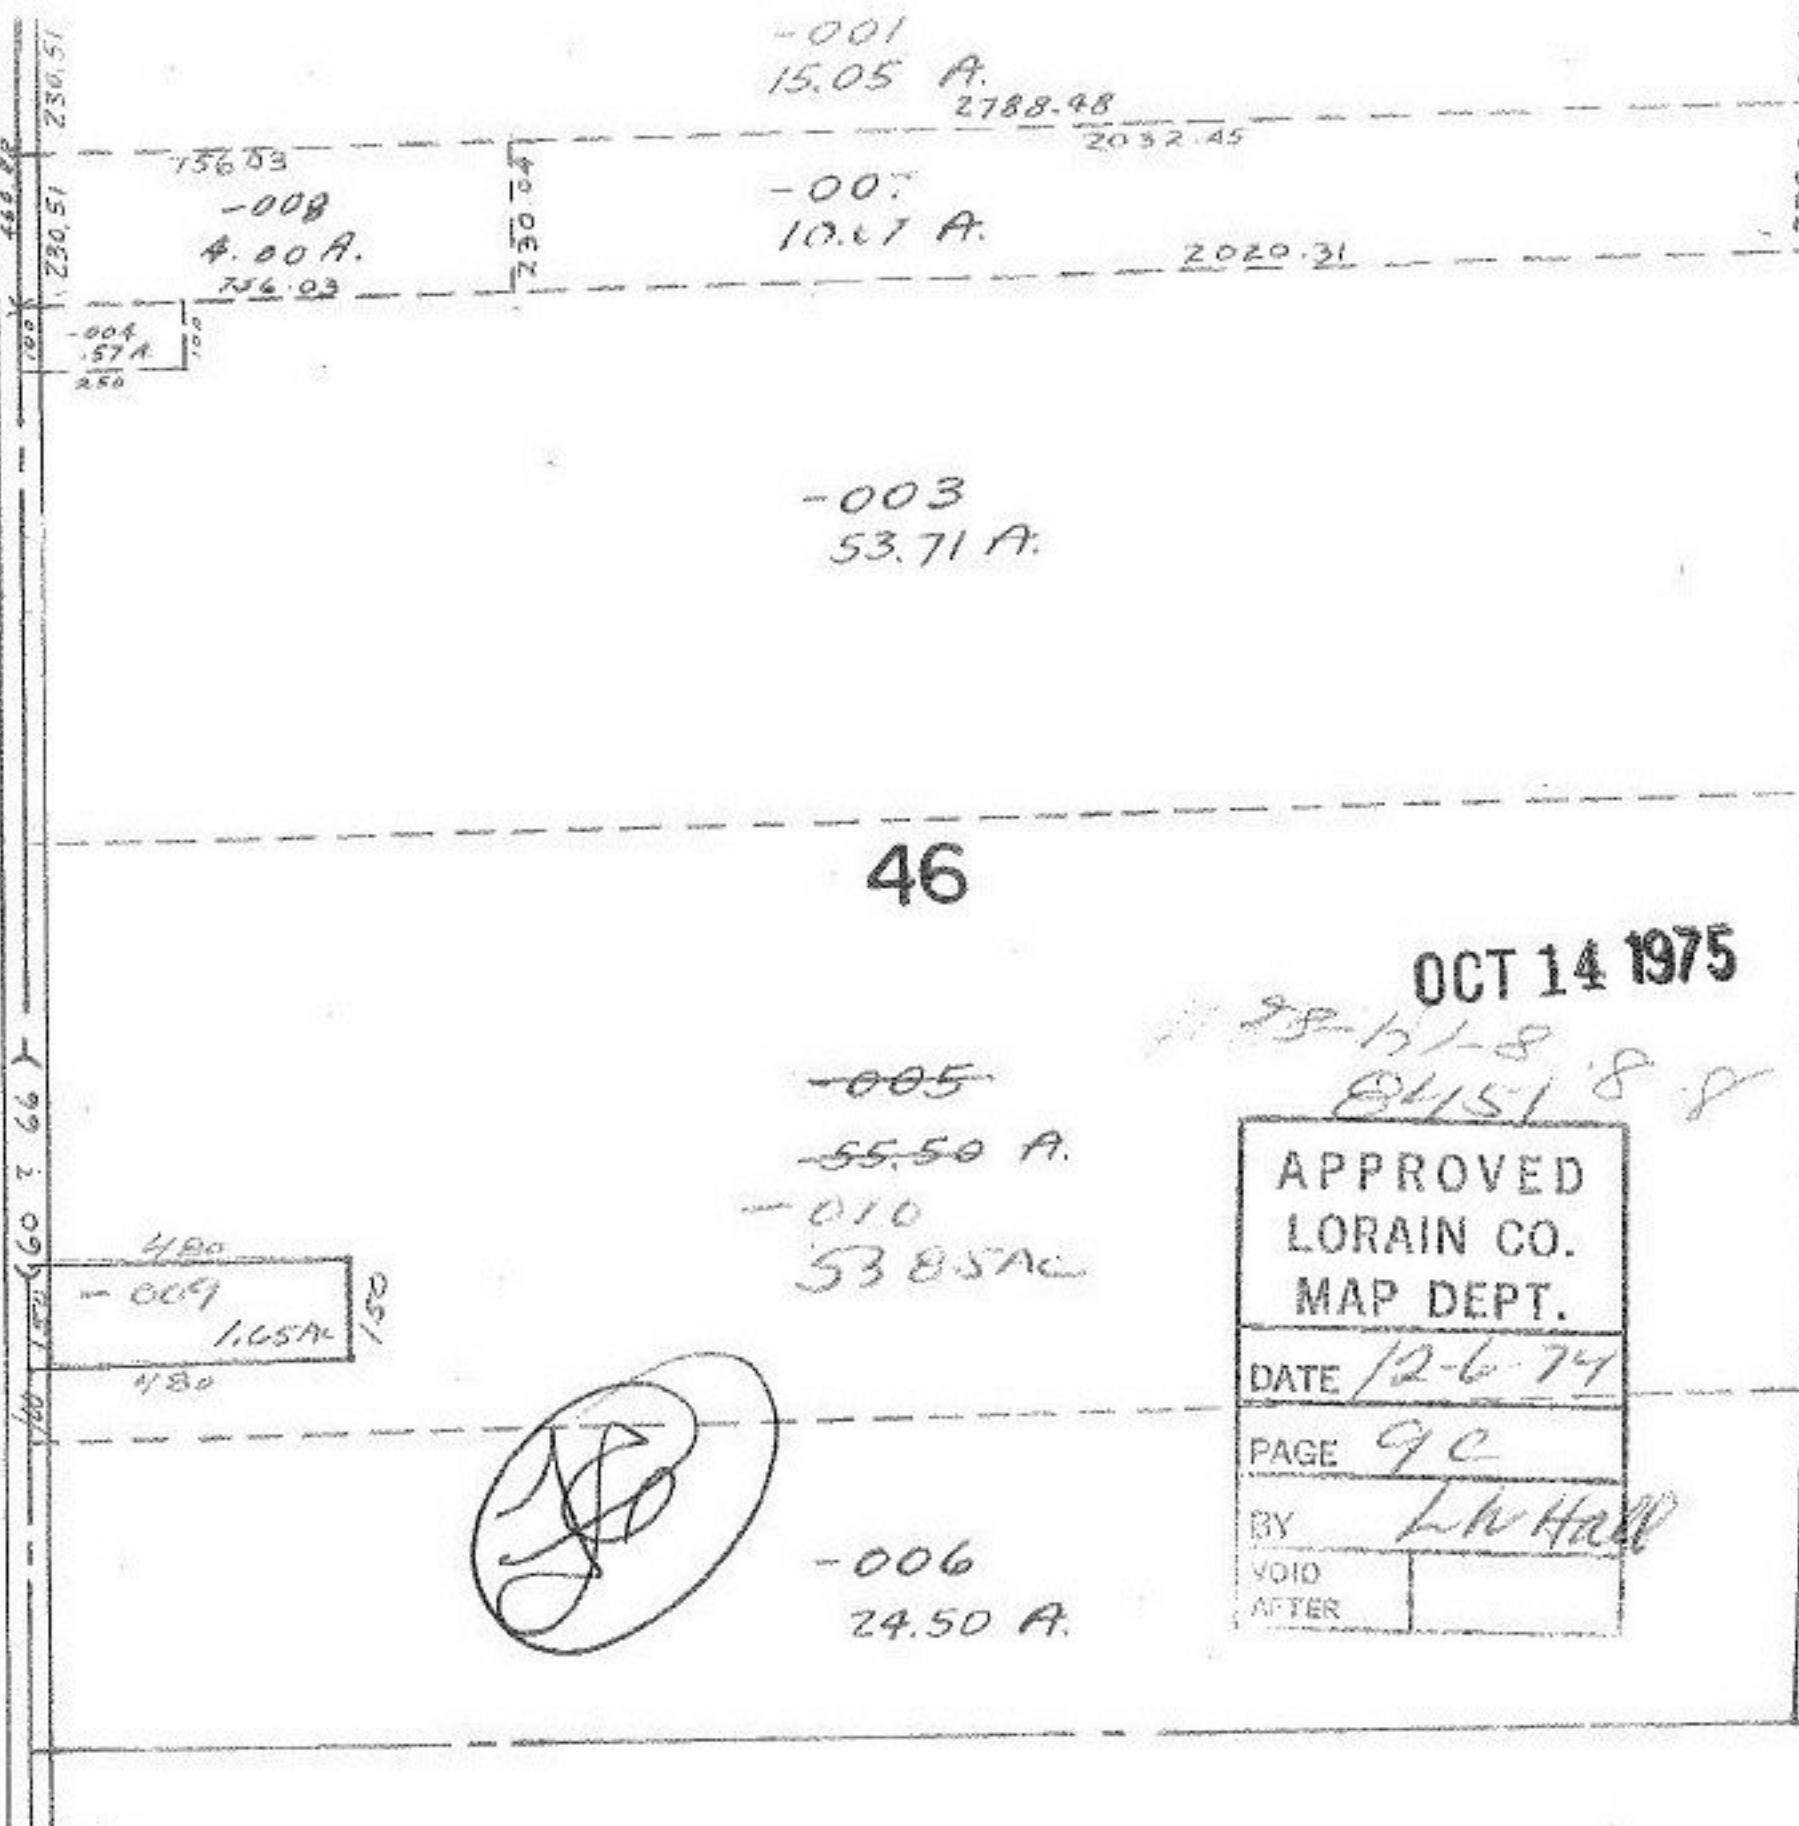

OCT 14 1975

8451-8

8451-8-8

APPROVED LORAIN CO. MAP DEPT.	
DATE	12-6-74
PAGE	90
BY	L. W. Hall
VOID AFTER	

RUSSIA TWP.

SCALE: 1" = 400'

LOTS 6, 7,