


DEC 10 1974

8452

DEC 31 1975

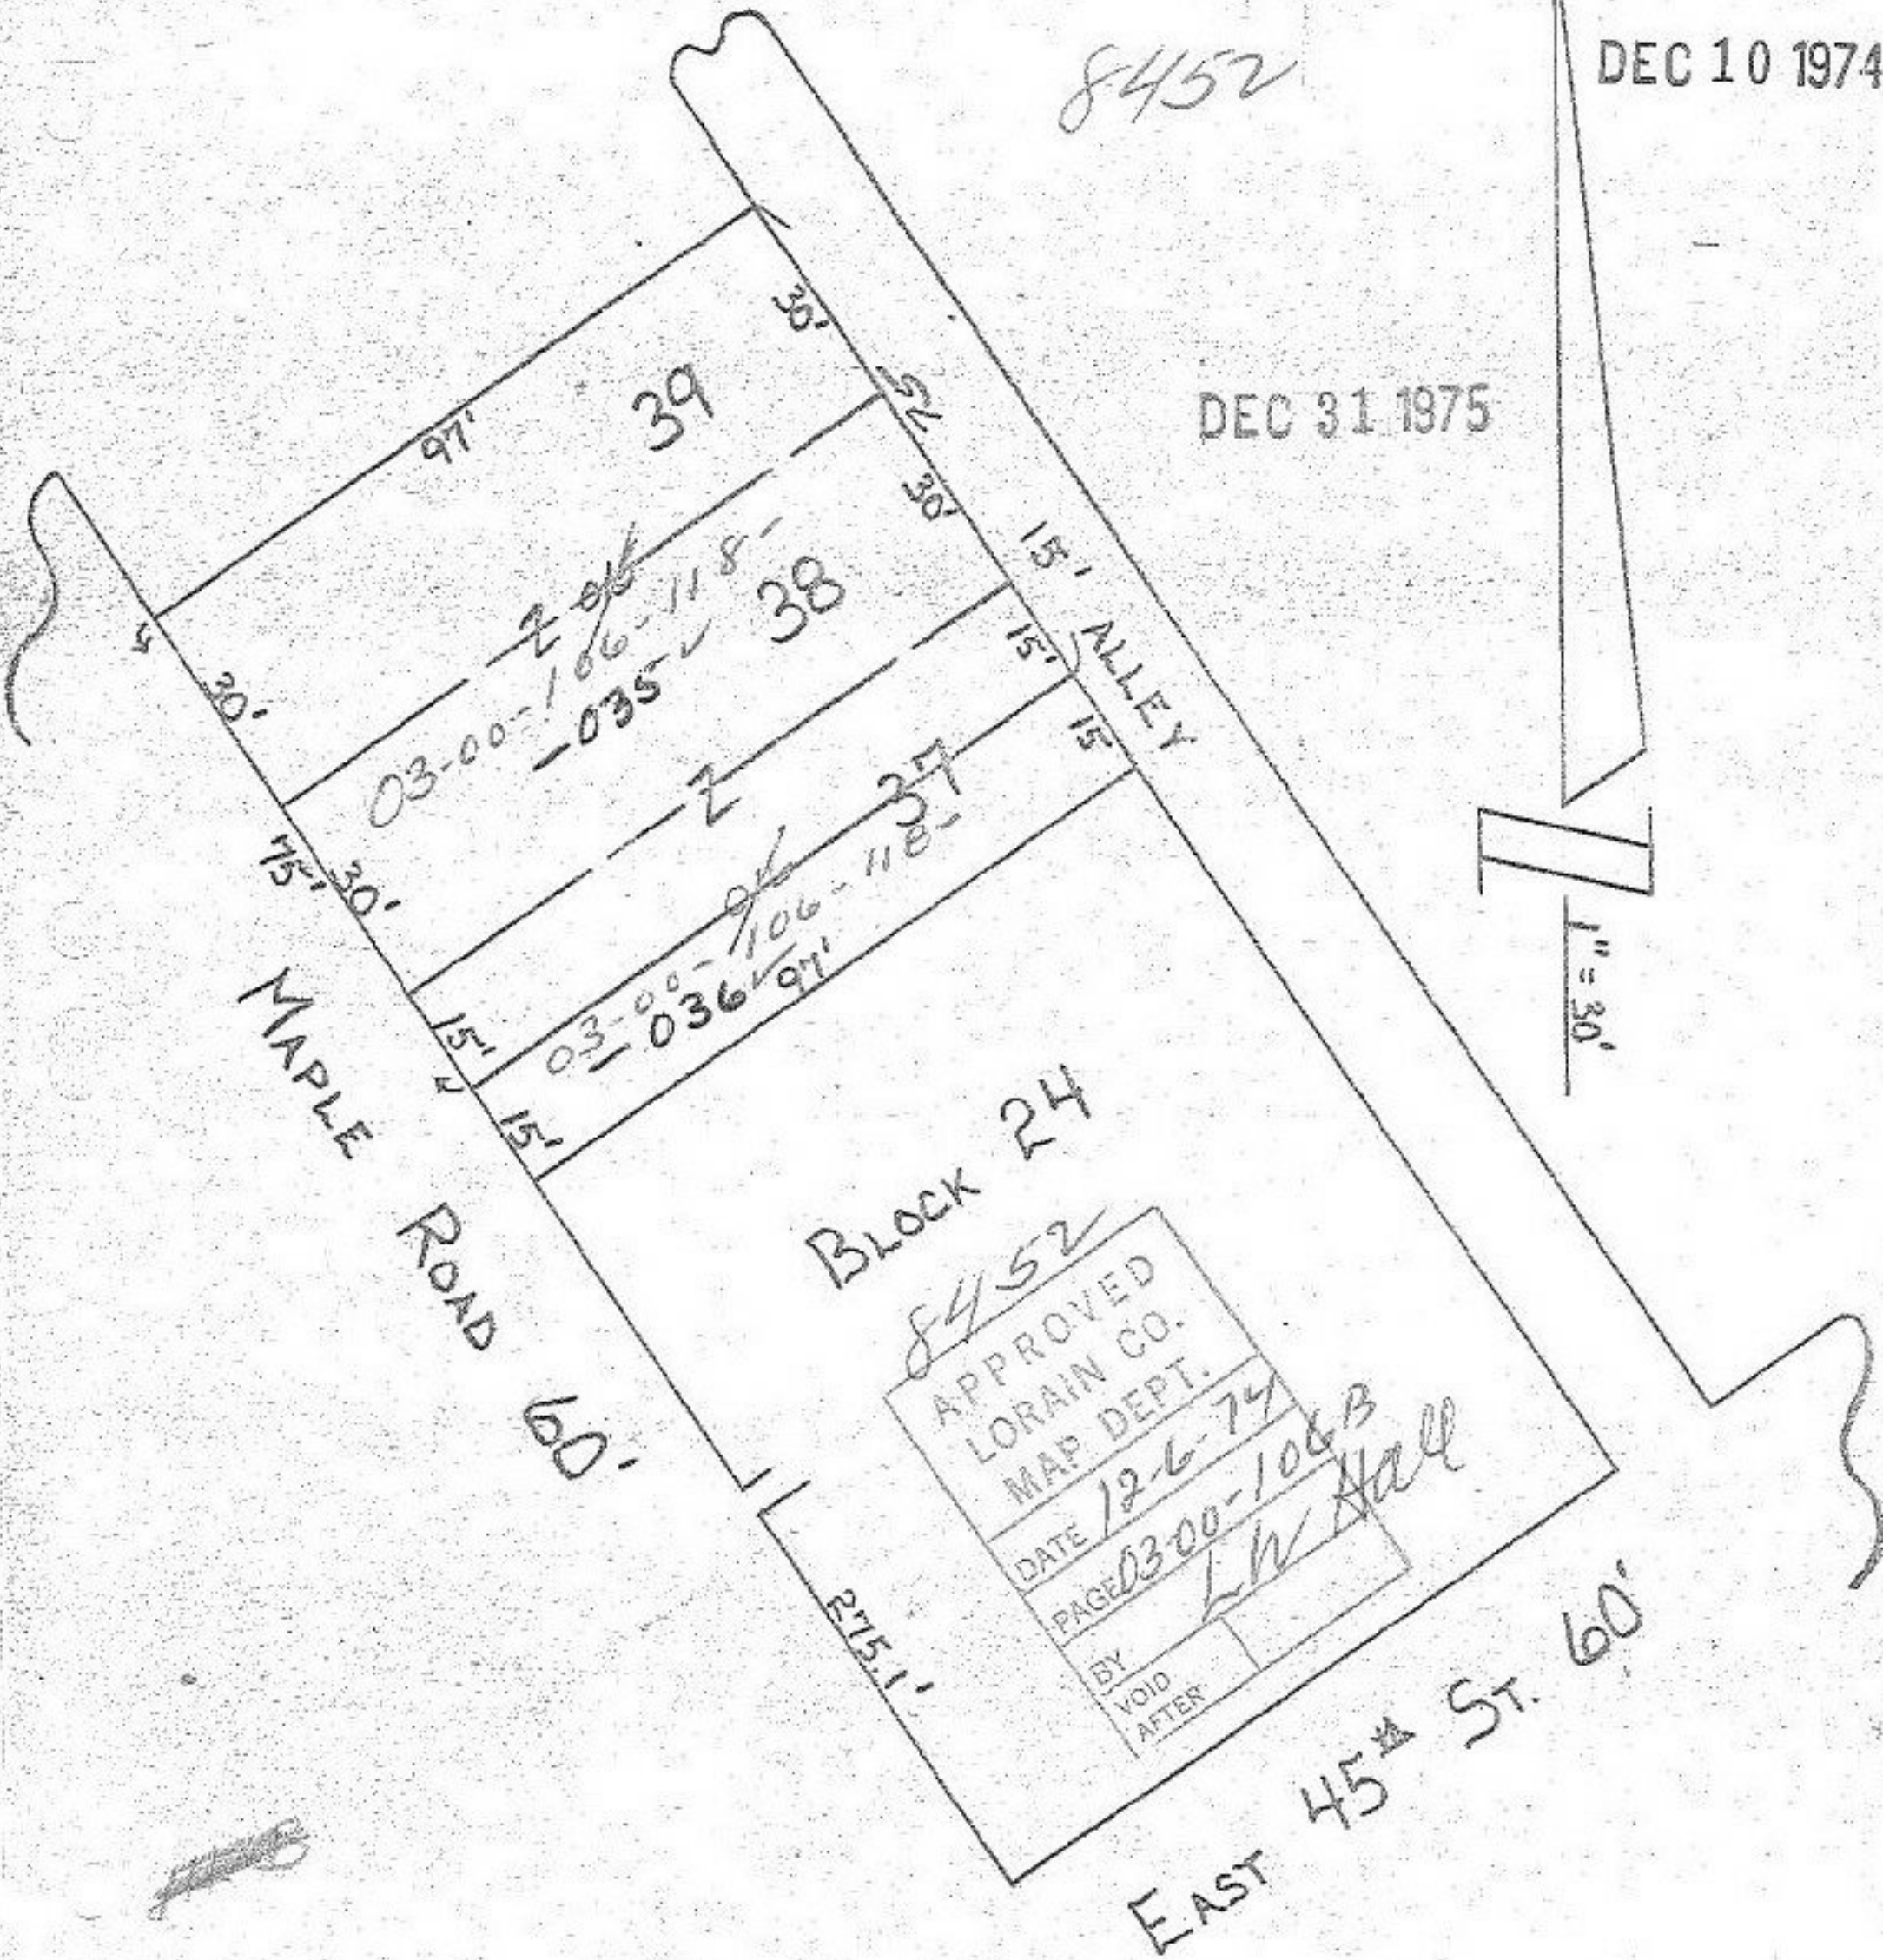

Block 24

8452
 APPROVED
 LORAIN CO.
 MAP DEPT.
 DATE 12-6-74
 PAGED 03-00-106B
 BY L.W. Hall
 VOID AFTER

APPROVED BY THE LORAIN CITY PLANNING COMMISSION..... NO PLAT REQUIRED

Tom Rodgers
SECRETARY LORAIN CITY PLANNING COMMISSION