


8469

DEC 20 1974

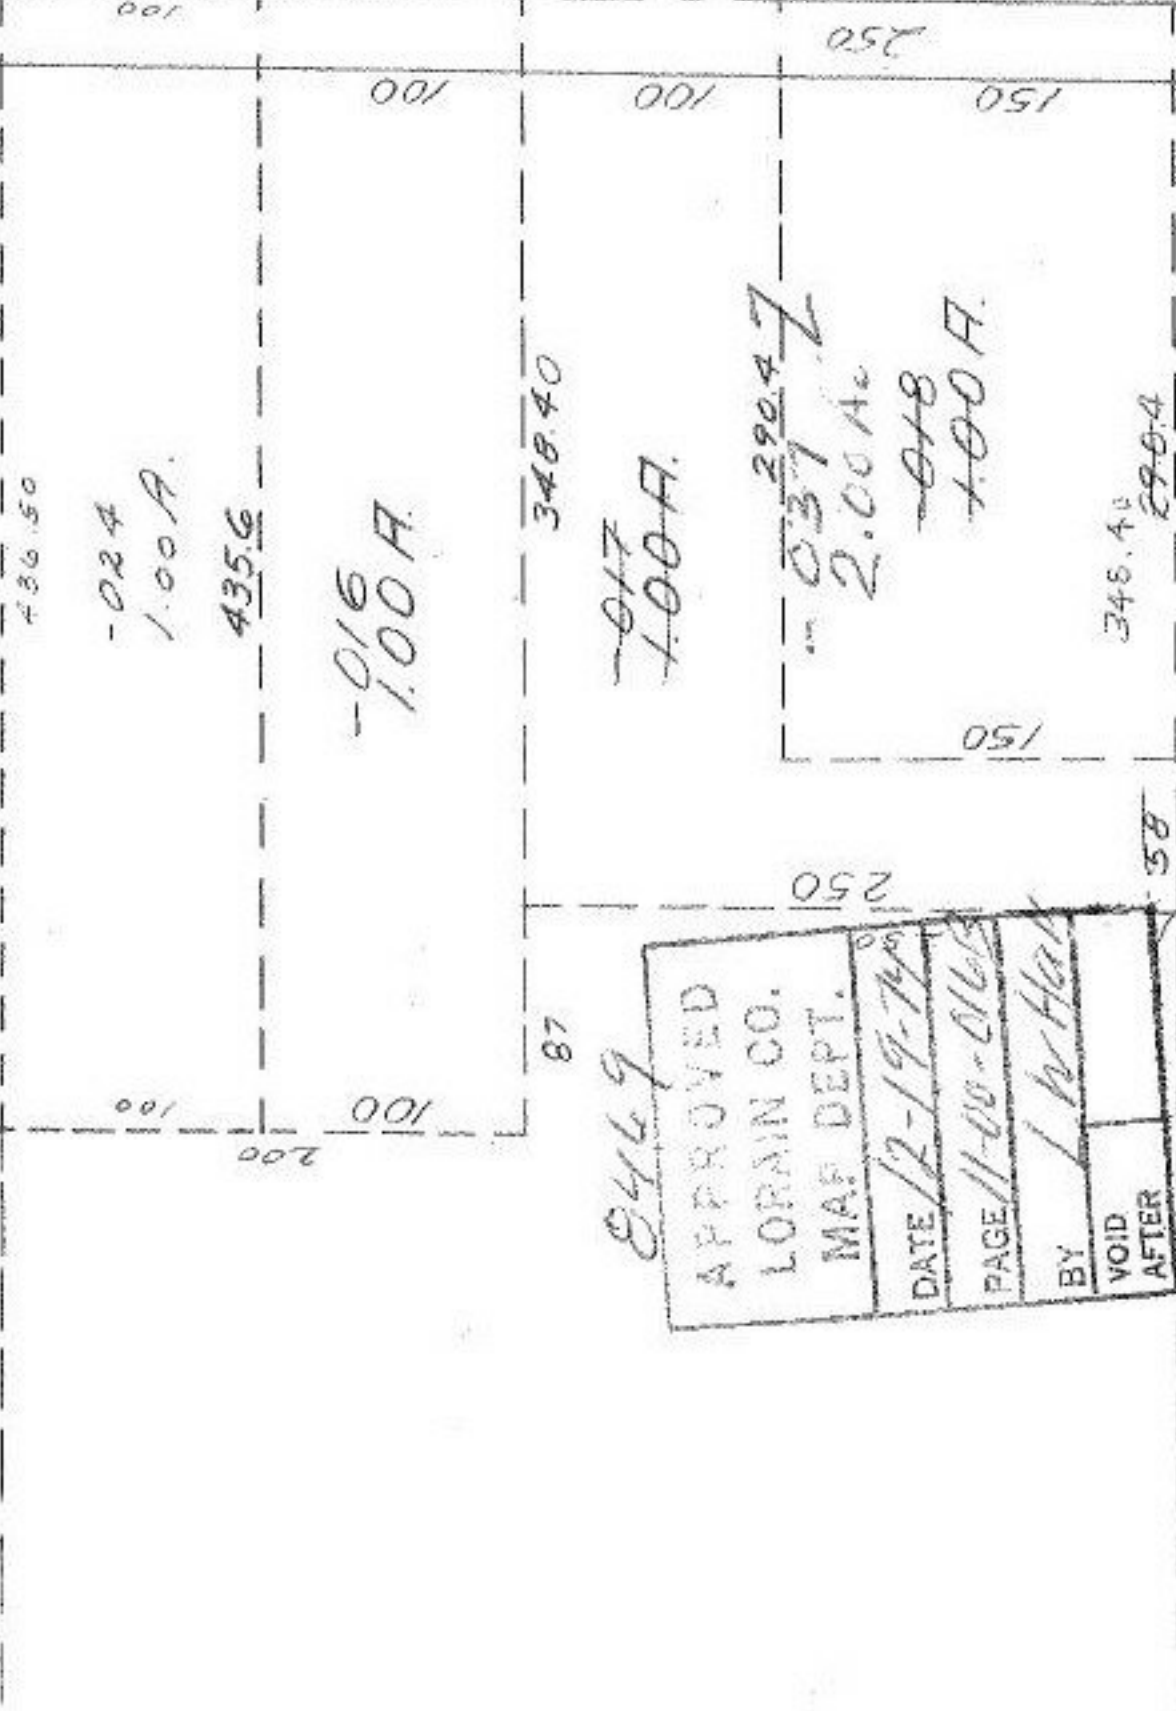

8469

APPROVED
LORAIN CO.
MAP DEPT.
DATE 12-19-74
PAGE 11-00-0163
BY L W HAY
VOID AFTER

JAN 20 1975

$$\begin{array}{r} 290.4 \\ 5.8 \\ \hline 348.4 \end{array}$$


-019 5.00 A.

1063

11-00-016 - 000 - 034

SEE 1