

DEC 31 1974

MIDDLE RIDGE RD.


SEE 5-00-095-C

8481

83/60

RD. 60

83/90

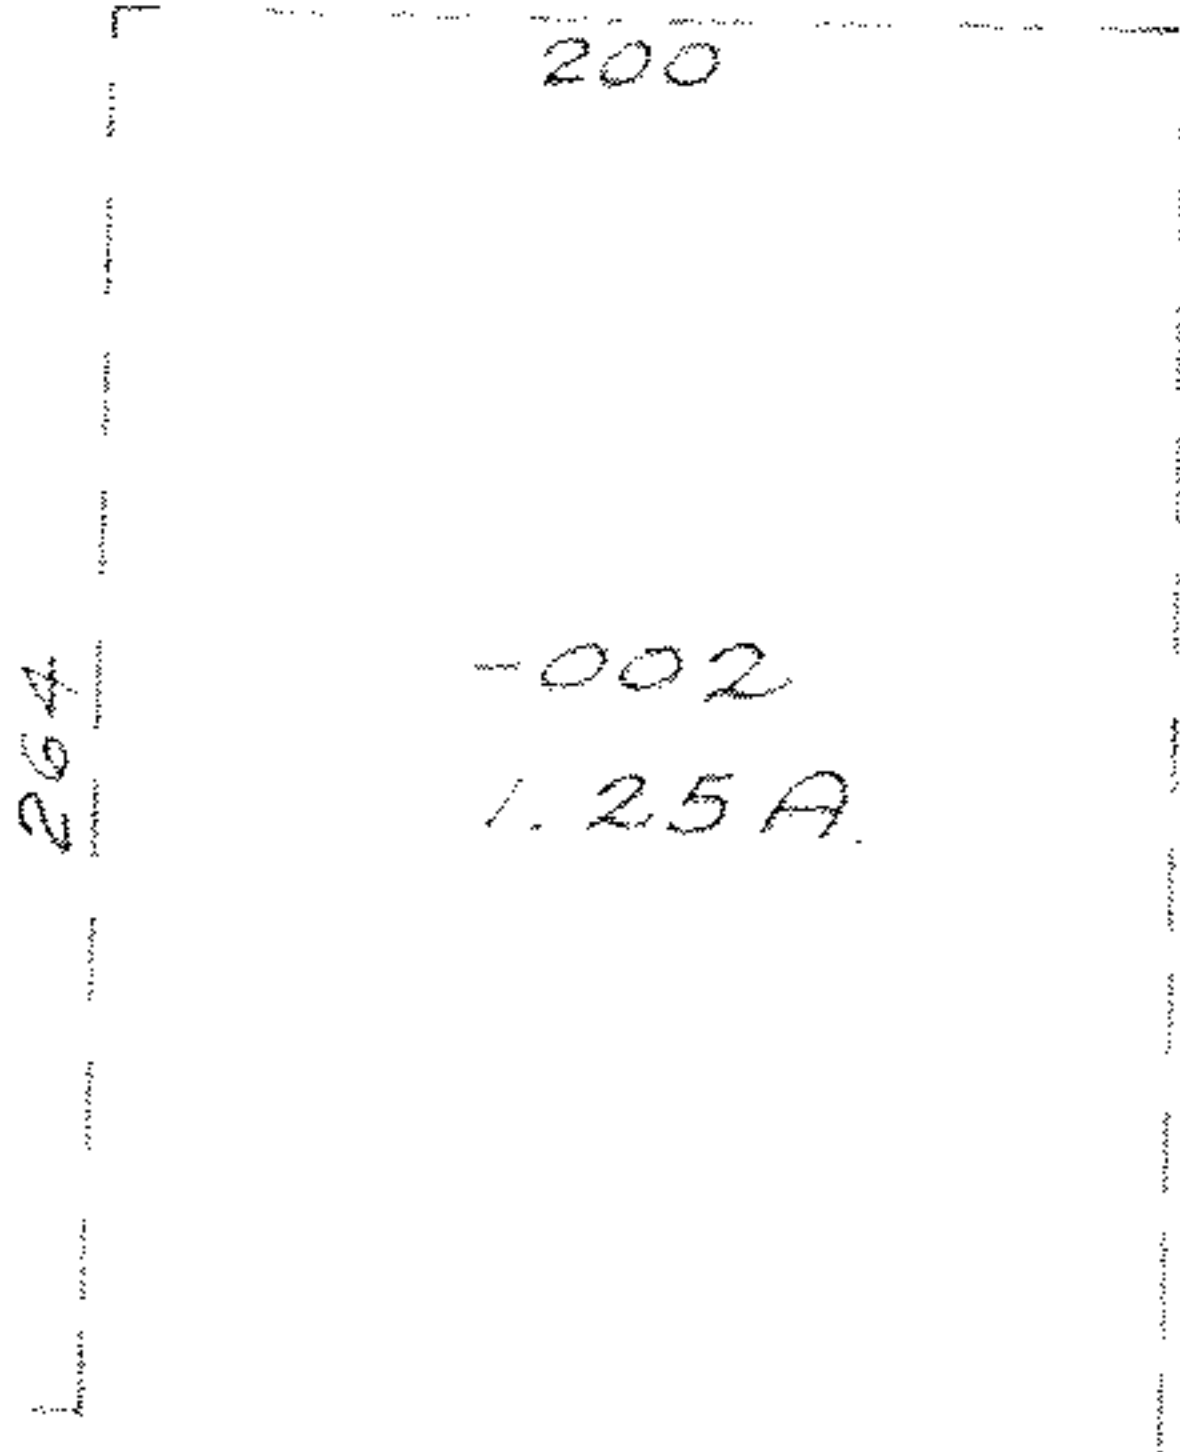

105

- 012
11.43 AC

OHIO

-003
9.18 A.

TURNPIKE

8481

+ 35

1198.77

DEC 31 1975

[Signature]

- 011
~~001~~
~~20.74 A.~~
9.31 AC

8481

APPROVED
LORAIN CO.
MAP DEPT.
DATE 12-30-74
PAGE 5-00-094-C
BY L W Hall
VOID AFTER
7-7-78-1-8

105

1195.3
913.44

SEE 5-00-094-B

445.75

89°17'