

2.00A 10

330

849.75

-003
49.50A

-005
40.00A.

JAN 6 1975

-001
50.00A.

MAY 15 1975


LATTASBURG - ELYRIA

-002
50.00A.

95

84990

APPROVED
LDRAIN CO.
MAP DEPT.
DATE 1-3-75
PAGE 156
BY L.W. Hall
YOUR AFTER

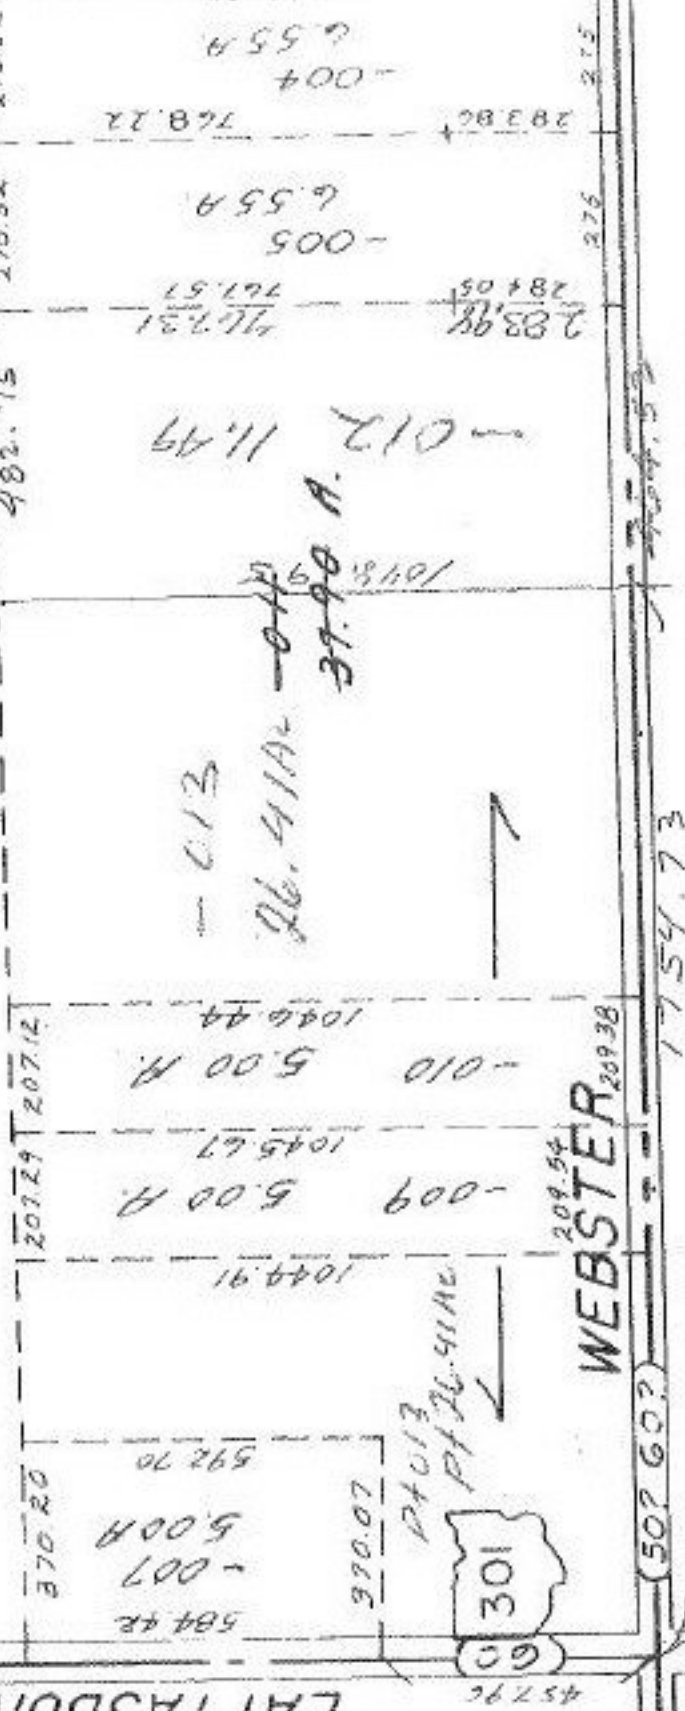

LAGRANGE TWP.

SCALE: 1" = 400'

003

4497