


8527

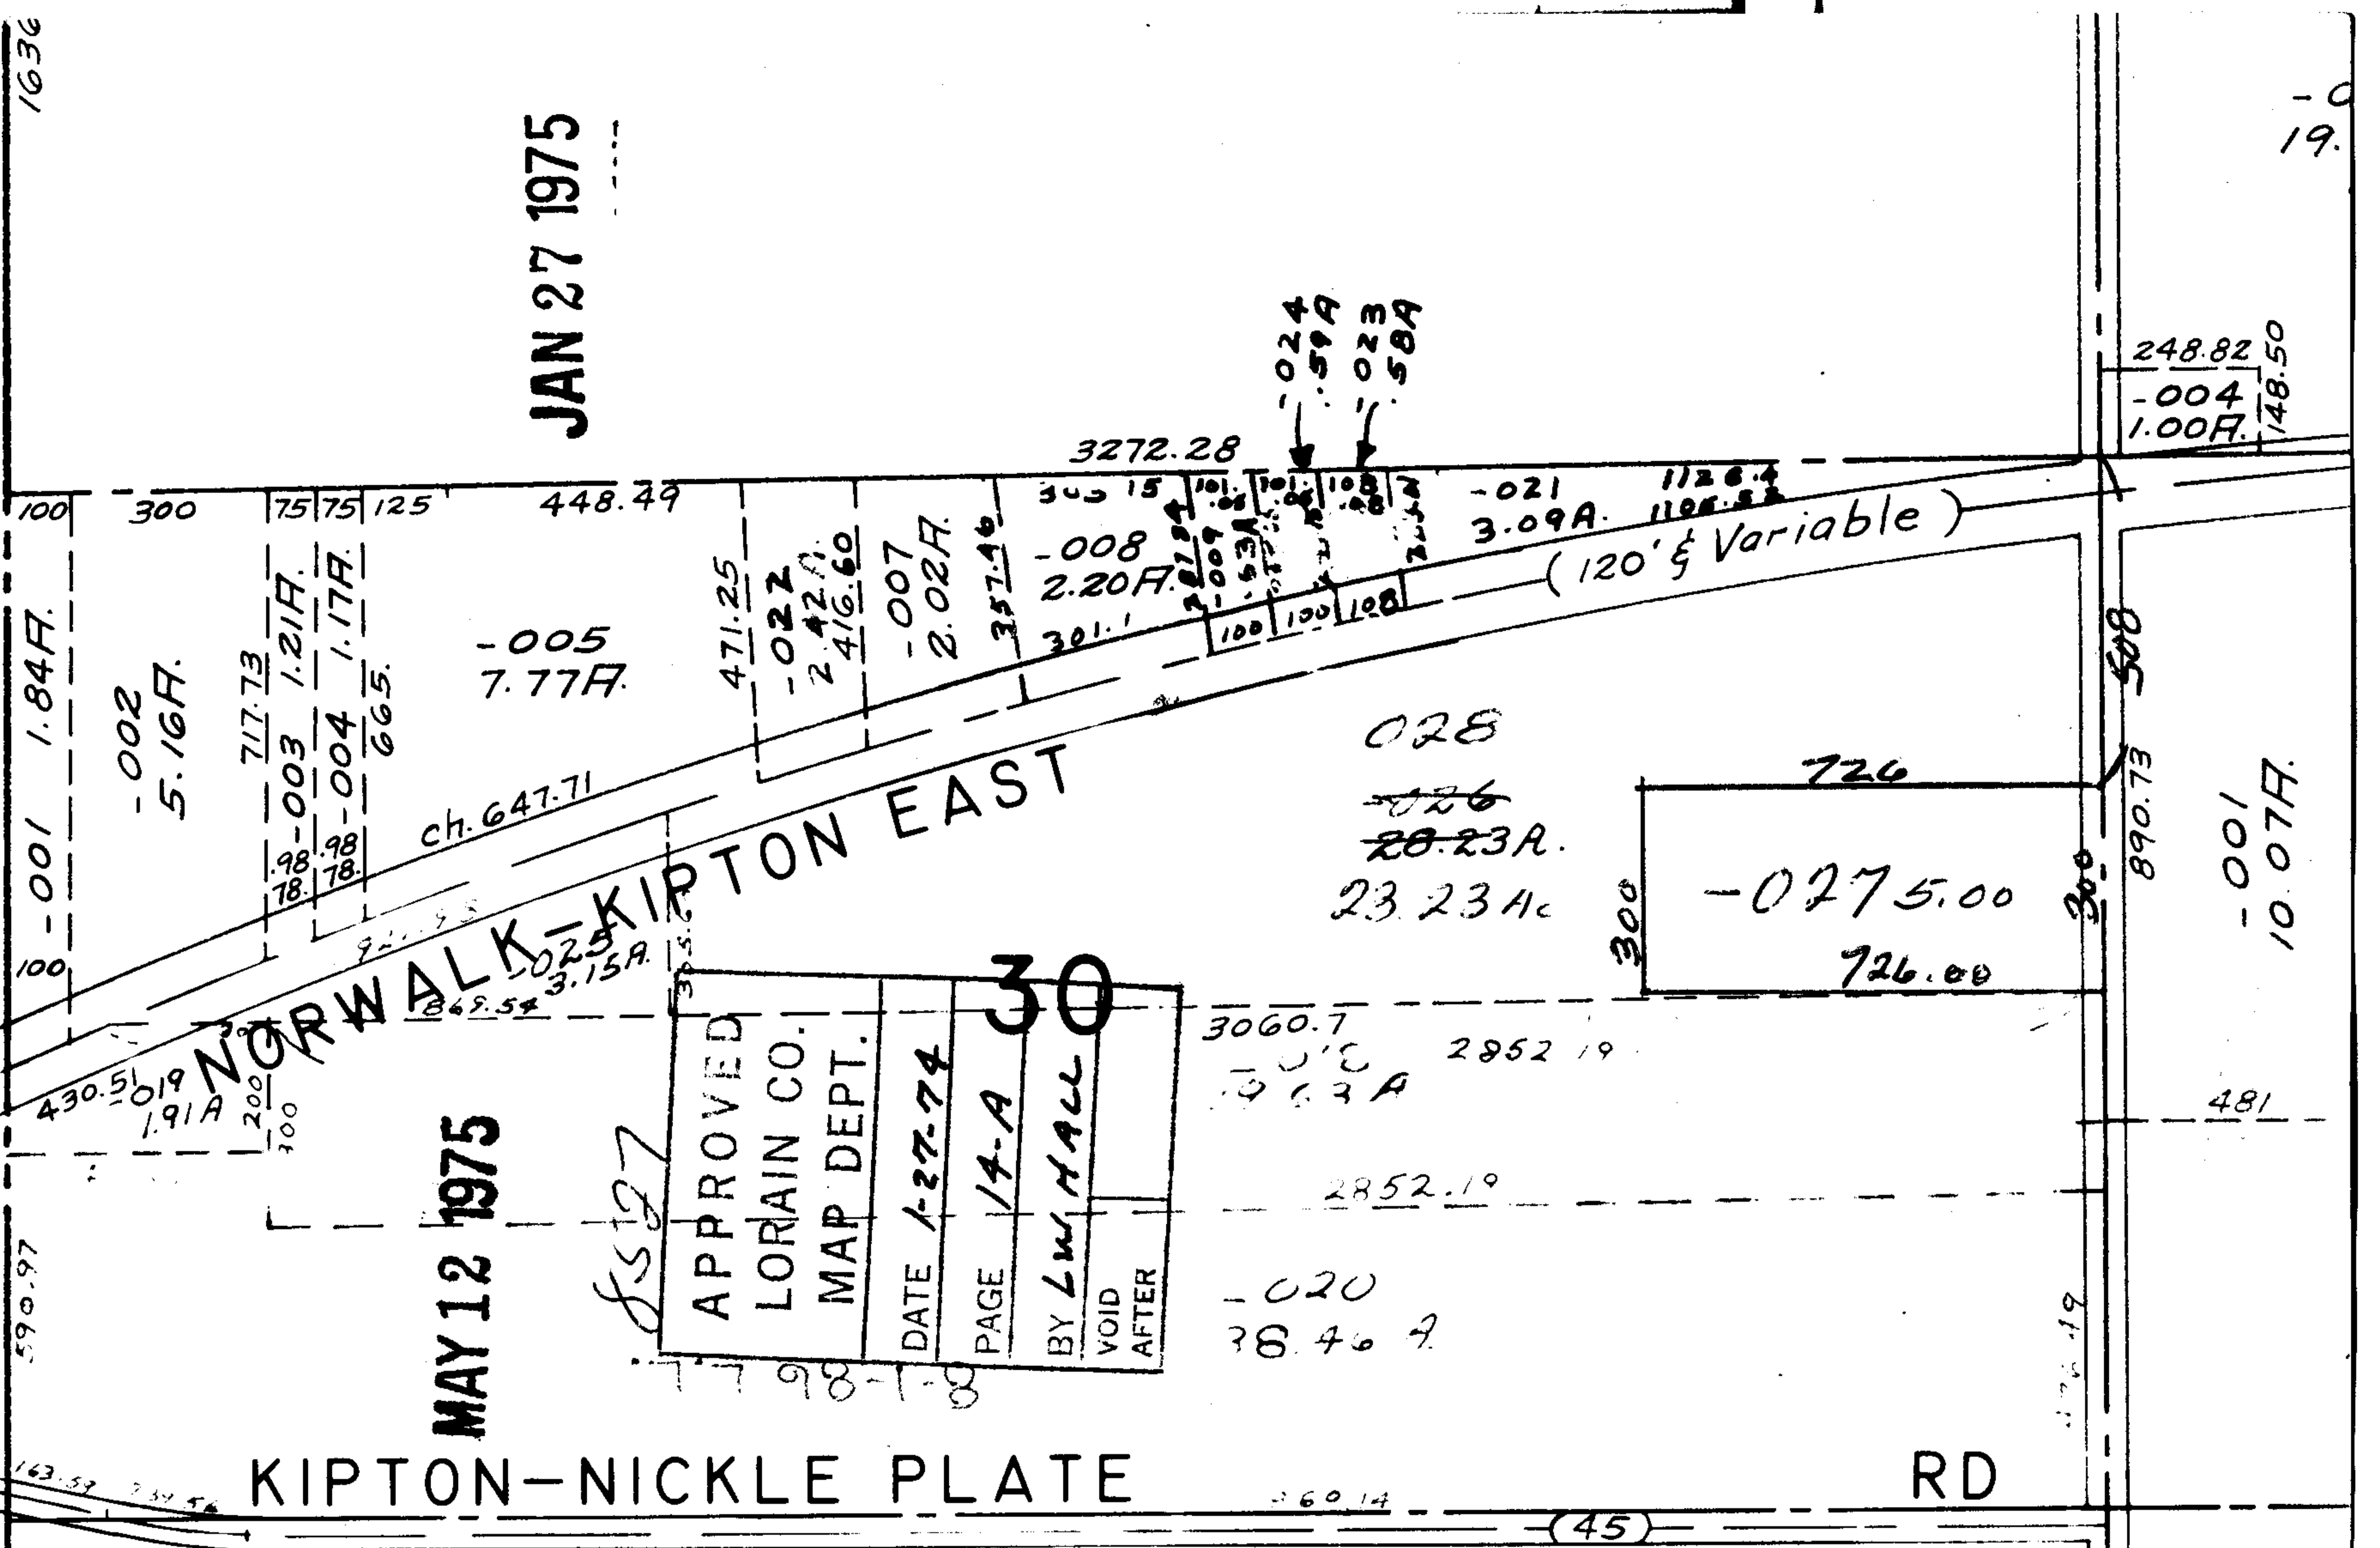

JAN 27 1975

MAY 12 1975

APPROVED
LORAIN CO.
MAP DEPT.
DATE 1-27-74
PAGE 14-A
BY LW HALL
VOID AFTER