


8546

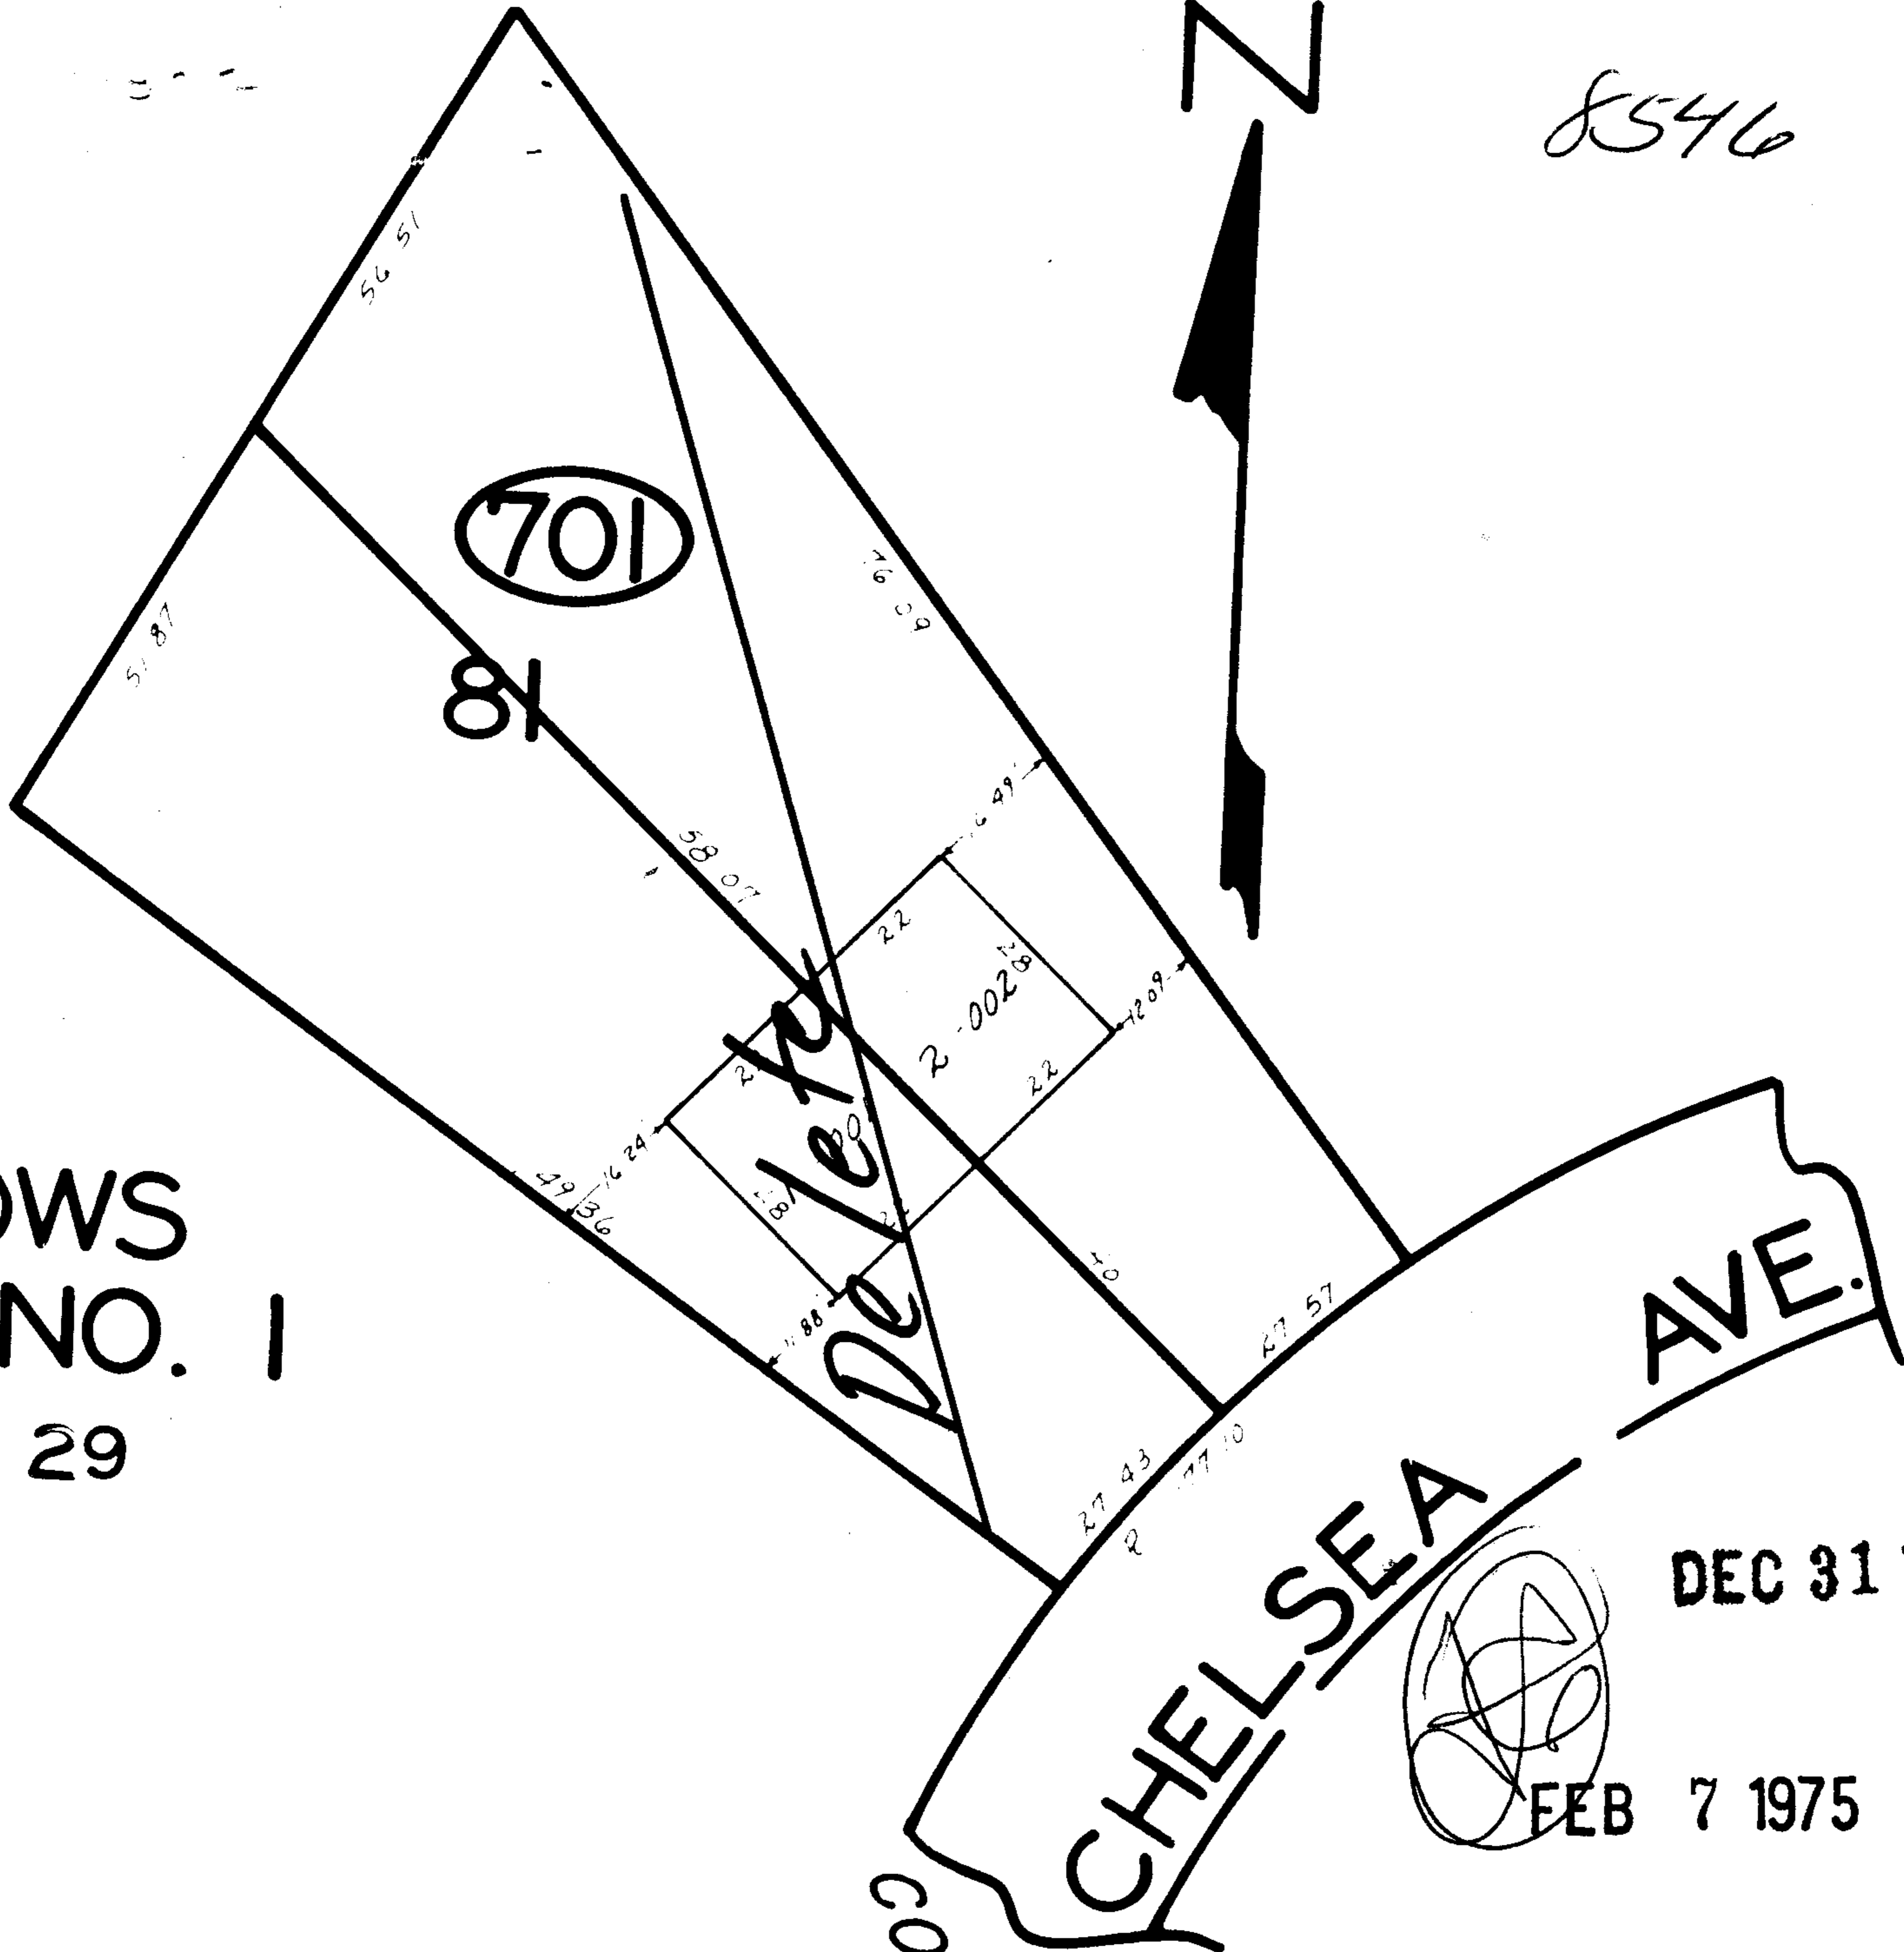

DOWNS  
NO. 1  
G. 29  
30'

DEC 31 1975

FEB 7 1975

