


FEB 11 1975

8548



2-13-75

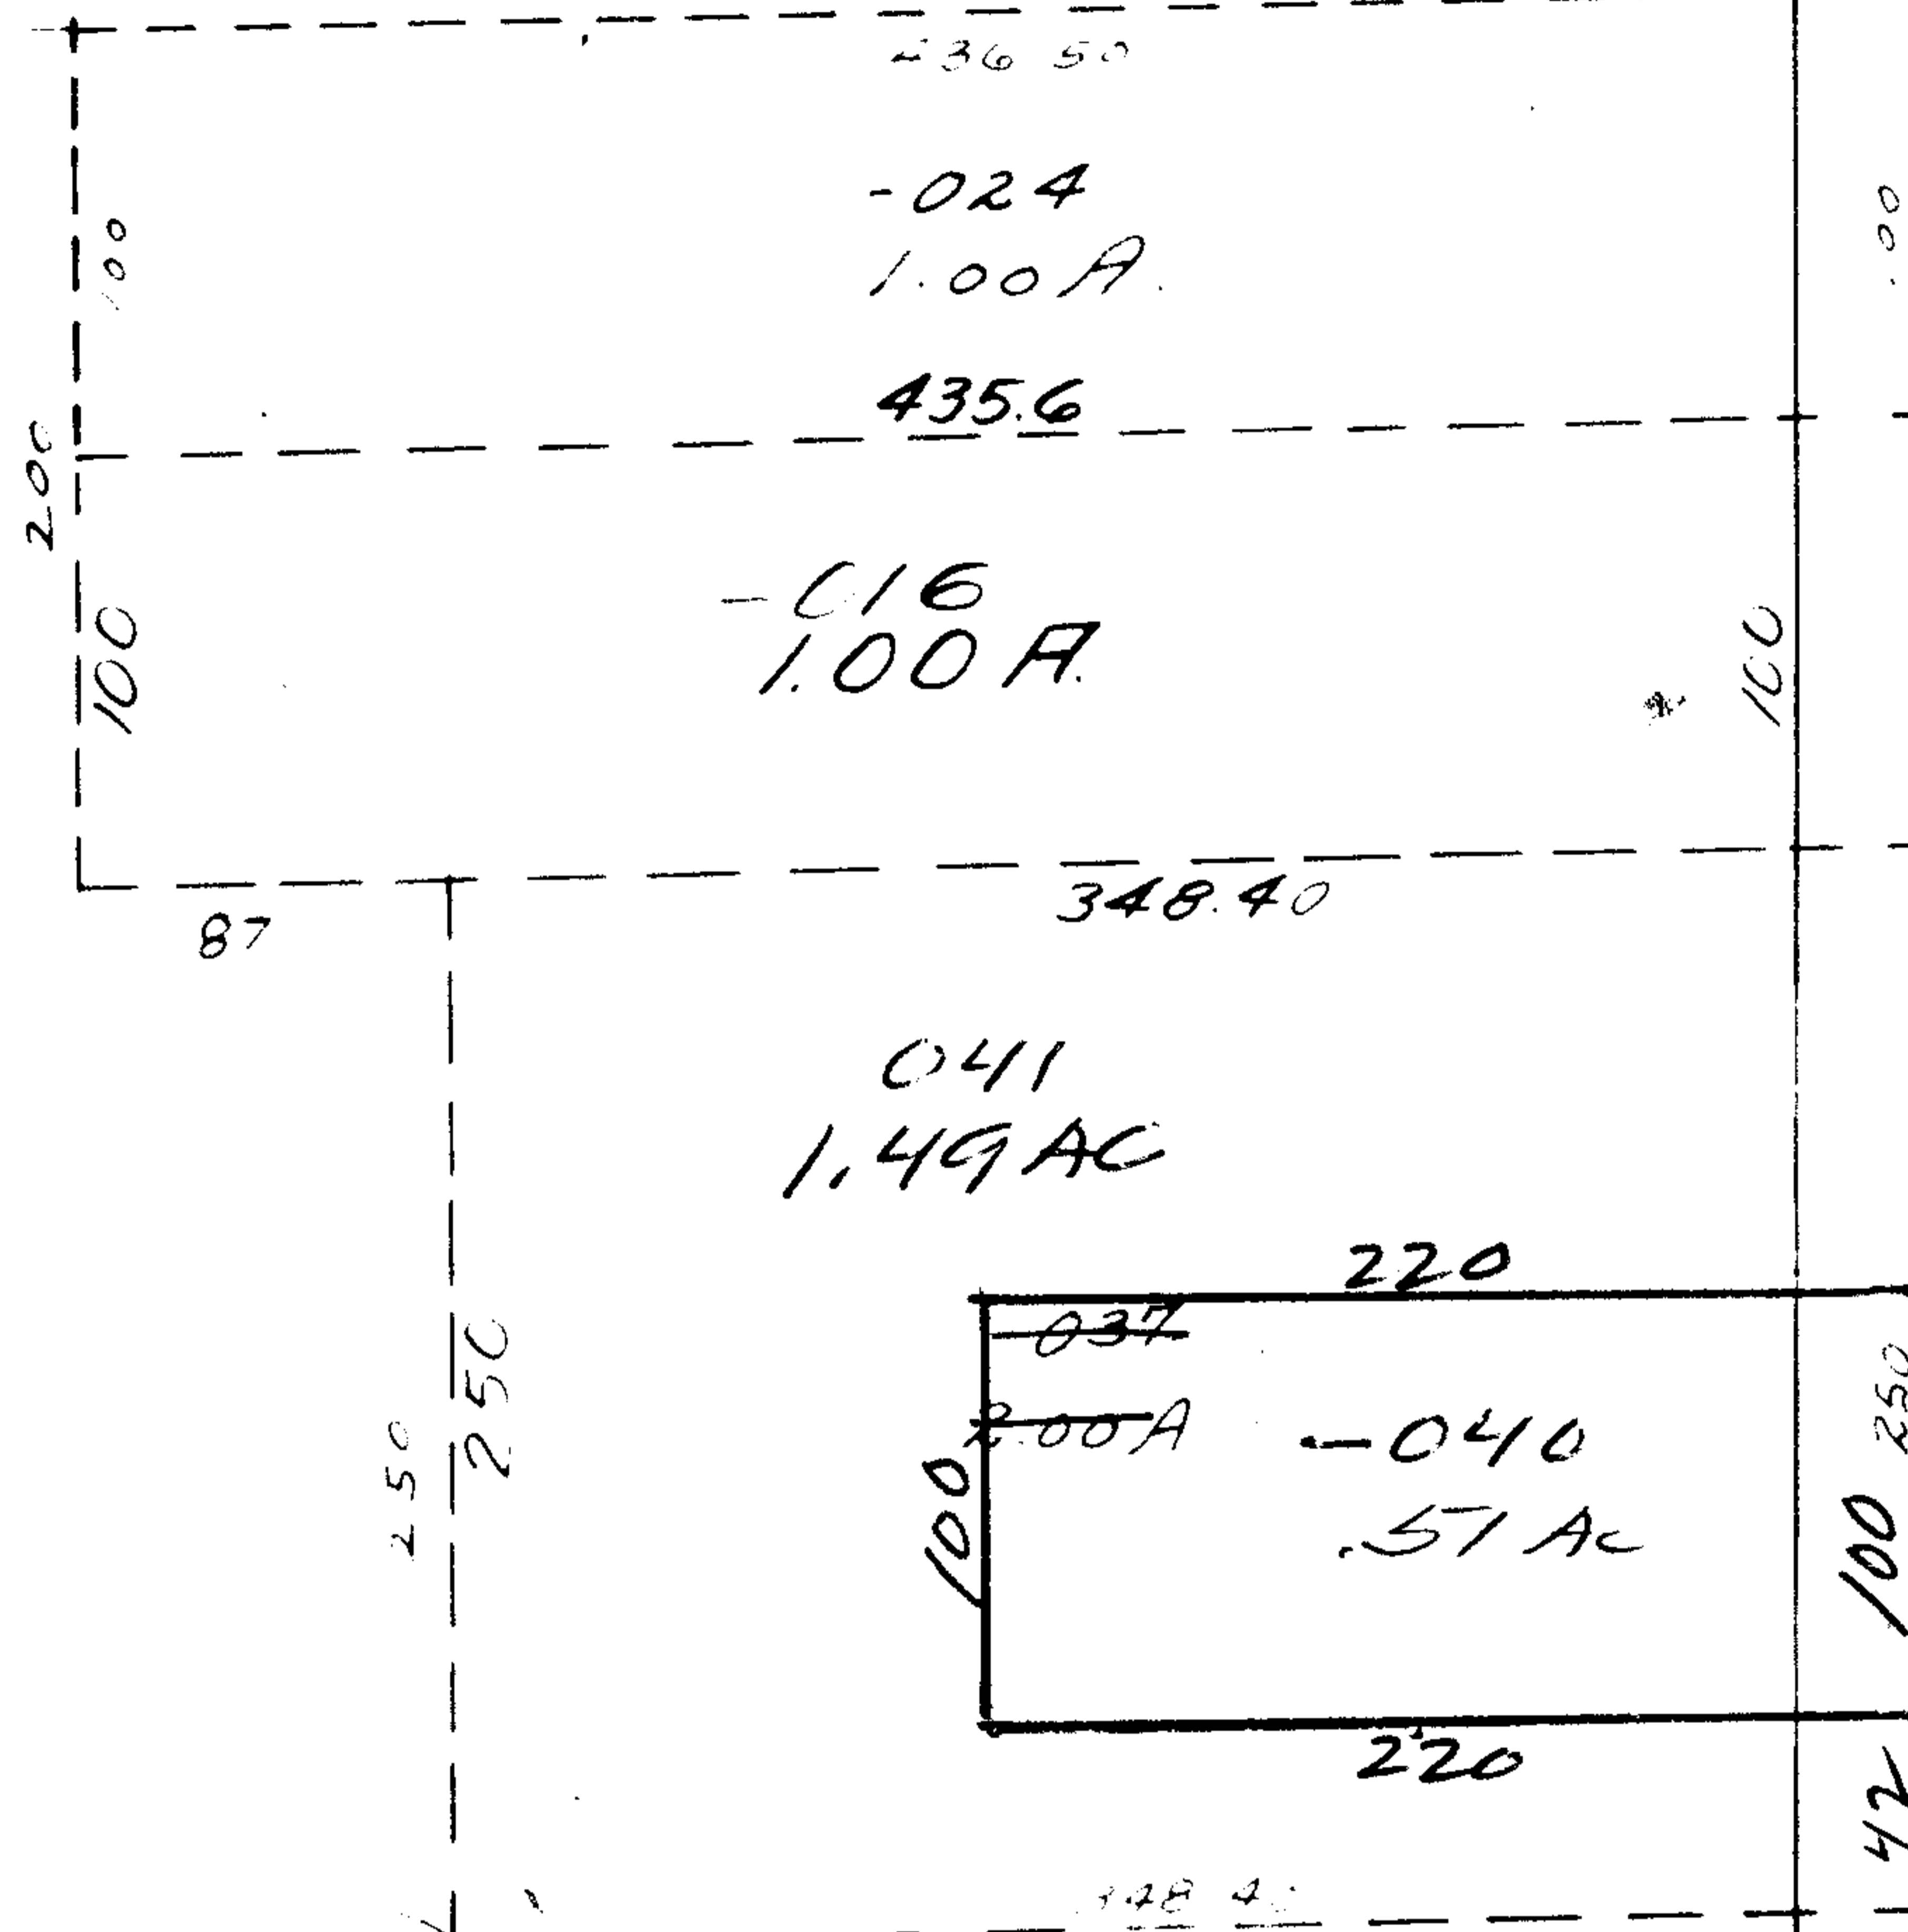

8548

APPROVED LORAIN CO. MAP DEPT.	
DATE	2-6-75
PAGE	11-00-016B
BY	LW Hale
VOID AFTER	

-019
5.00 A.