


8559

FEB 13 1975

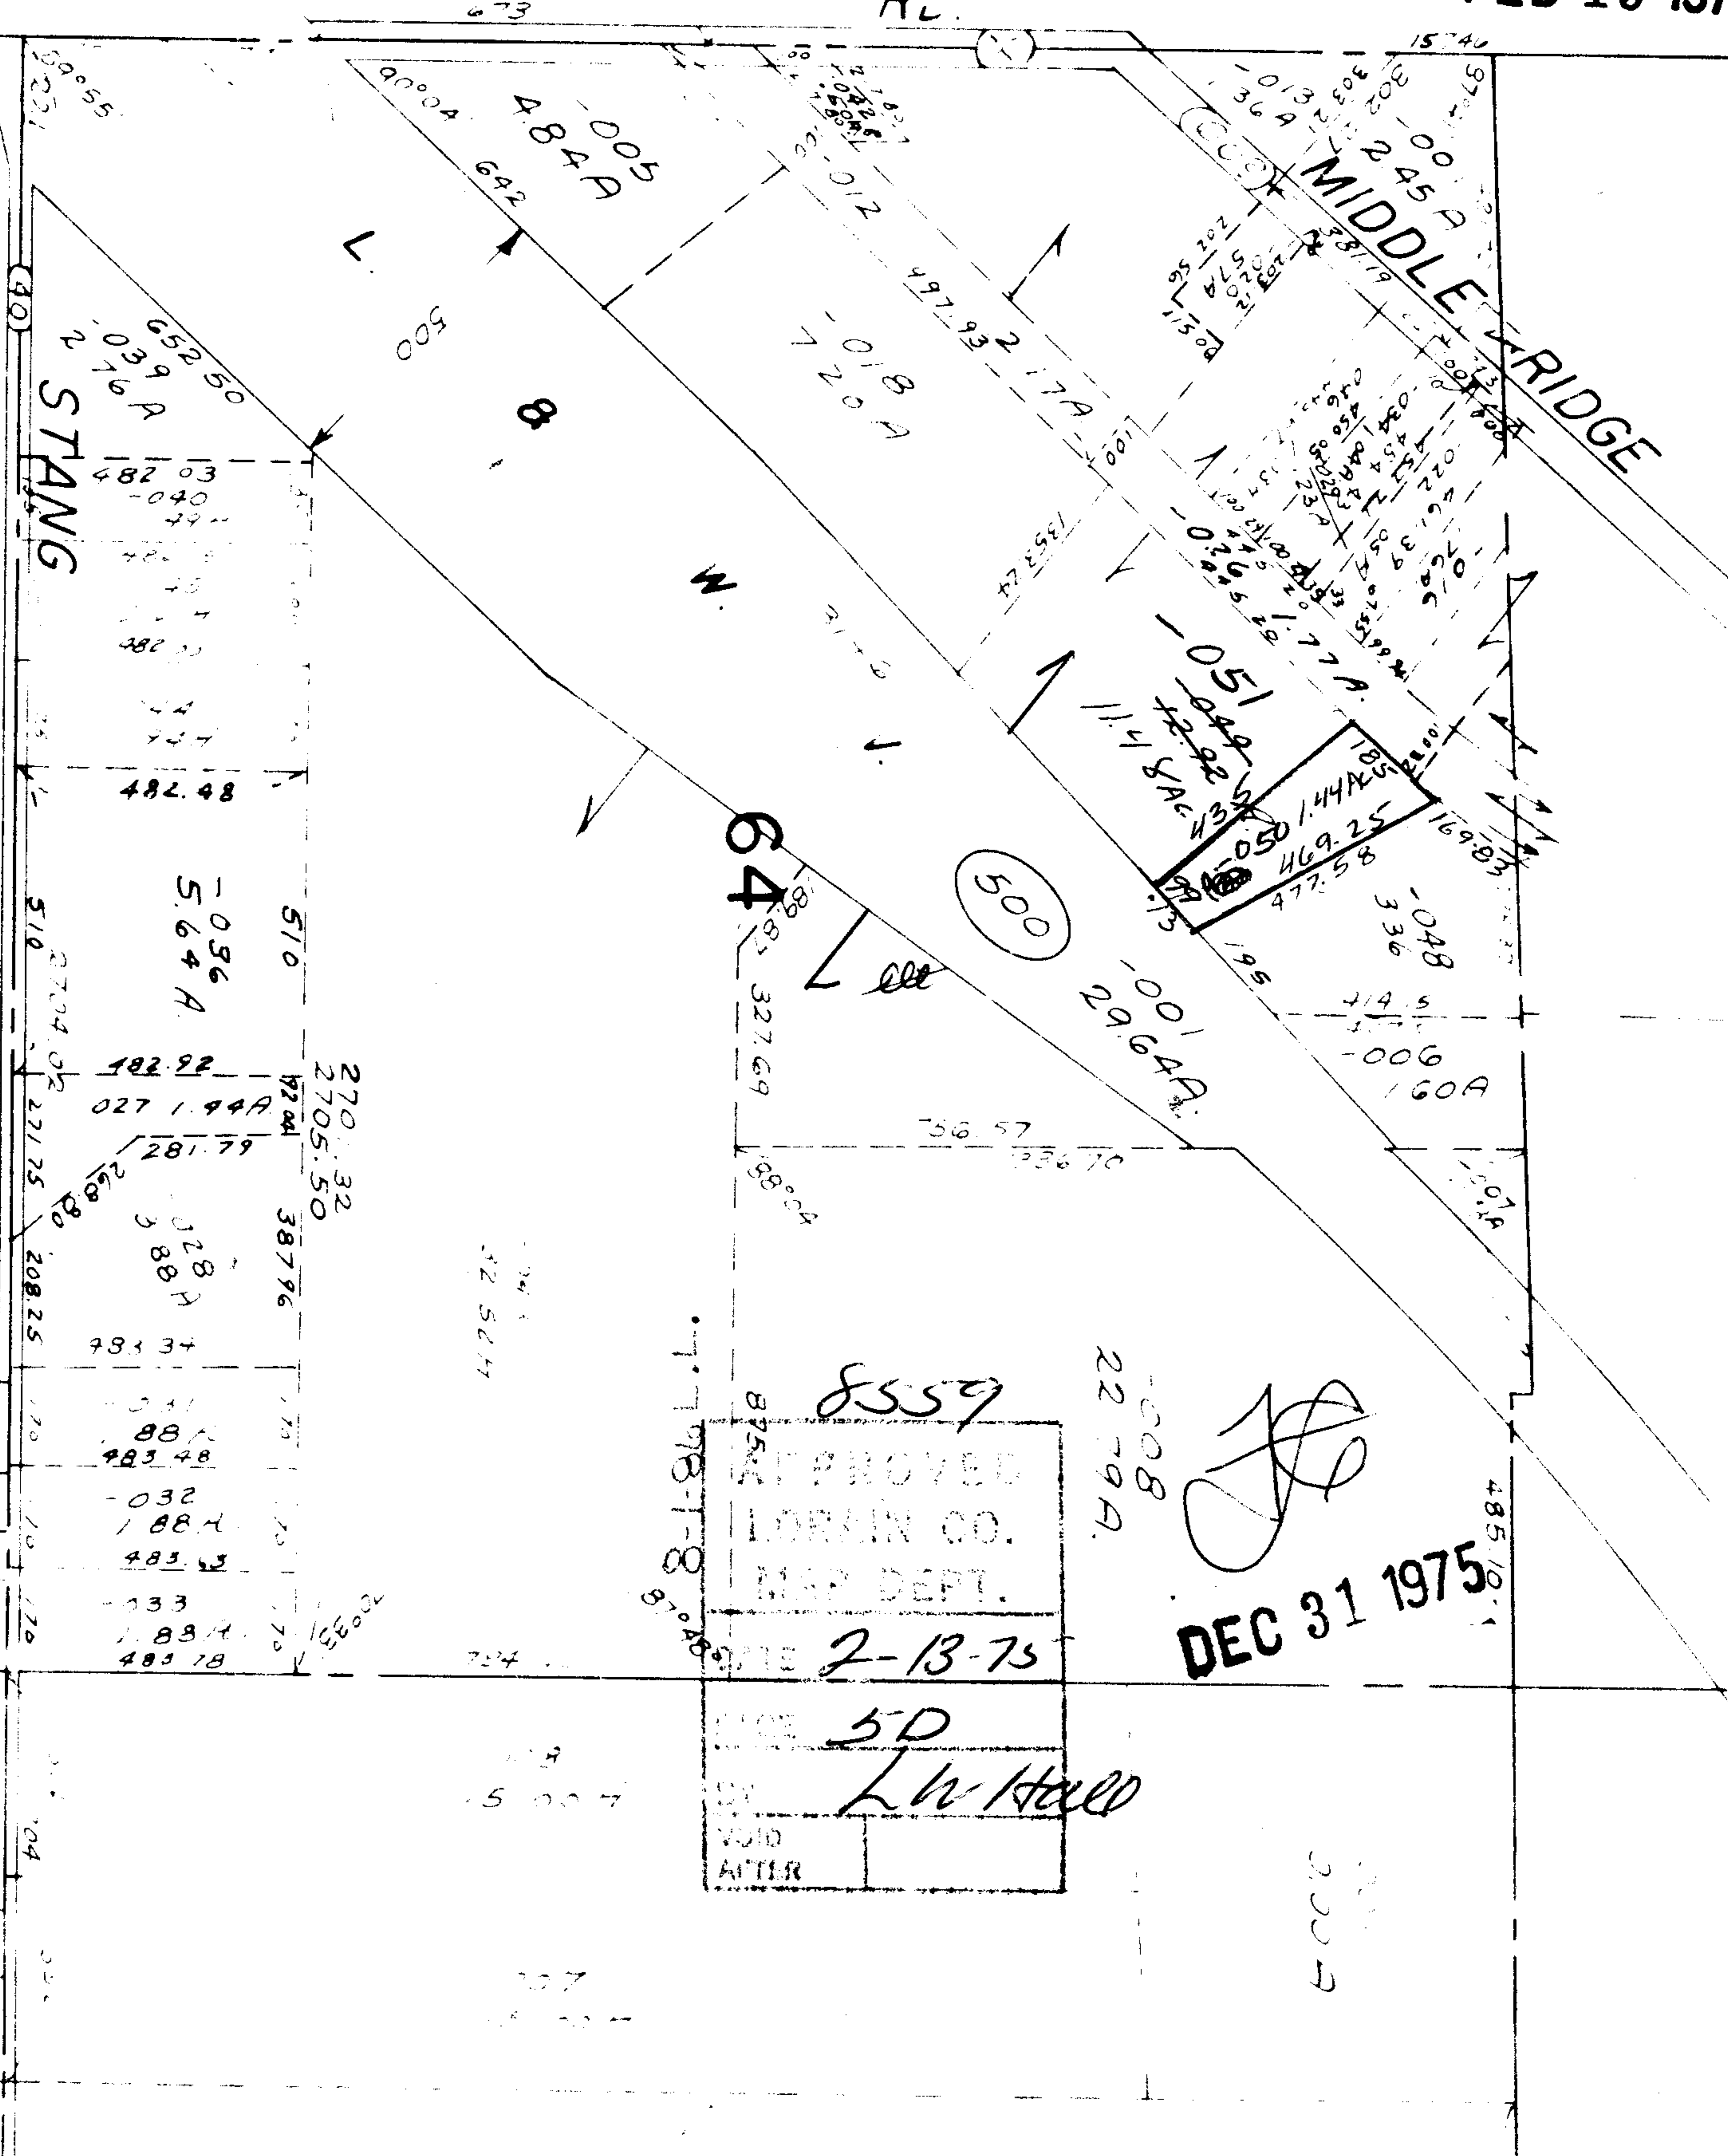

8559
 APPROVED
 LORAIN CO.
 H&S DEPT.
 DATE 2-13-75
 FILE 5D
 BY L.W. HALL
 VOID
 AFTER

DEC 31 1975

500