

8560

14642

WEST - RIVER
410.9
62072

DEC 1 1975

FEB 21 1975



~~200.82~~
~~148.25~~

APPROVED
LORAIN CO.
MAP DEPT.

DATE 2-14-75

BY 6-29
L. N. Hall

VOID
AFTER

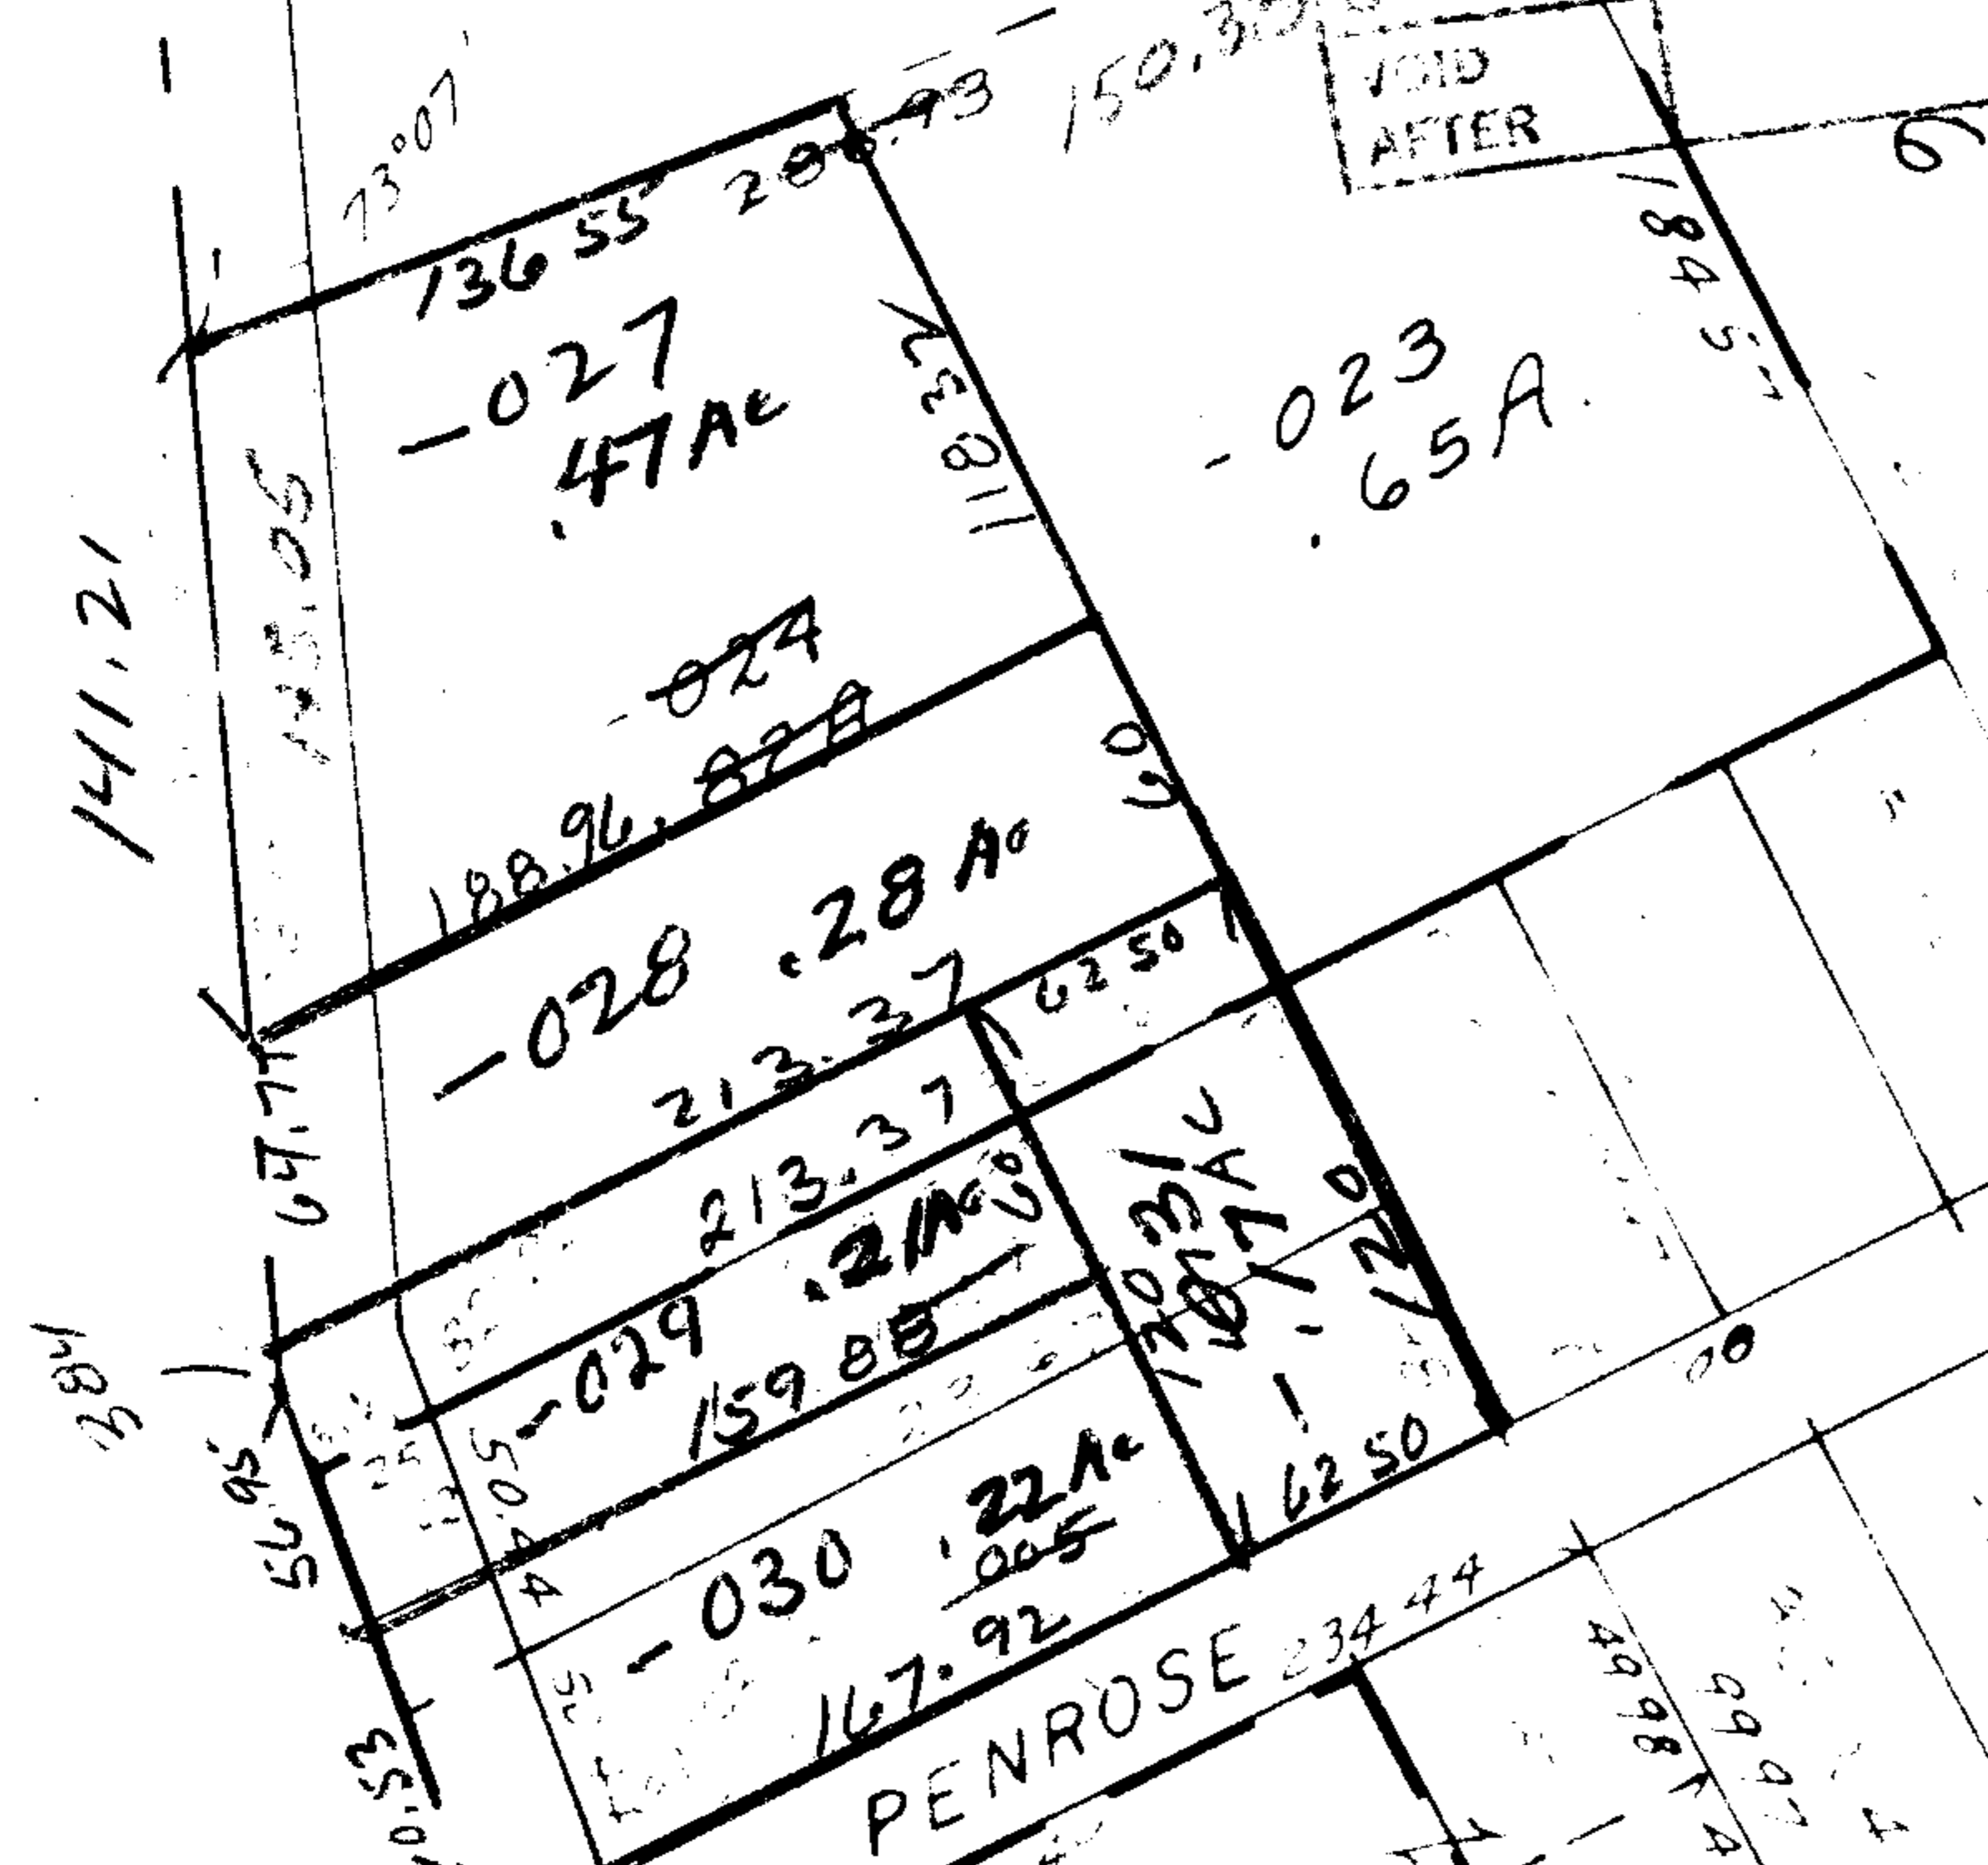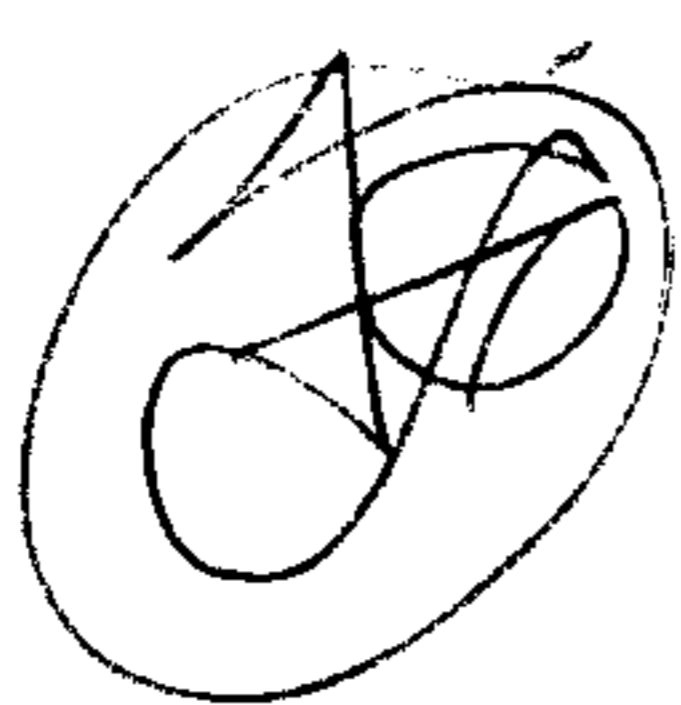

PENROSE

-022
1140

-024
A. D. J.