



8561

LAW RD.

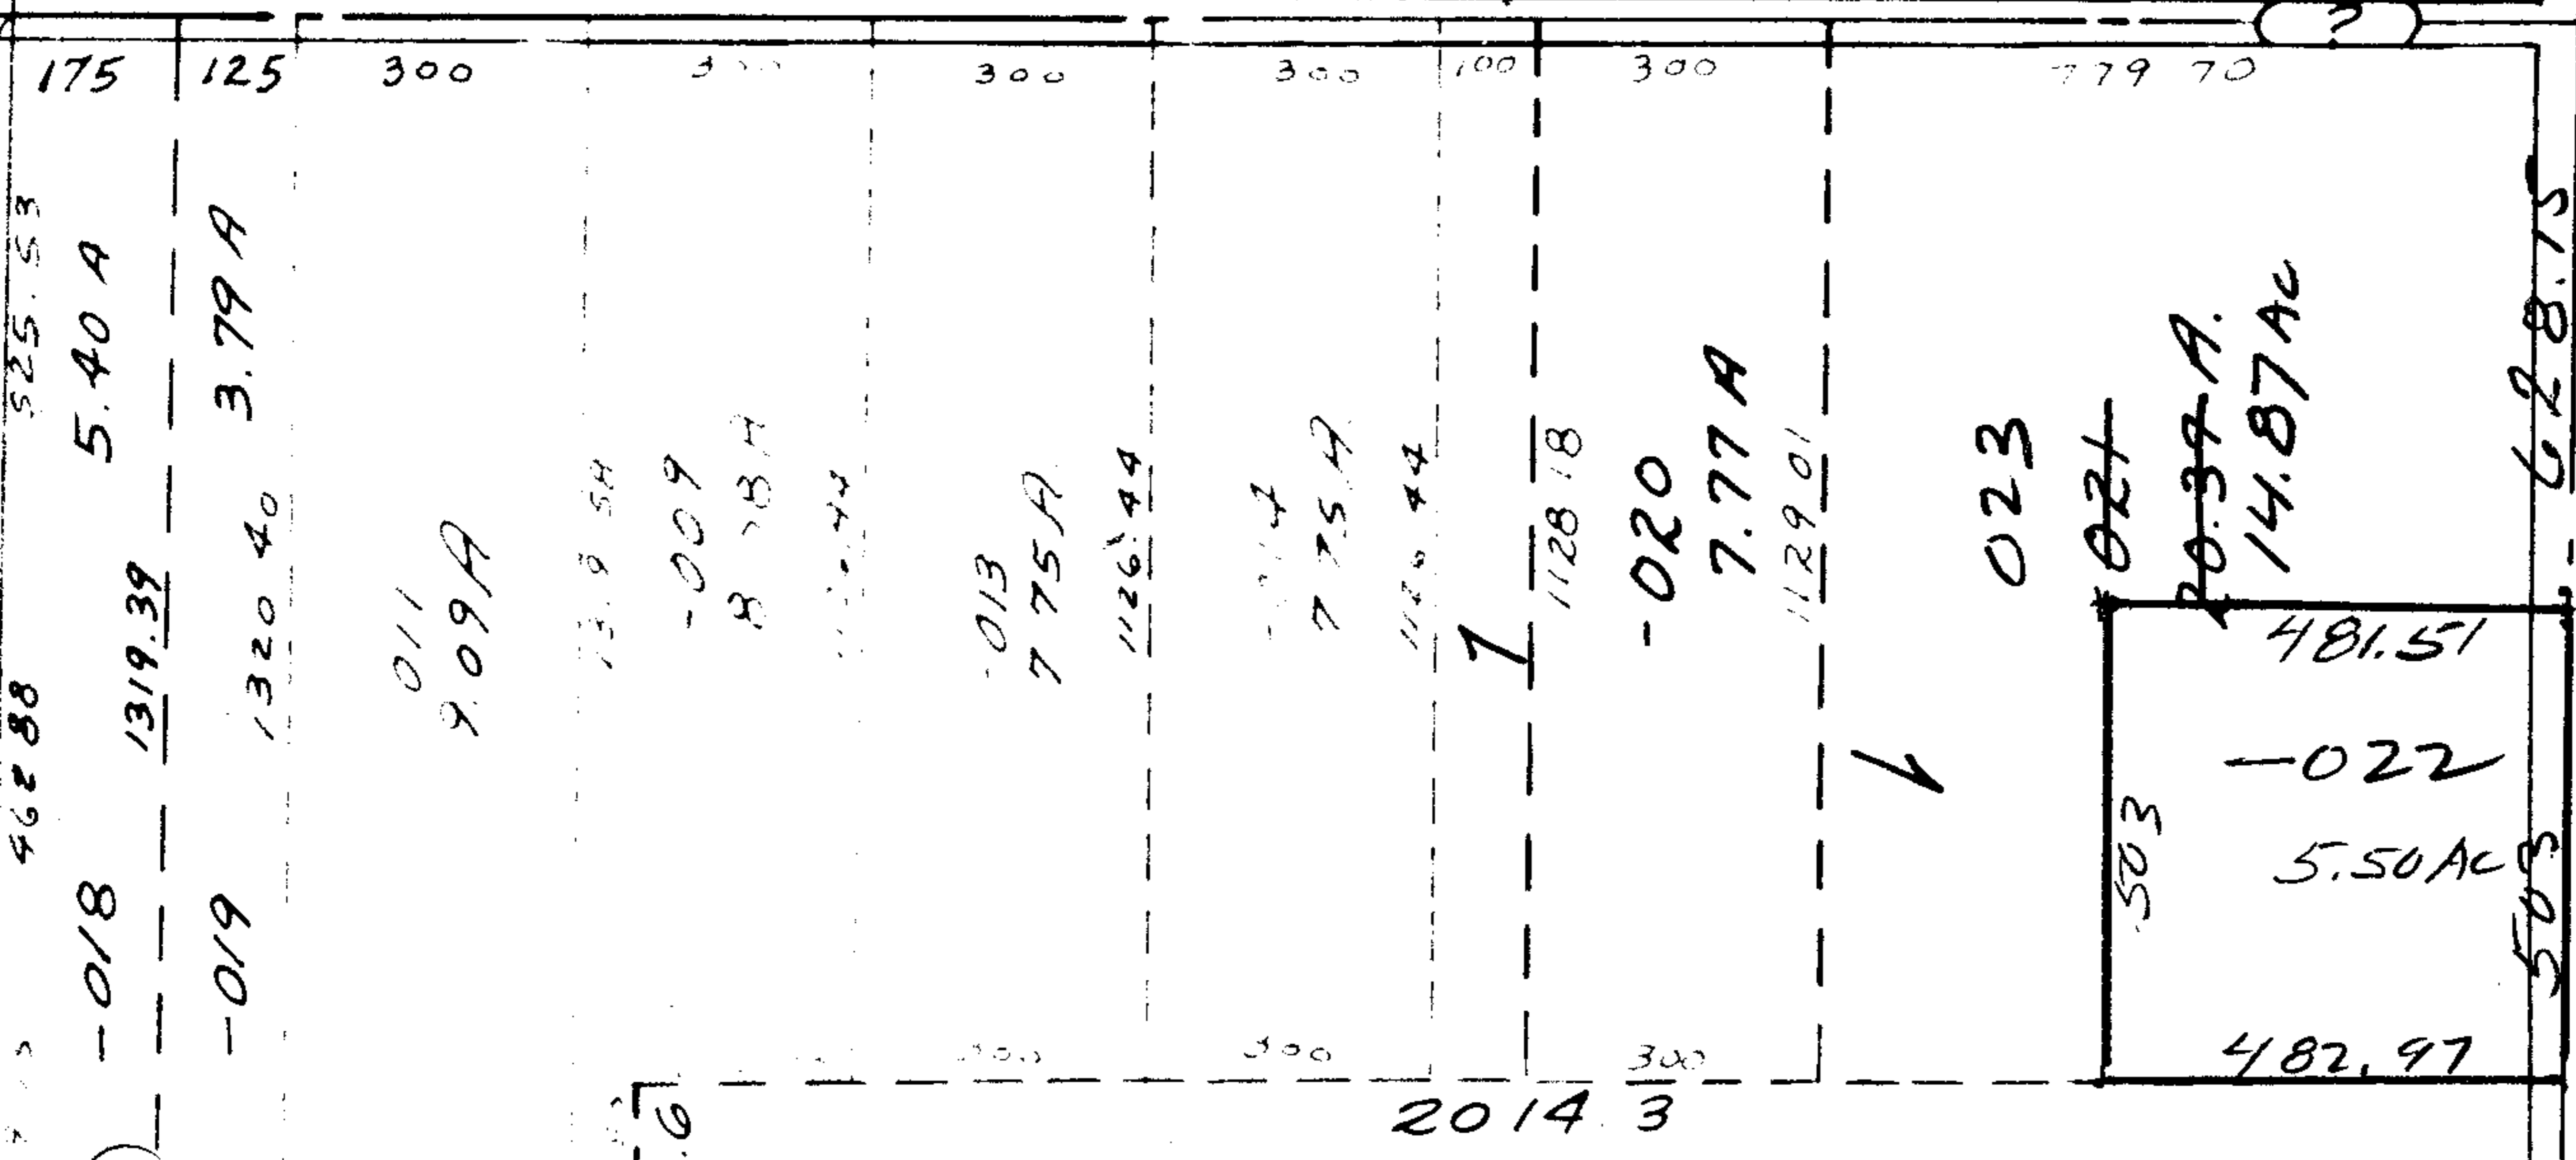

MAY 15 1975
 FEB 14 1975

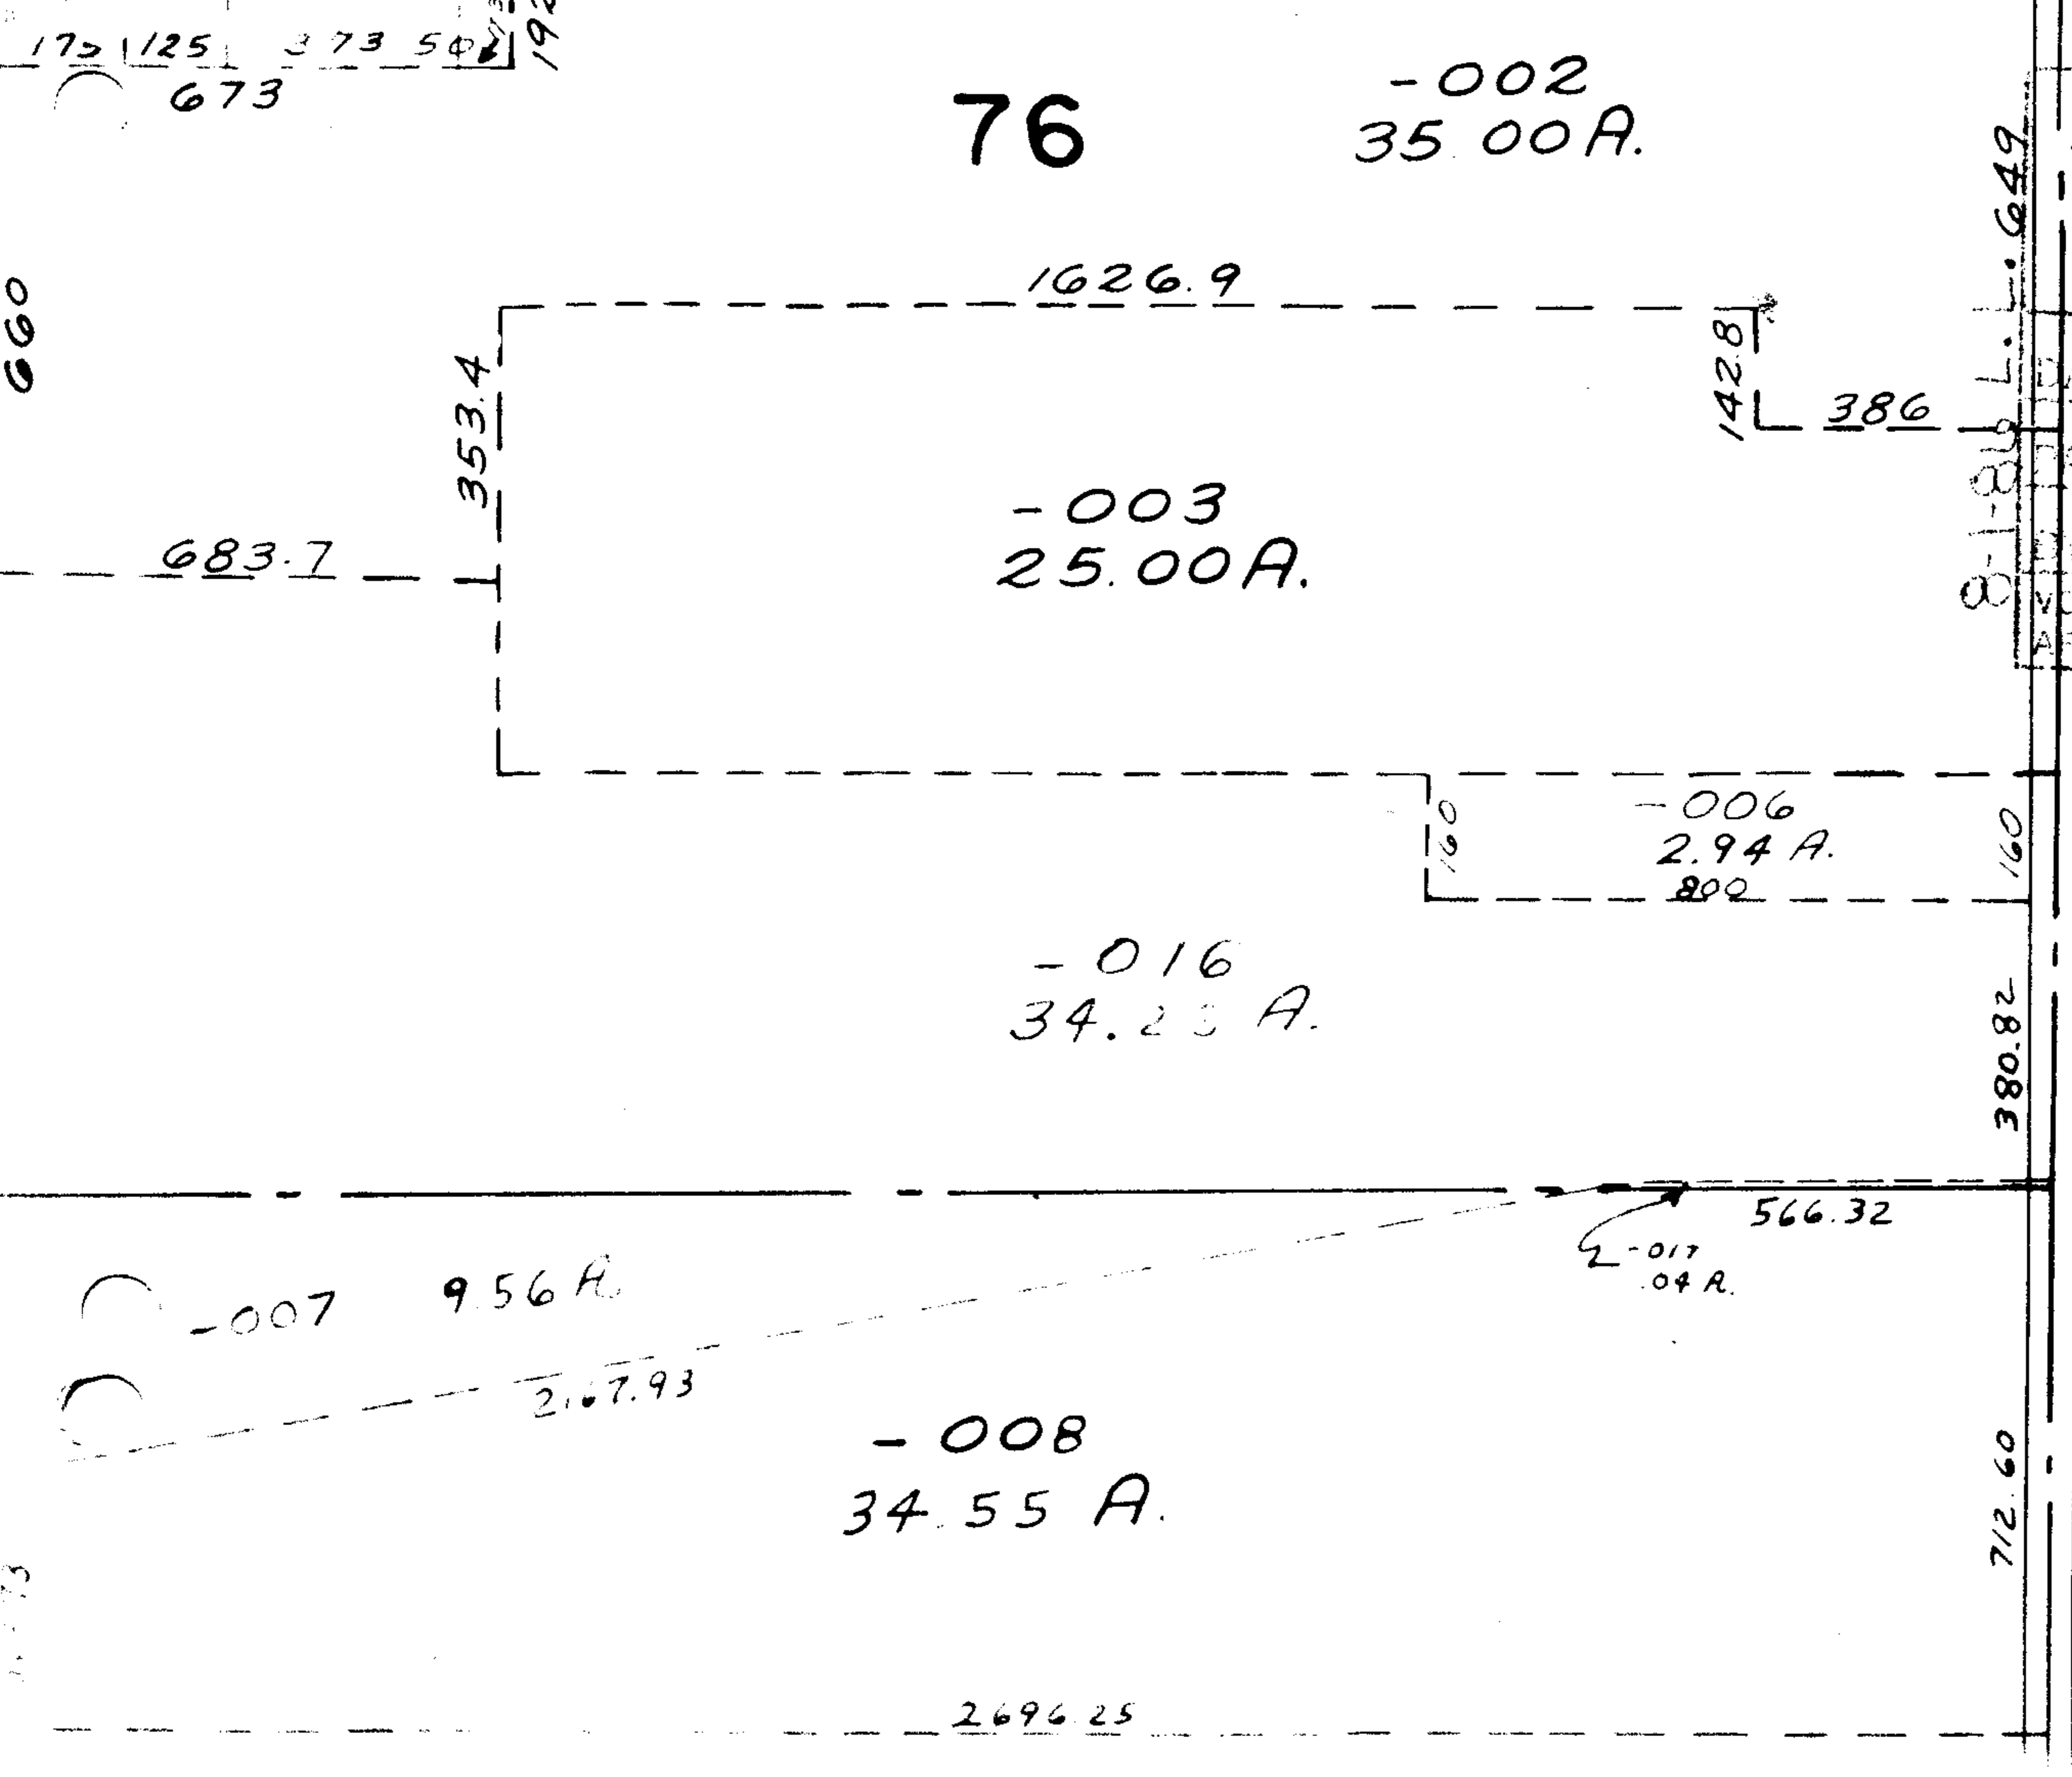

8561
 APPROVED
 GRAD. CO.
 MAP DEPT.
 DATE 2-13-75
 SCALE 1/6 F
 L.W. HALL
 VOID
 AFTER