


8562

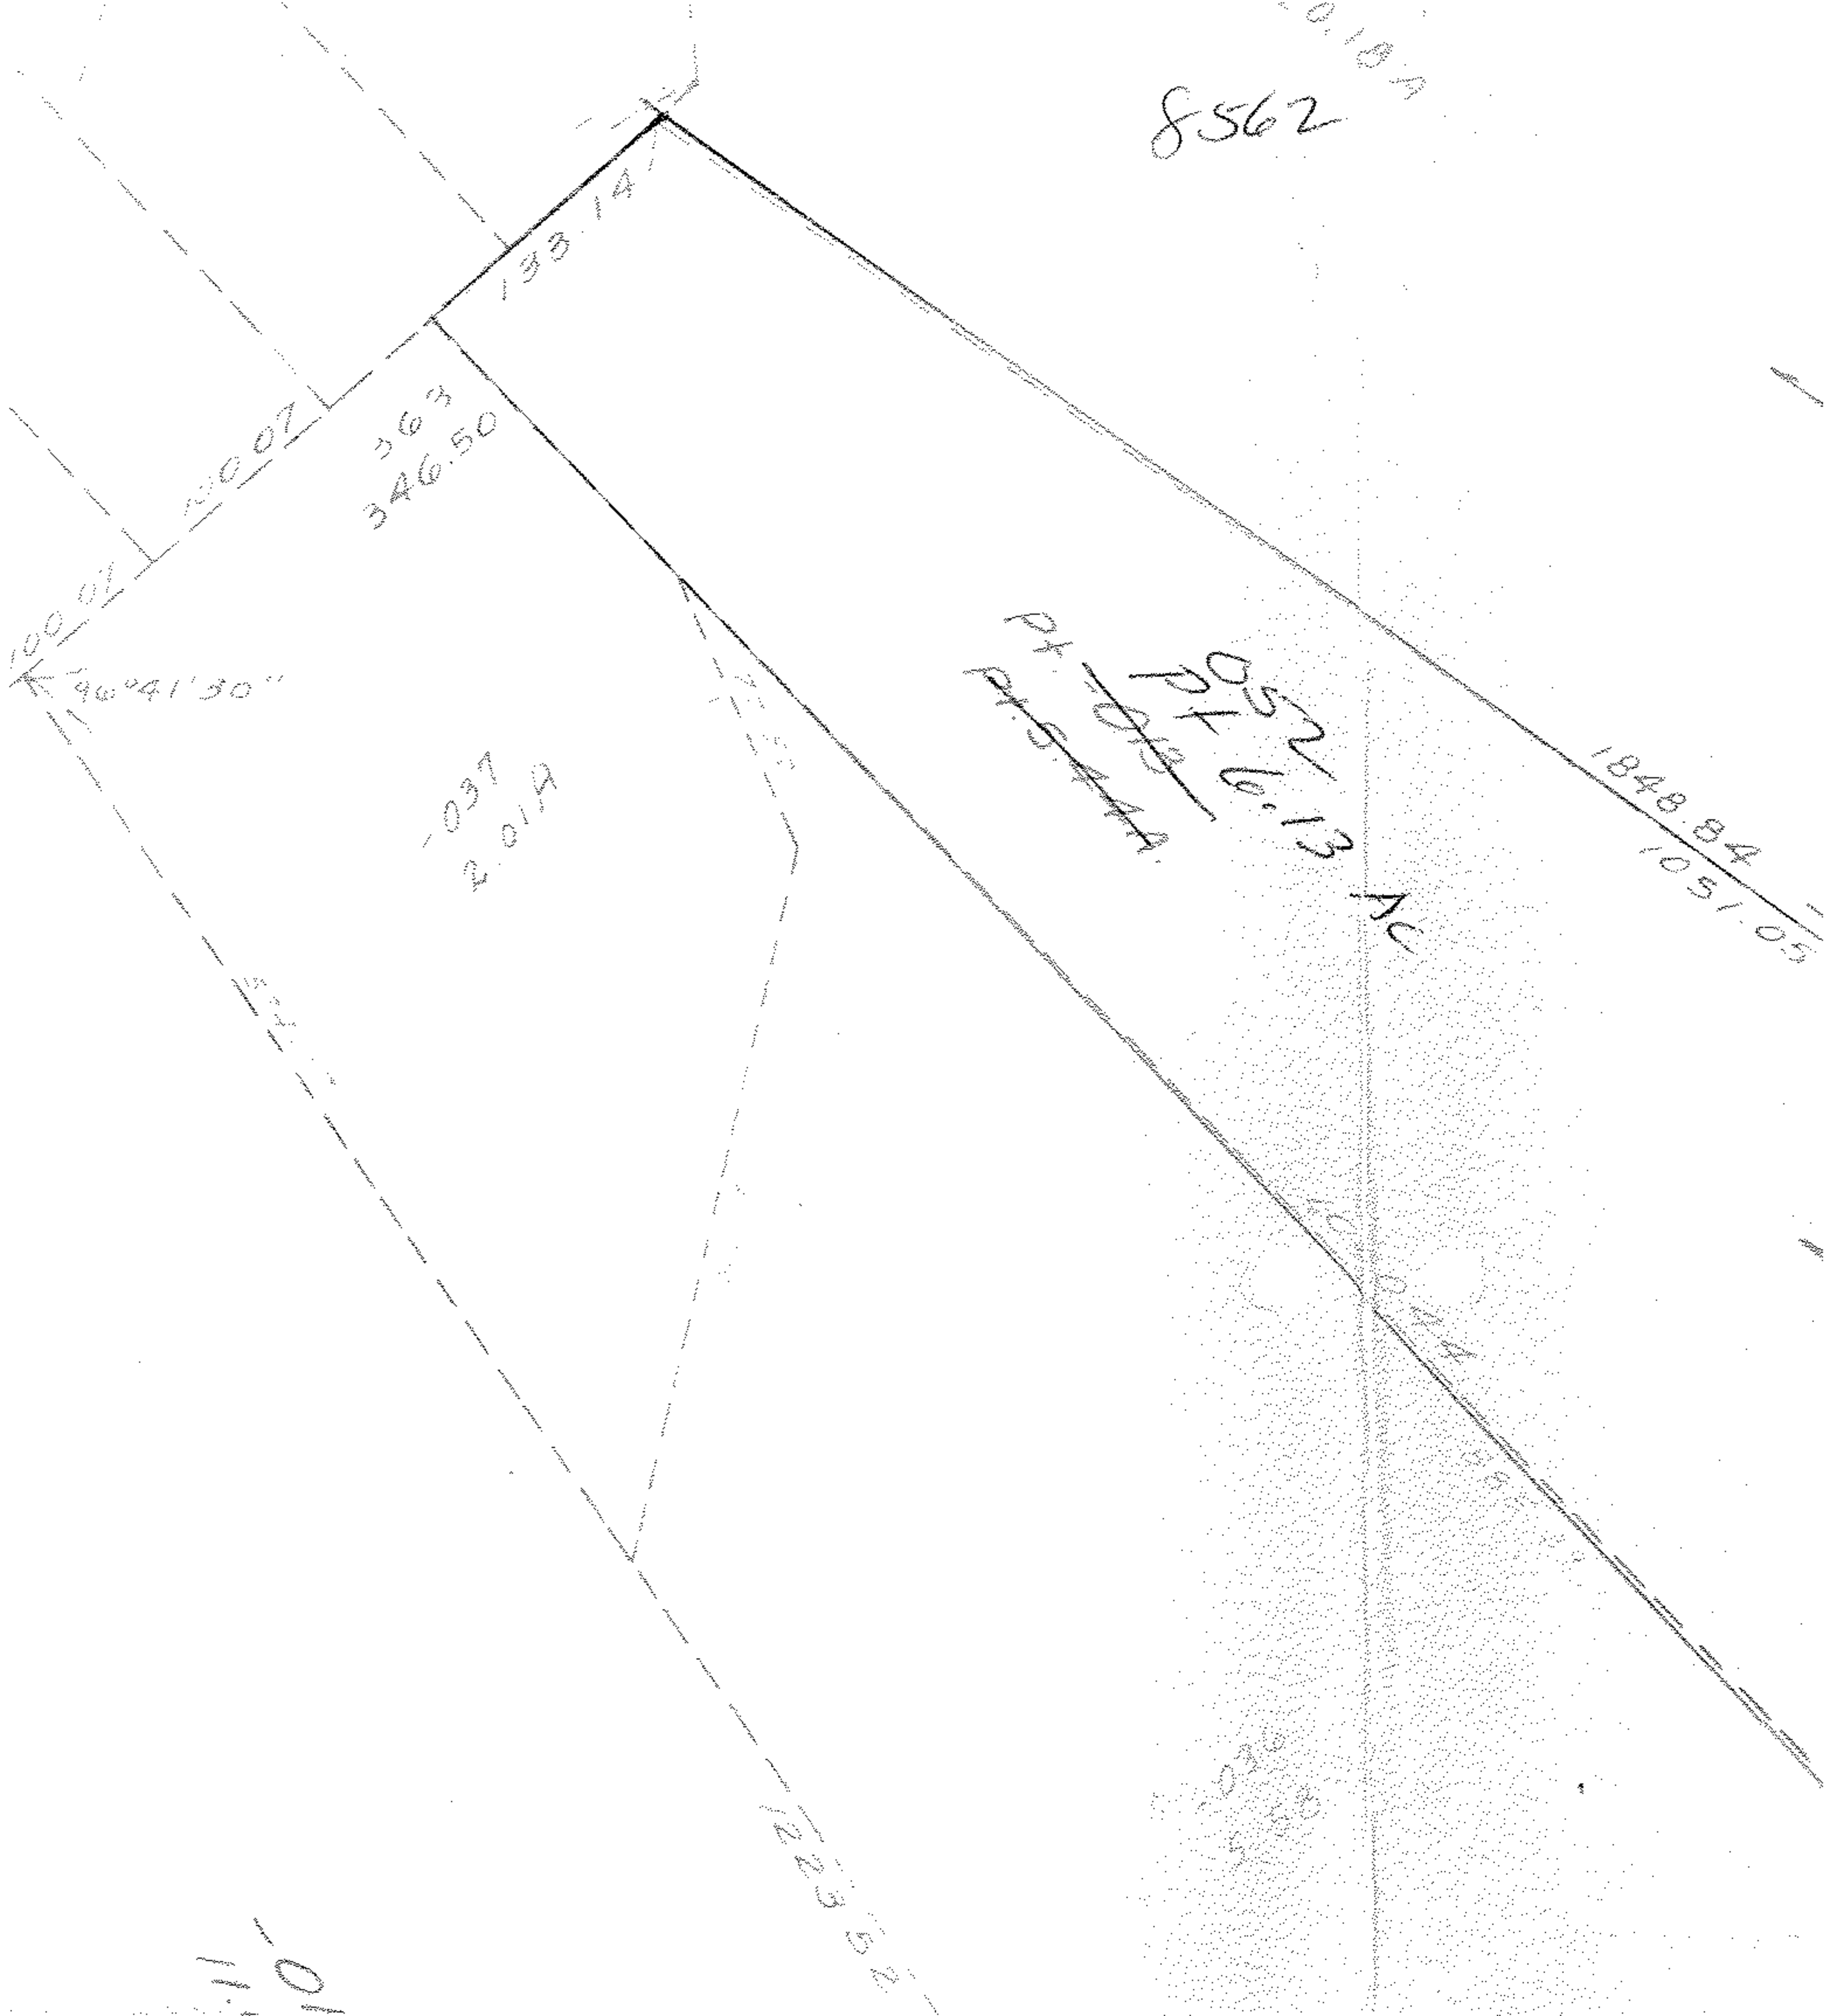

100.07  
 100.07  
 $96^{\circ}41'30''$

363  
 346.50

037  
 2.014

~~PT. S.W. 1/4~~  
 526.13

1848.84  
 1051.05

1223.52

110  
 101