

-062
1.92 A.

FEB 21 1975

2.0
-036
51 A.
260

859.22

80
-028
1.00 A
544.51

85
85
80
80
RD.

490
183.81
673.81

JUL 1 1975



-066
~~059~~
~~13.44 A.~~
11.10 A.C.

80
272.26
-029
0.50 A.
80
-030
0.50 A.
272.26
80
-044
50 A.
272.26
80
-049
50 A.

7.7
98-1-8


8567



APPROVED LORAIN CO. MAP DEPT.
DATE 2-19-75
PAGE 7-00-029-D
BY <i>Hollist</i>
VOID AFTER

90
430
-064
0.89 A.C.
430
90

430
103
-065
0.45 A.C.
157.74
90
272.26
-058
56 A.
272.26
90
103

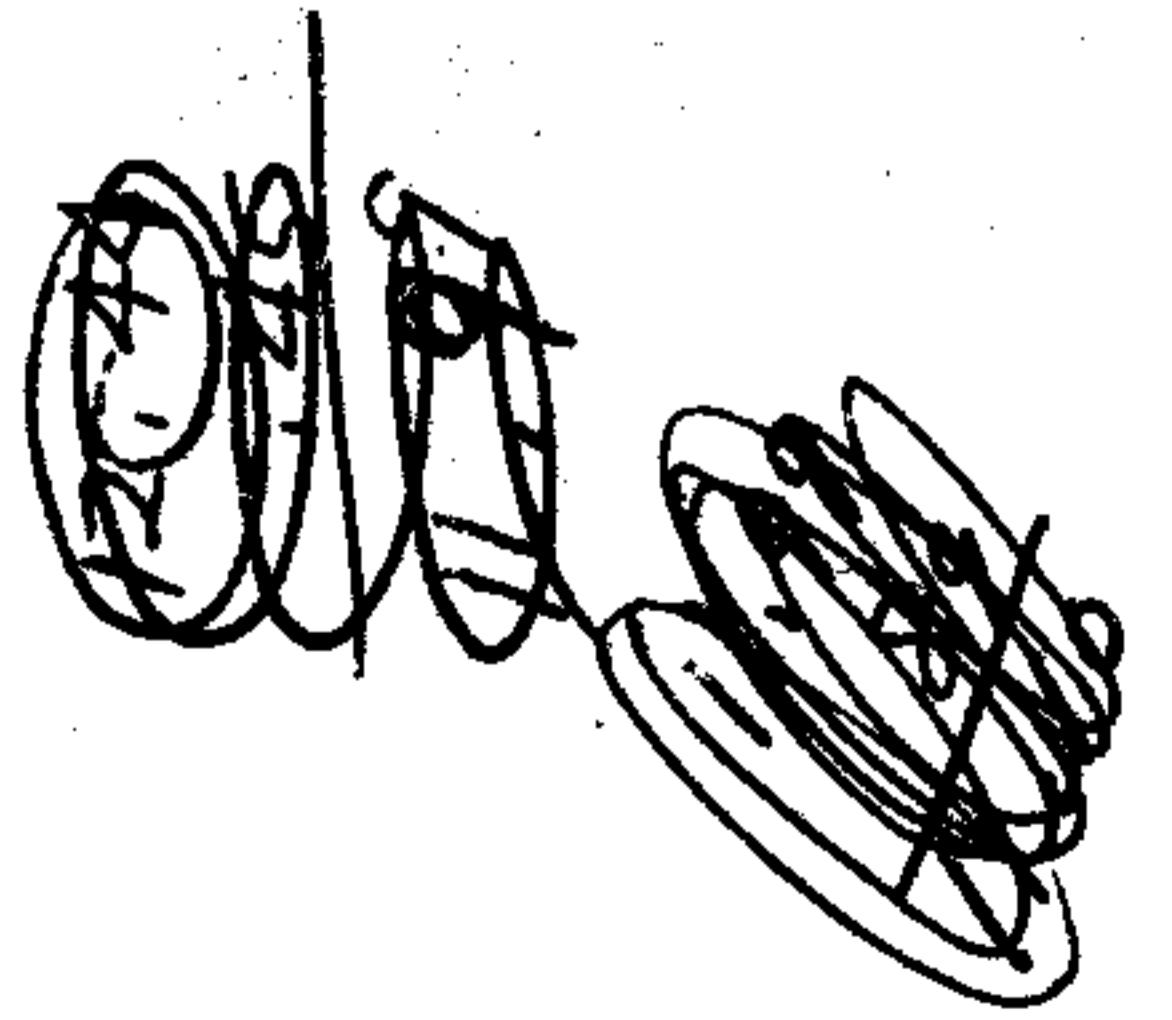

MAY 20 1975

7-00-020-C