



SEE 1-00-030-A

FEB 28 1975

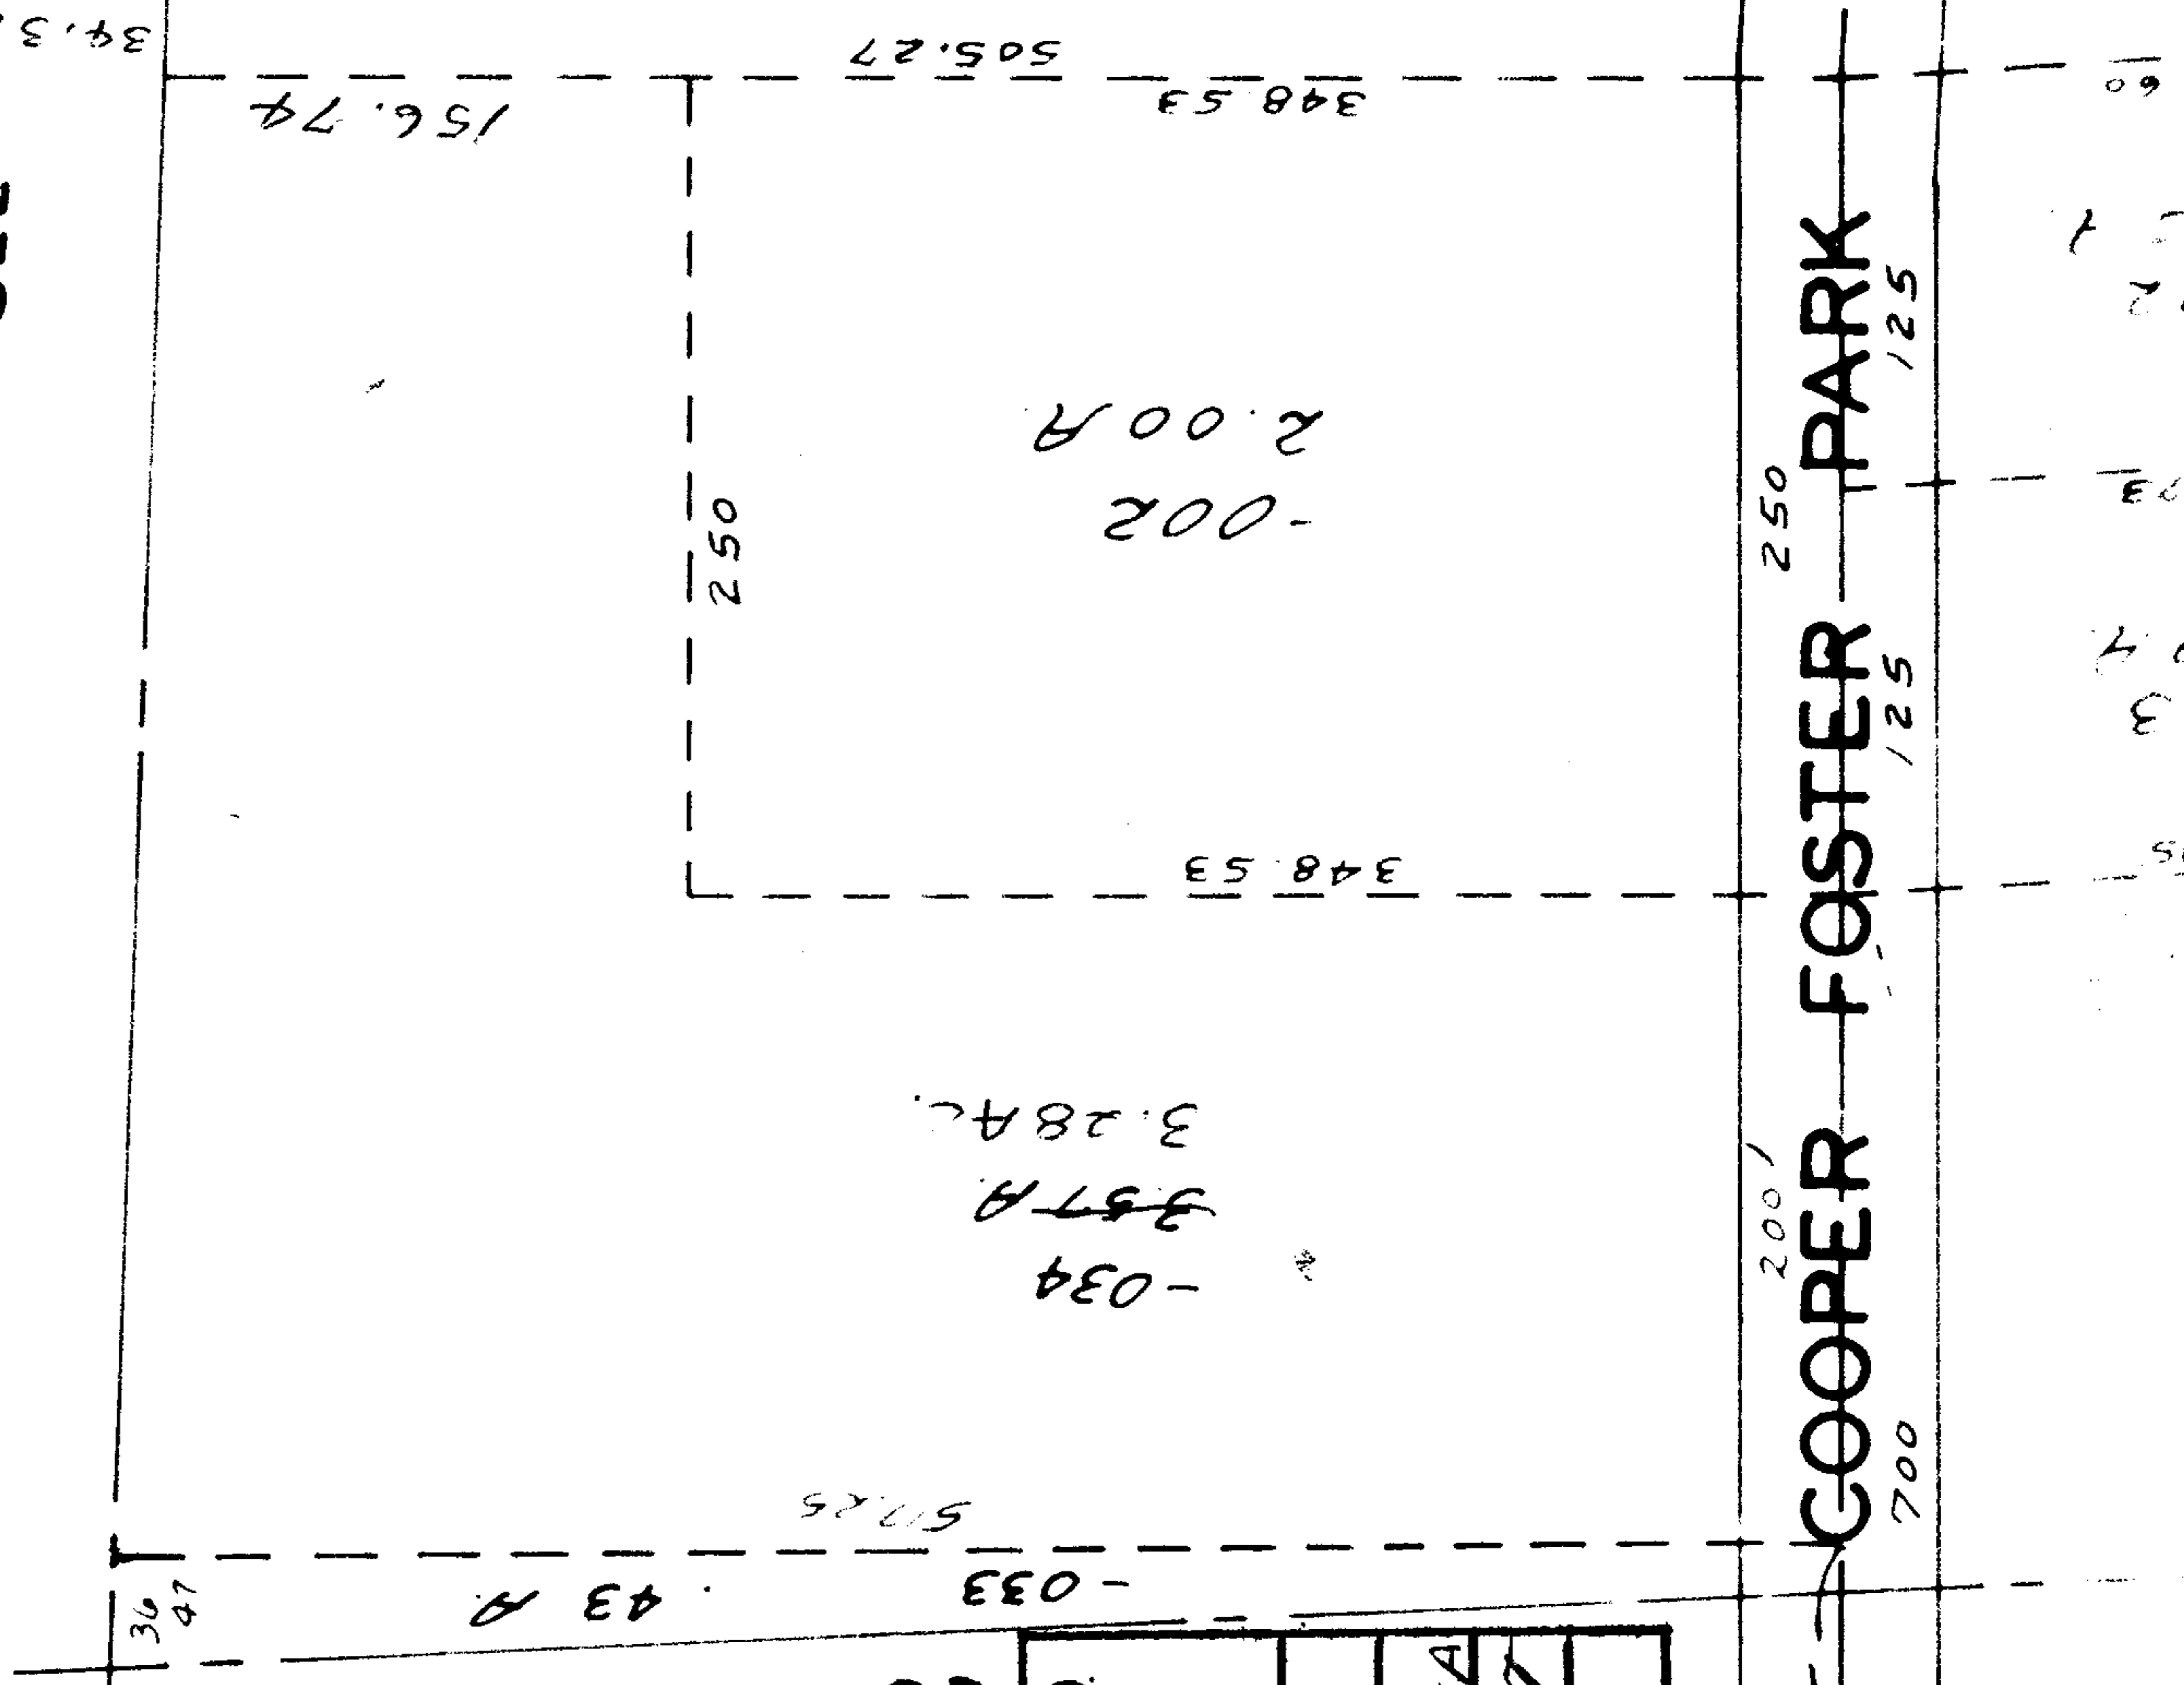

APR 16 1975

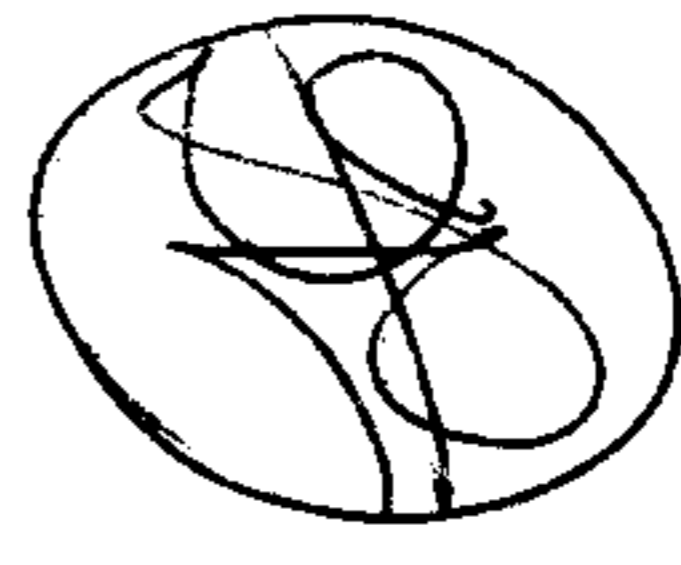

8582

APPROVED.	
LORAIN CO.	
MAP DEPT.	
DATE	2-25-75
PAGE	1-00-035A
BY	<i>J. E. Howard</i>
VOID AFTER	

COOPER FOSTER PARK

To Φ Ver. M. 500

63 20