


MAR 13 1975

Up 8591
North

see # 8484

-083
17.84

8591
APPROVED
LORAIN CO.
MAP DEPT.
DATE 3-5-75
CASE 7-00-0182
BY L.V. HALL
VOID
AFTER

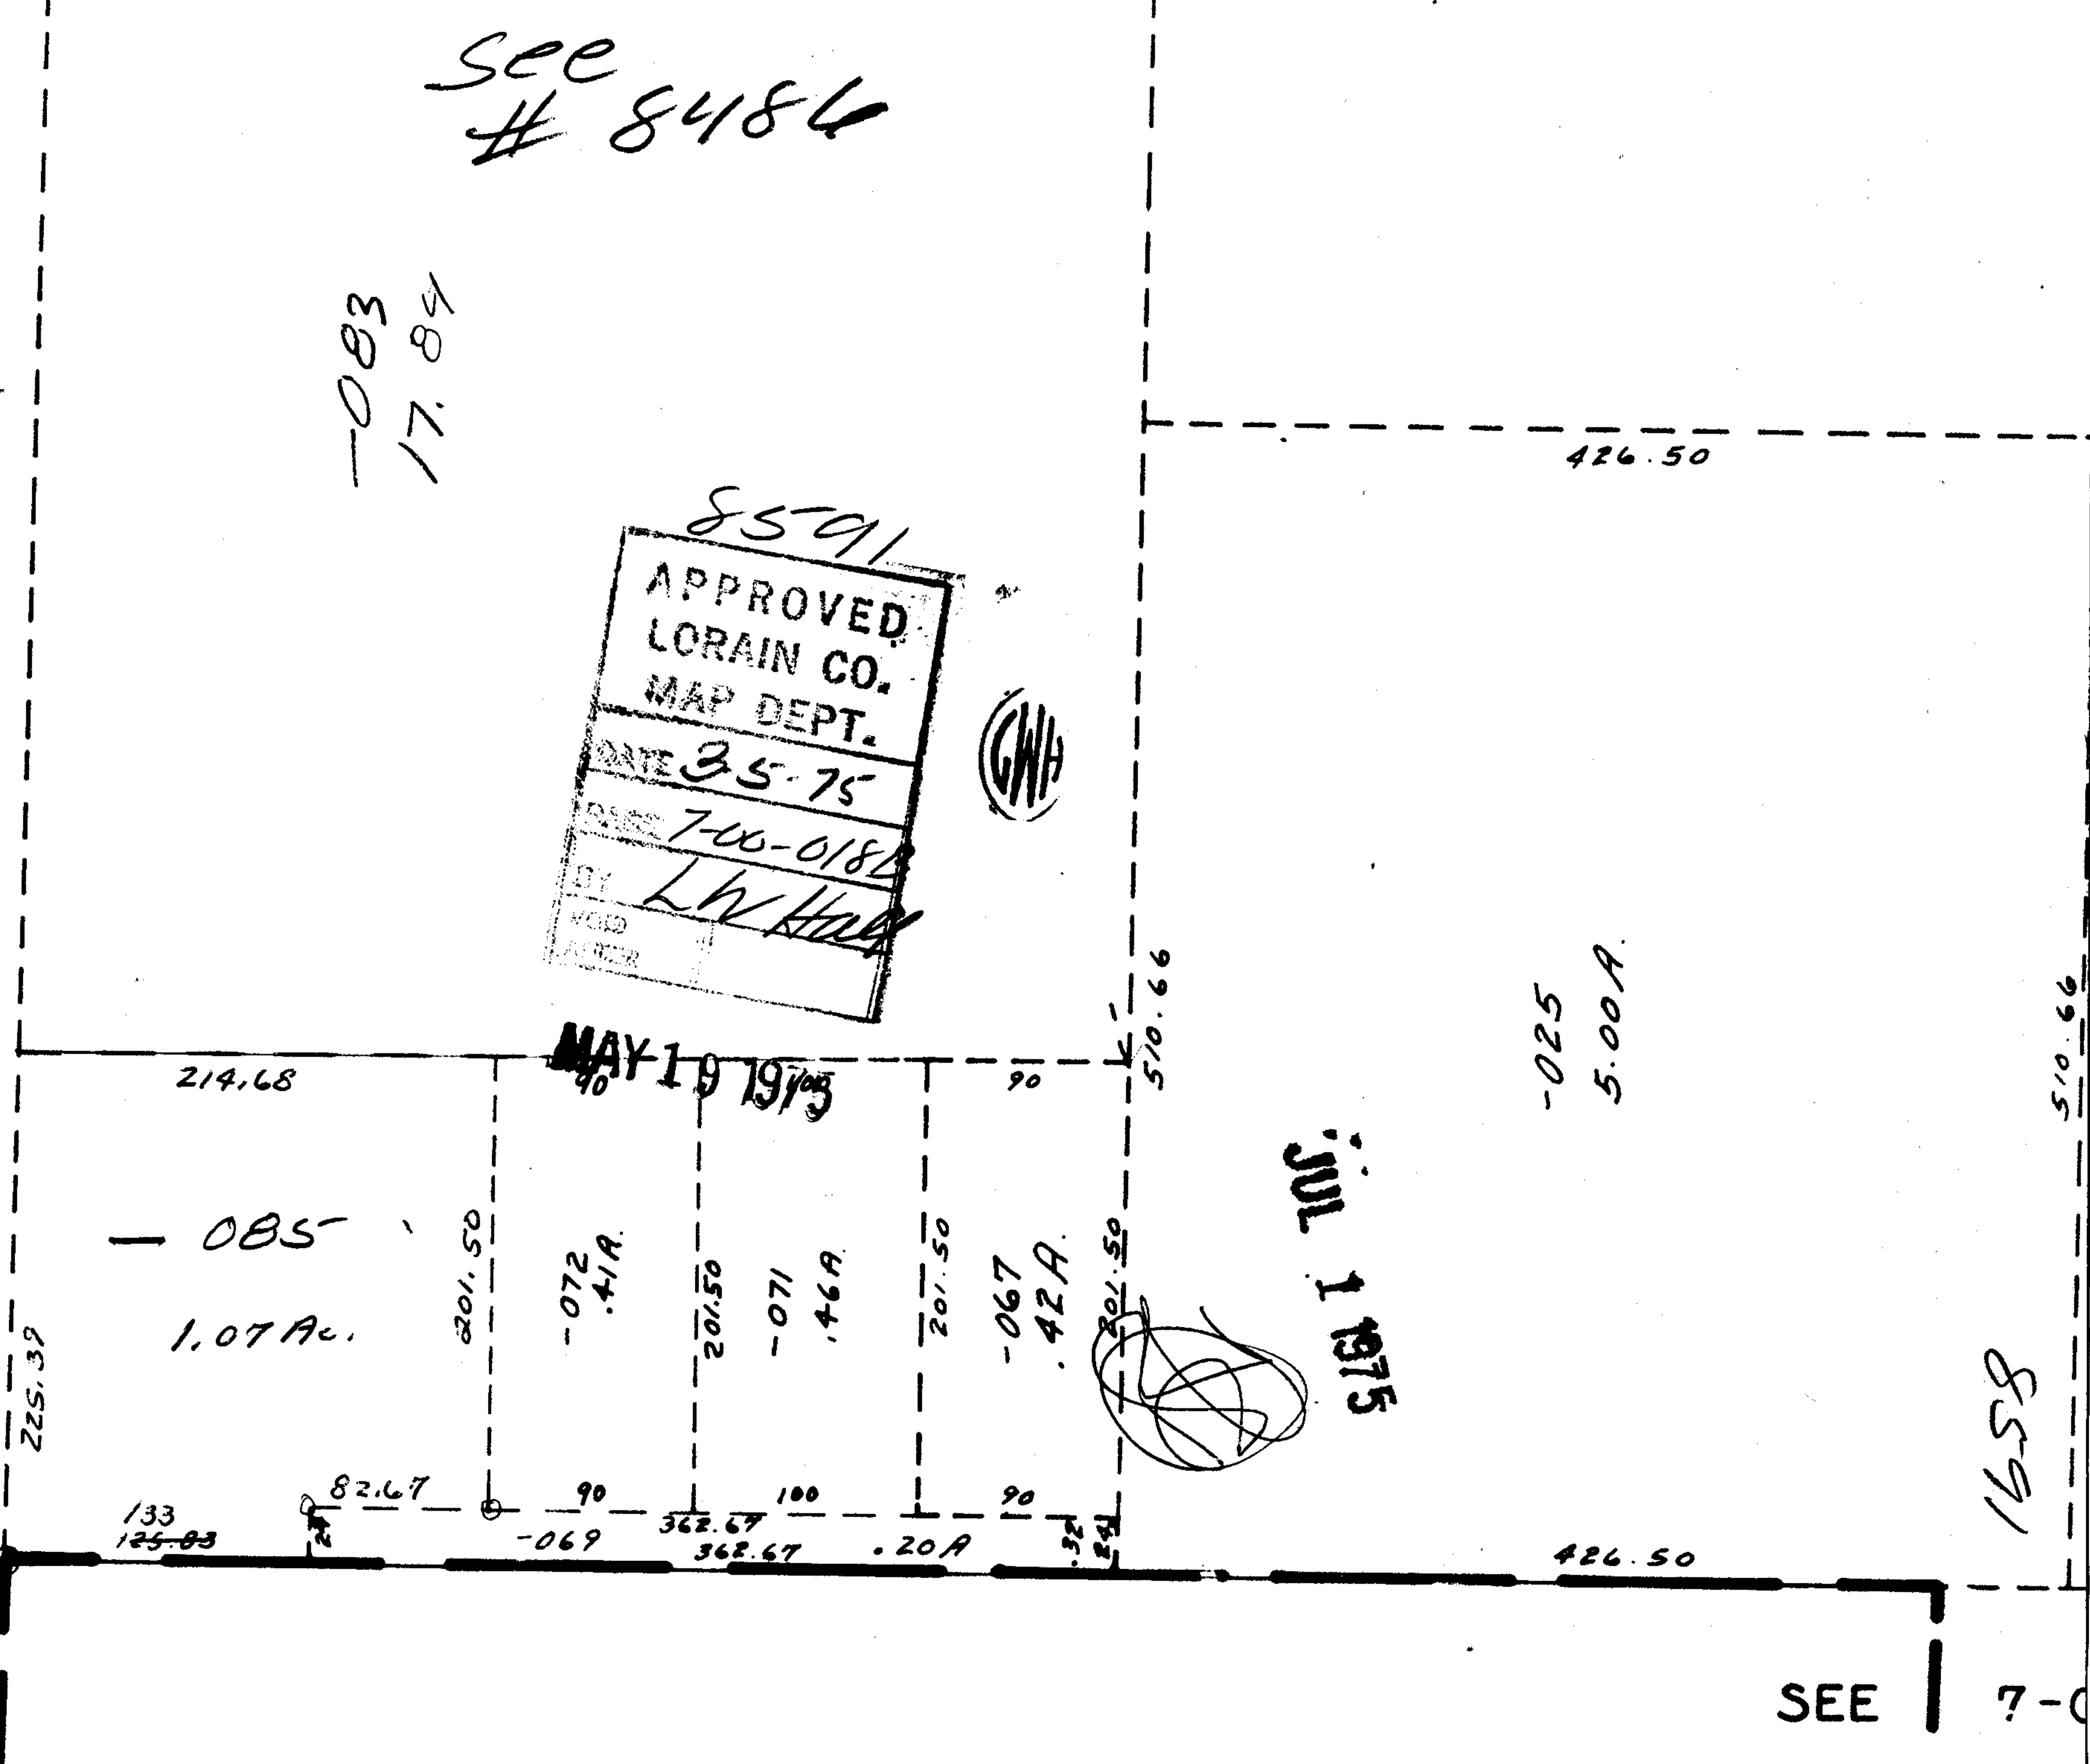

426.50

-025
5.00A.

JUL 1 1975

8591

510.66

SEE

7-0