


JUL 21 1975

8601

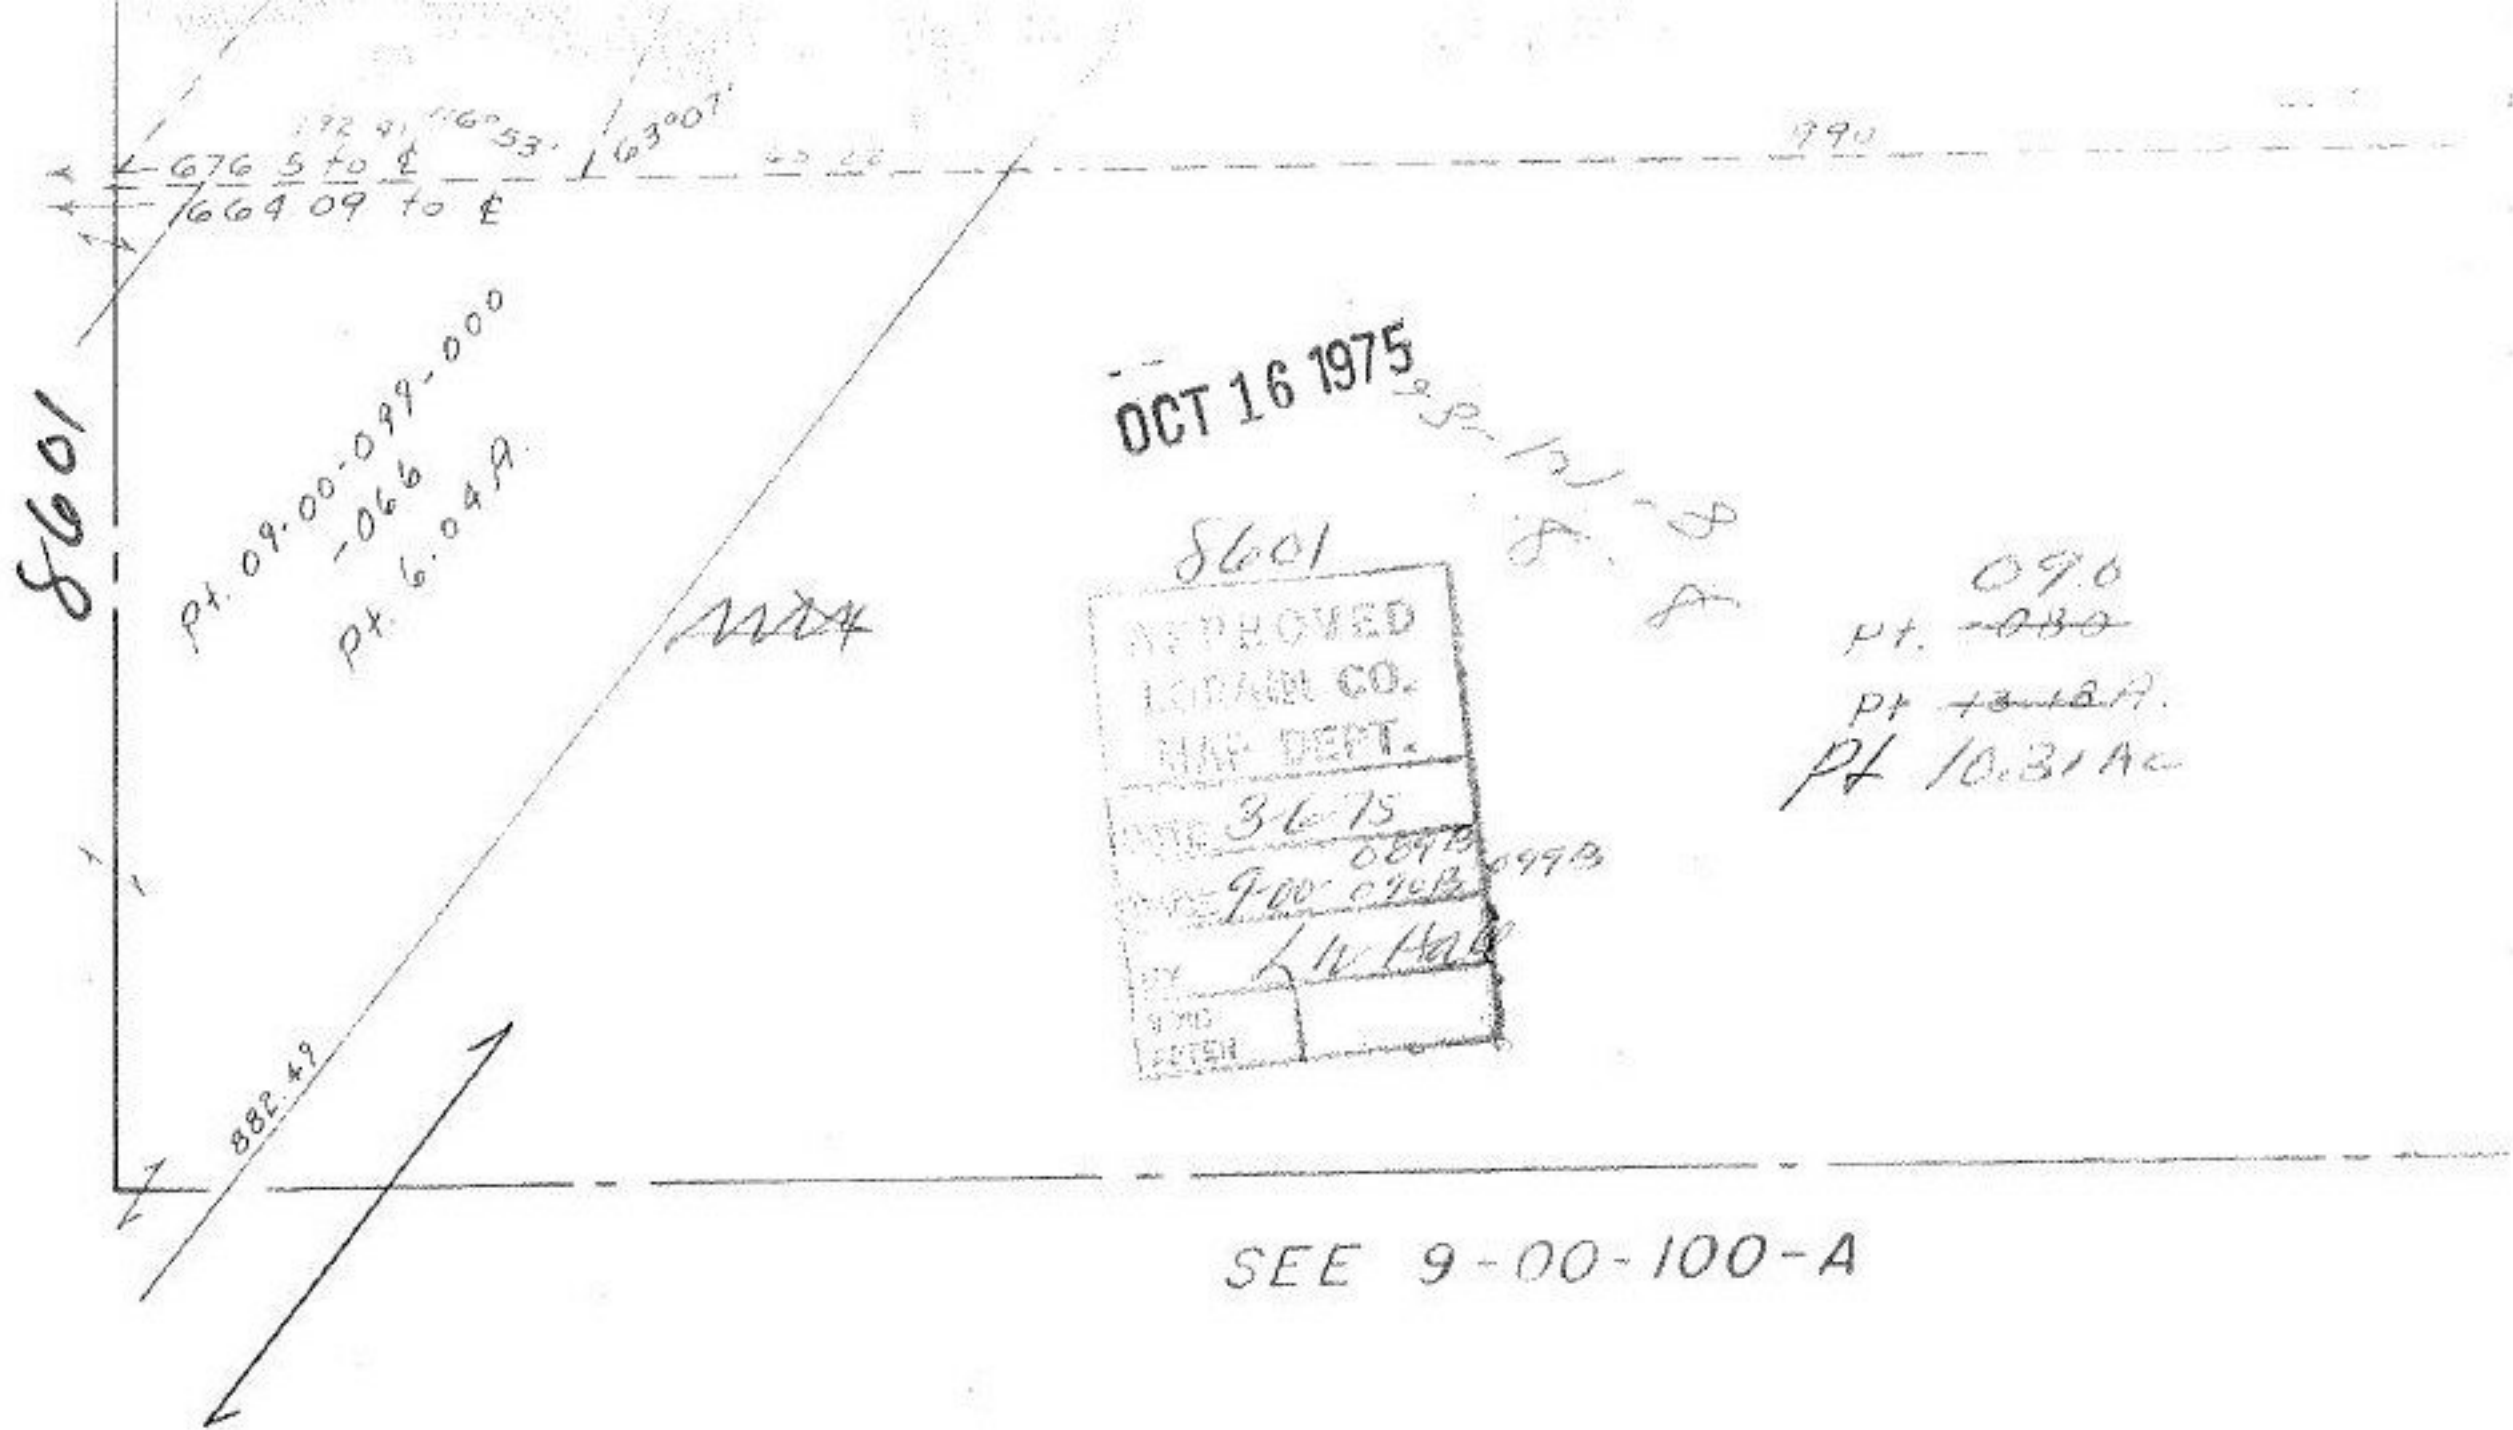

OCT 16 1975

8601  
 APPROVED  
 LORAIN CO.  
 MAP DEPT.  
 DATE 3-6-75  
 BY L. W. HALL  
 900 070B 099B

09.6  
 pt. ~~080~~  
 pt. ~~10.31 Ac~~  
 pt. 10.31 Ac

SEE 9-00-100-A

RUSSIA TWP.