

- 012
8.36A.

JUL 21 1975

OCT 16 1975

OCT 16 1975

8601

APPROVED
FORWARD CO.
STATE DEPT.
3-7-75
BASE 9-00-099-B
BY [Signature]
DATE [Signature]




PT - 024
PT 311A

- 013

4.18 A.

96 A.

SEE 9-00-099-B

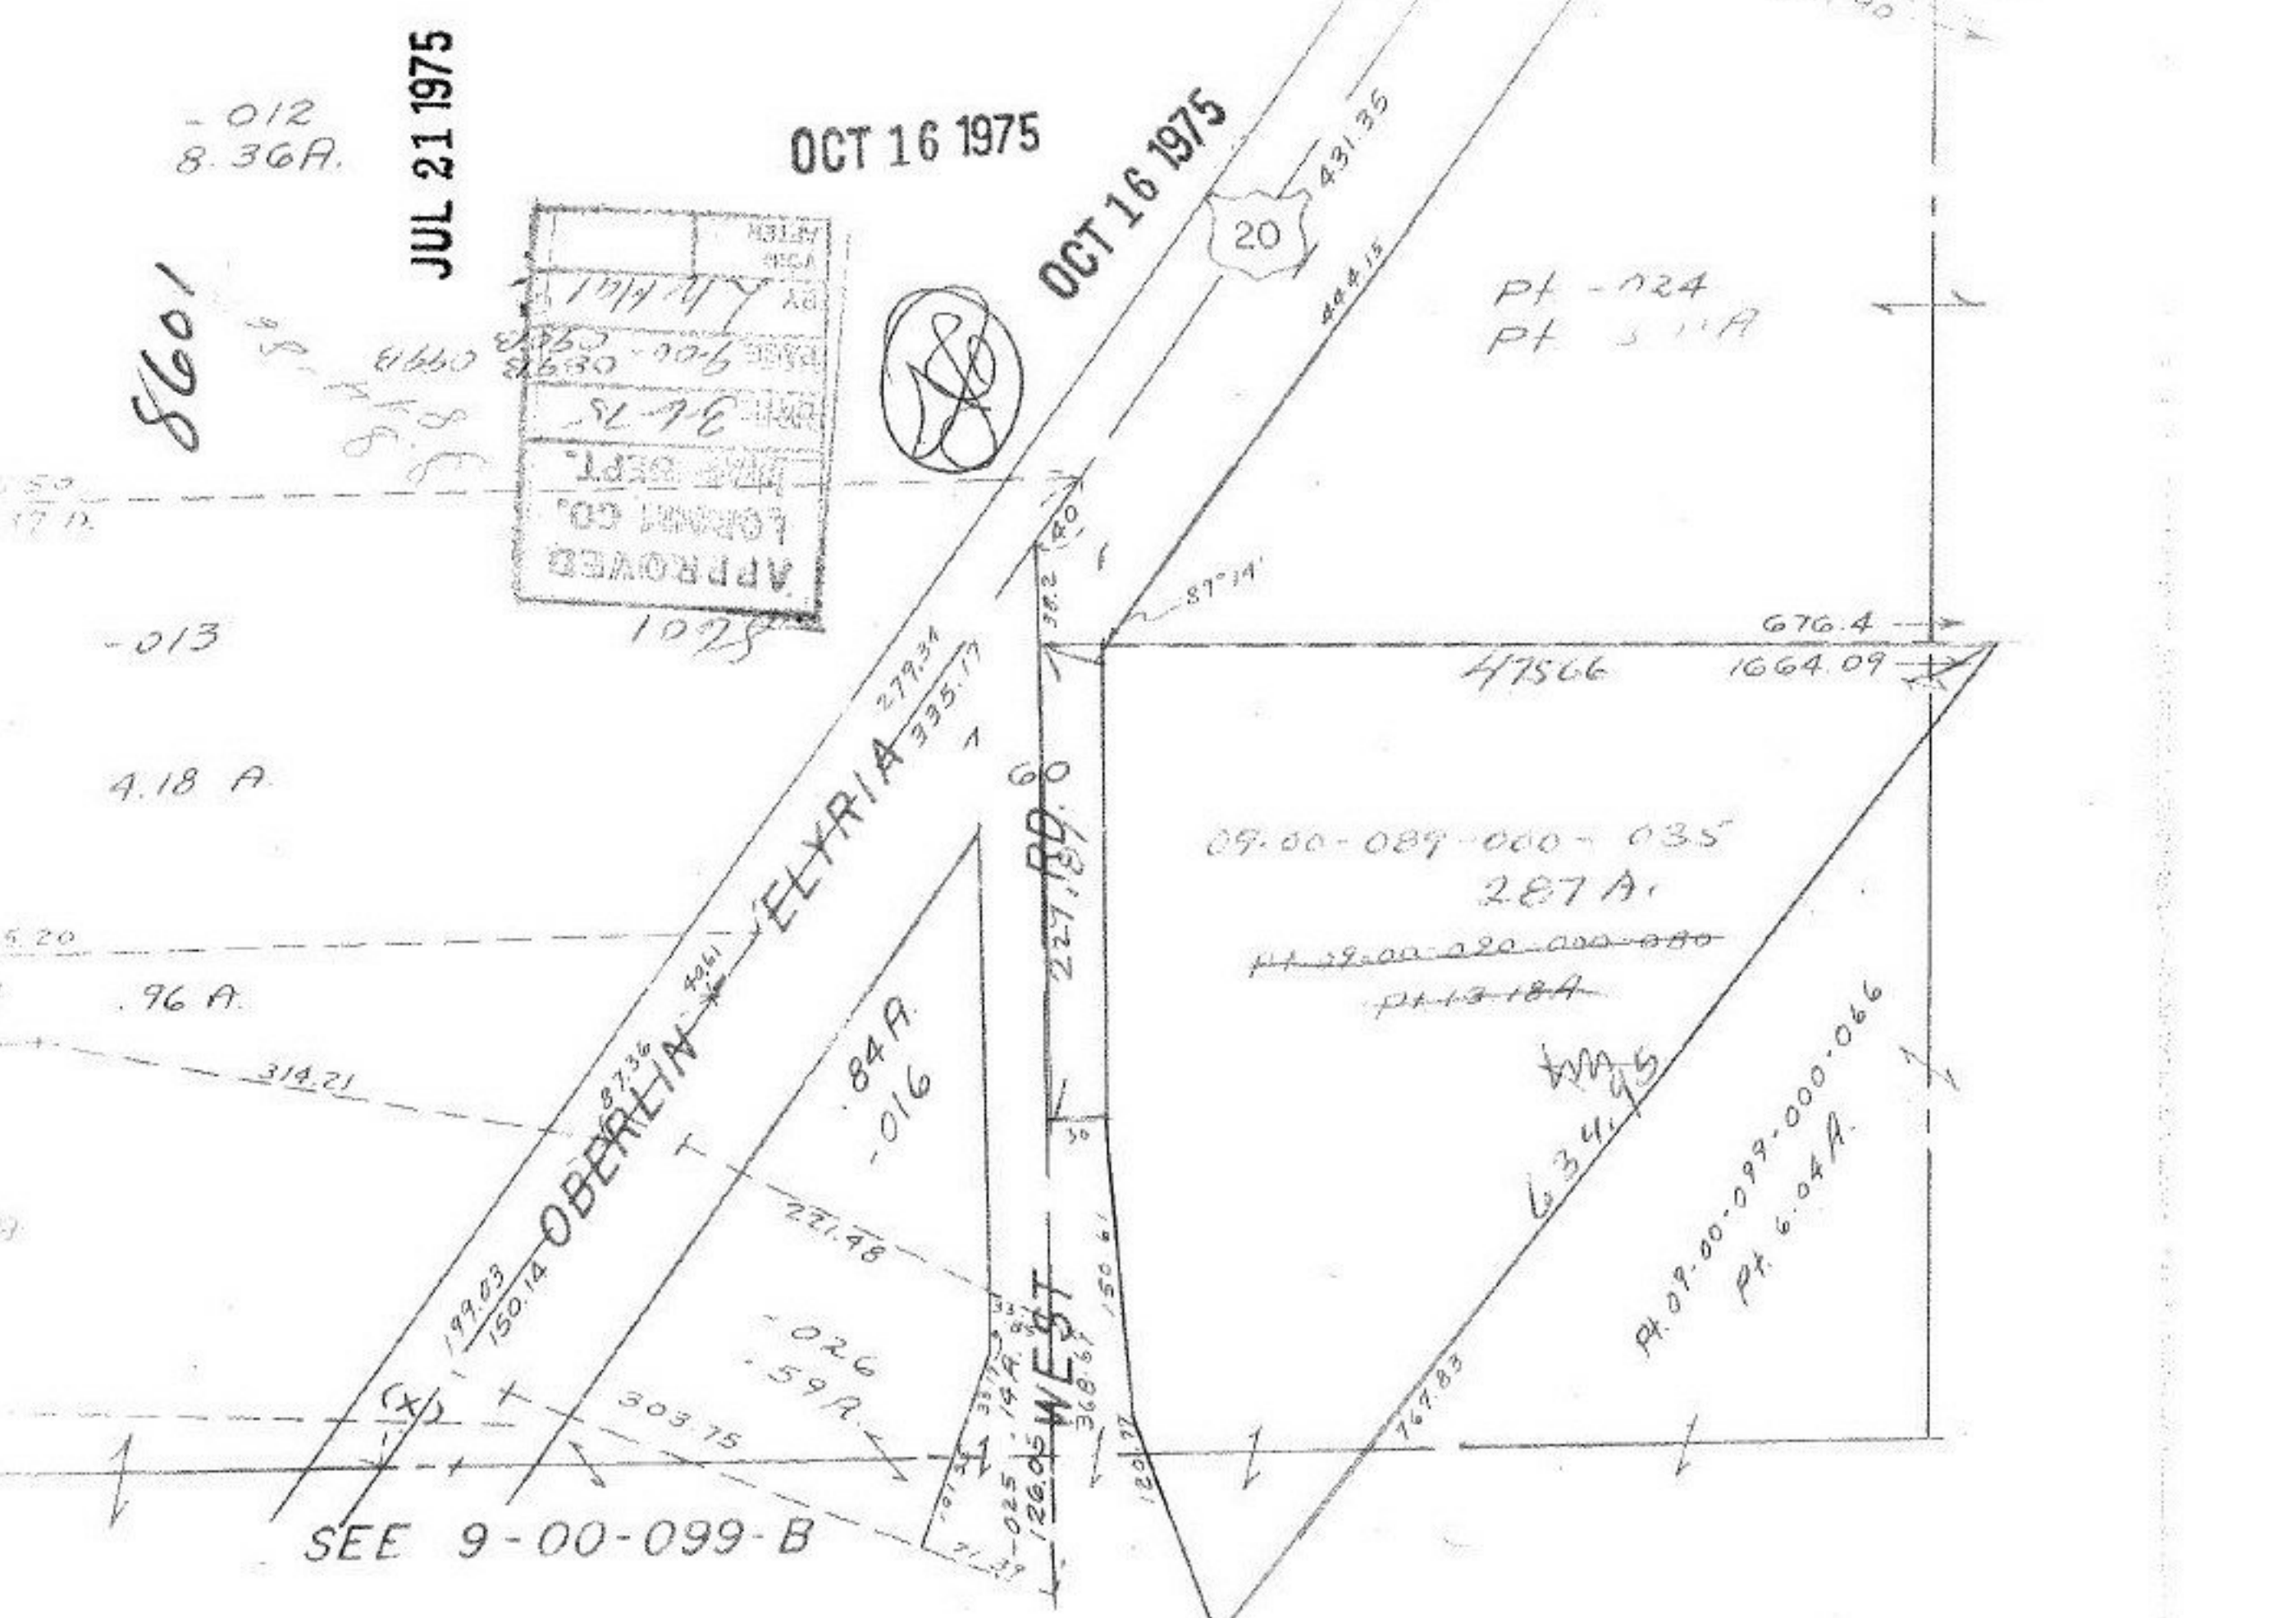

50
17 D.

15.20

13



SEE 9-00-099-B