


8605
8606
8607
8608
MAR 13 1975

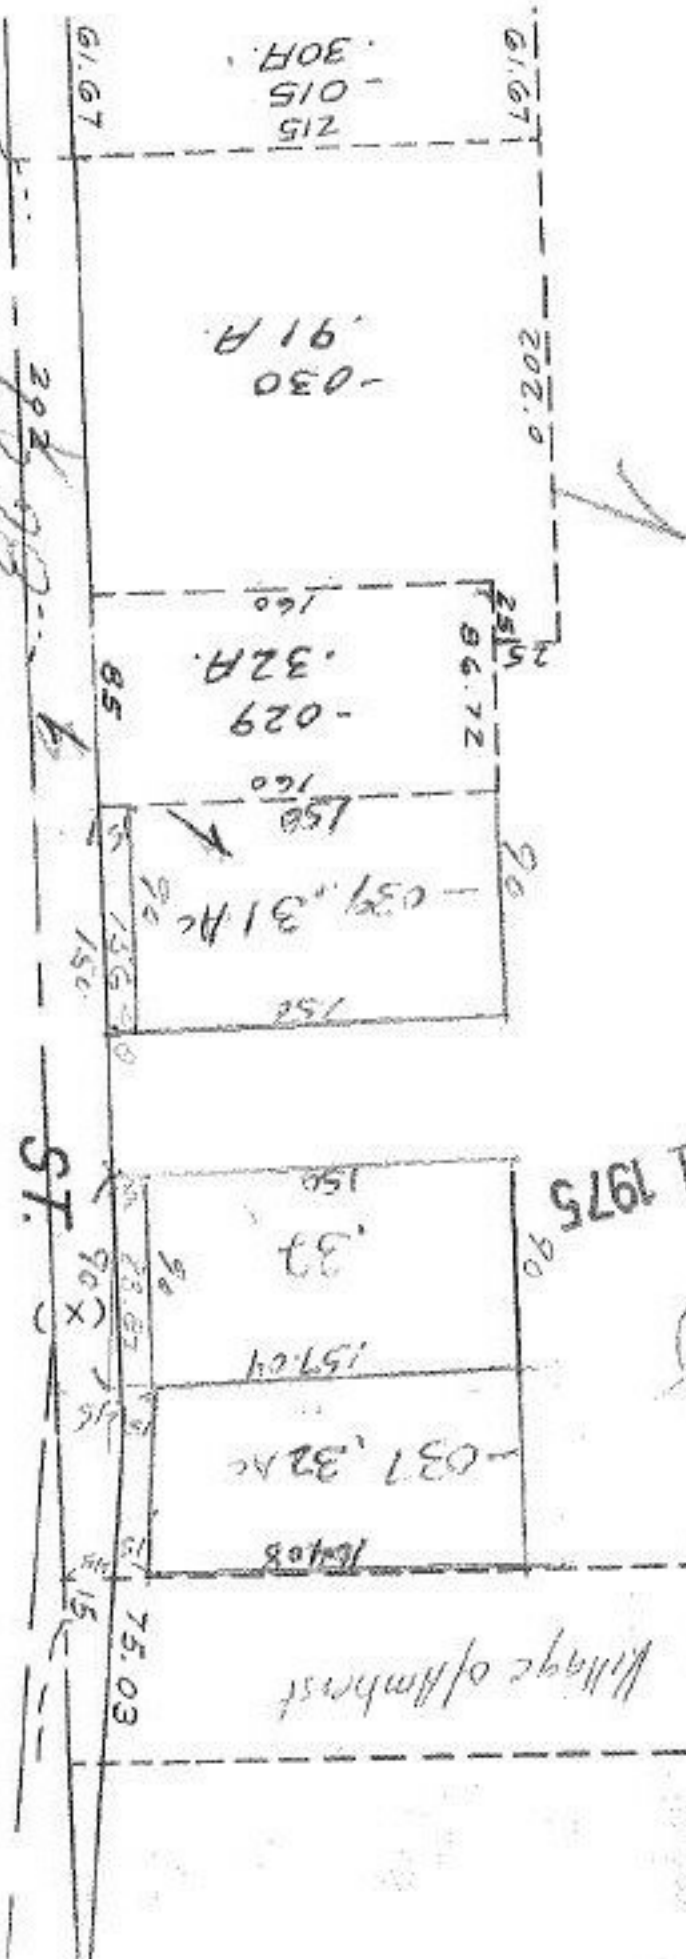

-030
-91A

-029
-32A

-031
-31A

37

-031
-32A

-012
-69A
Village of Amherst

APPROVED
LORAIN CO.
MAP DEPT.
DATE 3-11-75
NO. 5-60-0193
BY L.H. HOO
FIELD

DEC 31 1975

8605
07
06
05

0410
3016 AC



Pt. 031
Pt. 31-61A

475.16