

MAR 13 1975


See 8617
8618
~~8570~~

~~027~~ ✓
~~025~~
~~026~~
~~001~~
49.44A.
~~74.68Ac.~~
75.21Ac.
74.68 ✓


8618
APPROVED
LORAIN CO.
MAP DEPT.
DATE 3-13-75
PAGE 11-00-079A
BY L.W. Hall
VOID AFTER

APPROVED
LORAIN CO.
MAP DEPT.
DATE ~~2-21-75~~
PAGE 11-00-079A
BY ~~Hollist~~
VOID AFTER

R.D.

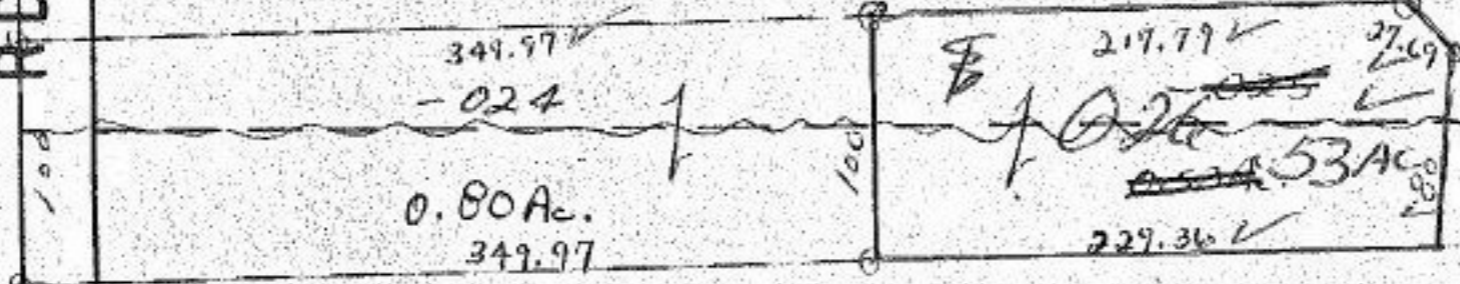


16.01
74.68

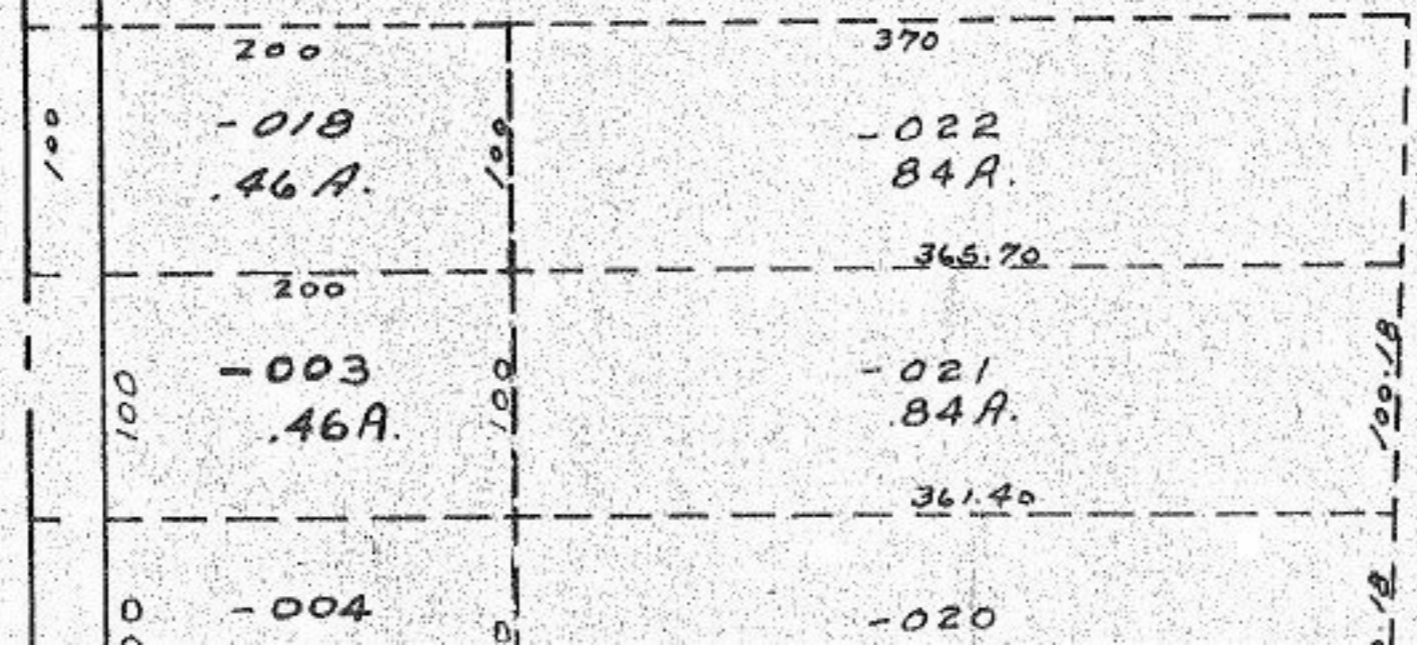

49.44
~~80~~
48.64

-023

Pt 26.57A.

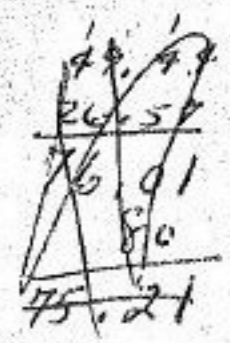

8198

FFR 67 1075