

MAY 28 1975

MAR 24 1975

86443


APPROVED
LORAIN CO.
MAP DEPT.

DATE 3-21-75

PAGE 10-00-004A

BY L.W. Hall

-115
1.41A.

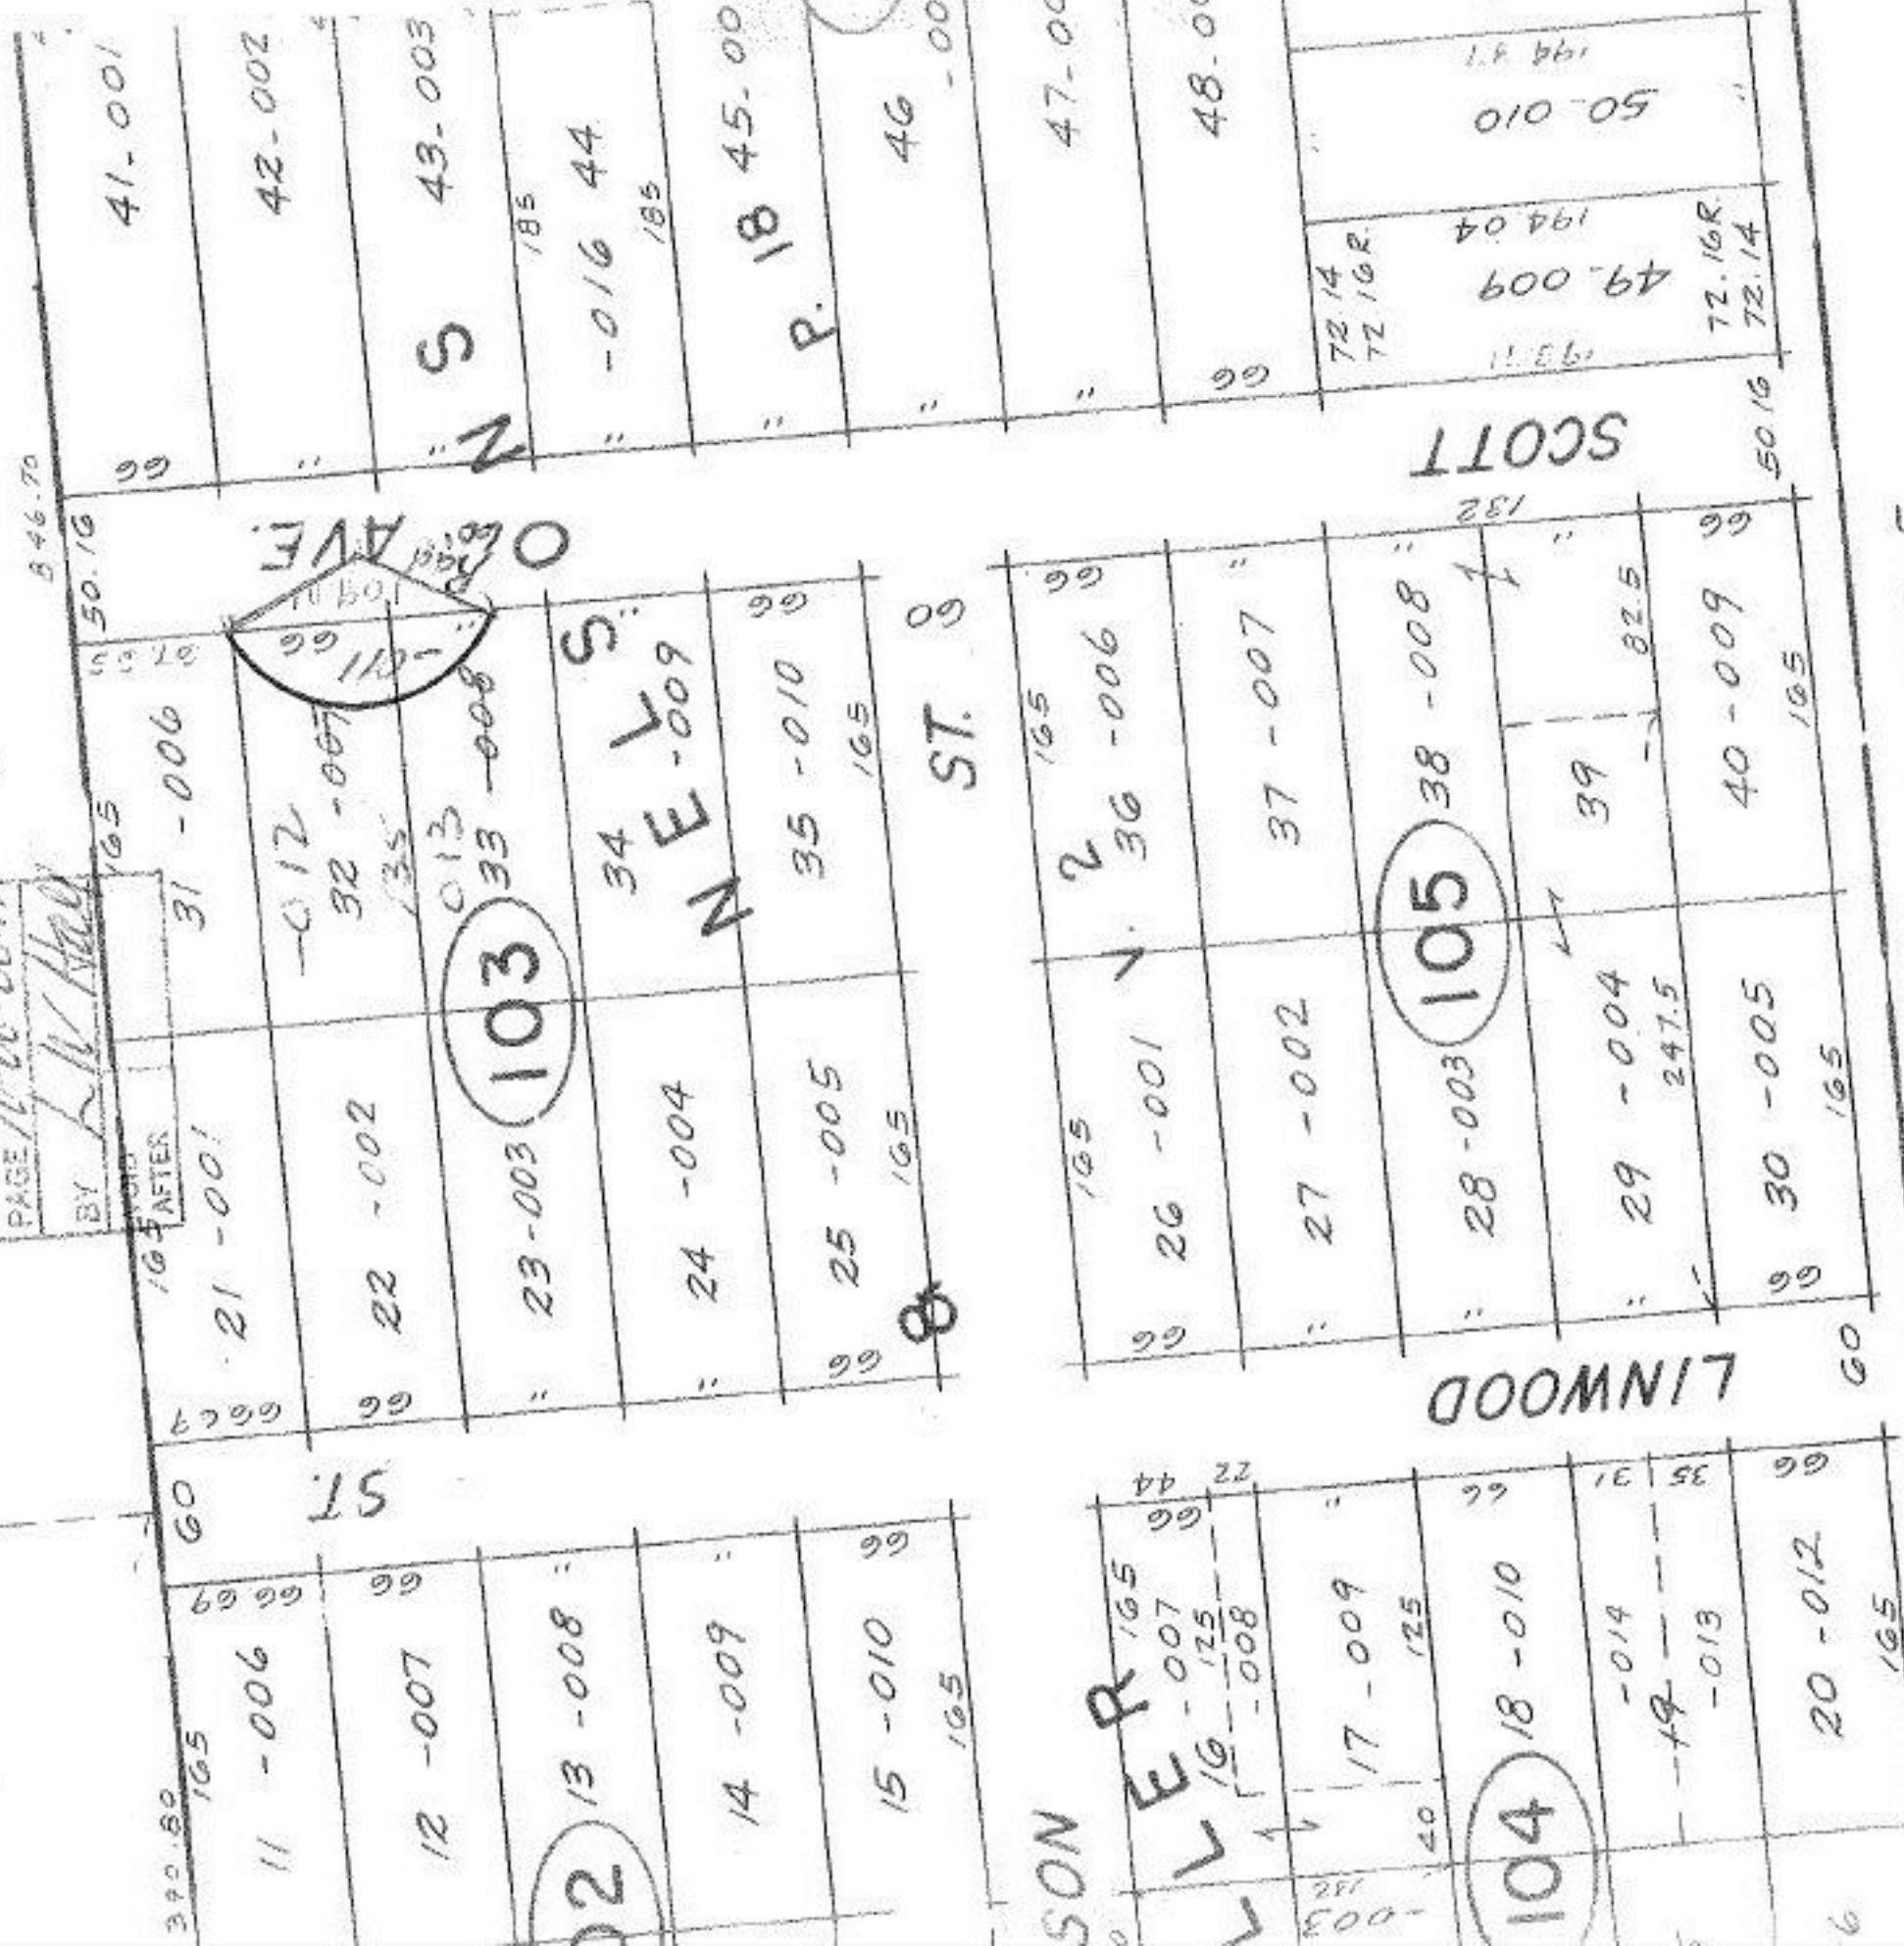

SEE 10-00-004-E

ER