

11-00-00 A


8654

579.82

MAR 28 1975

709.66

~~029~~
H. 50A.
033
10.75Ac

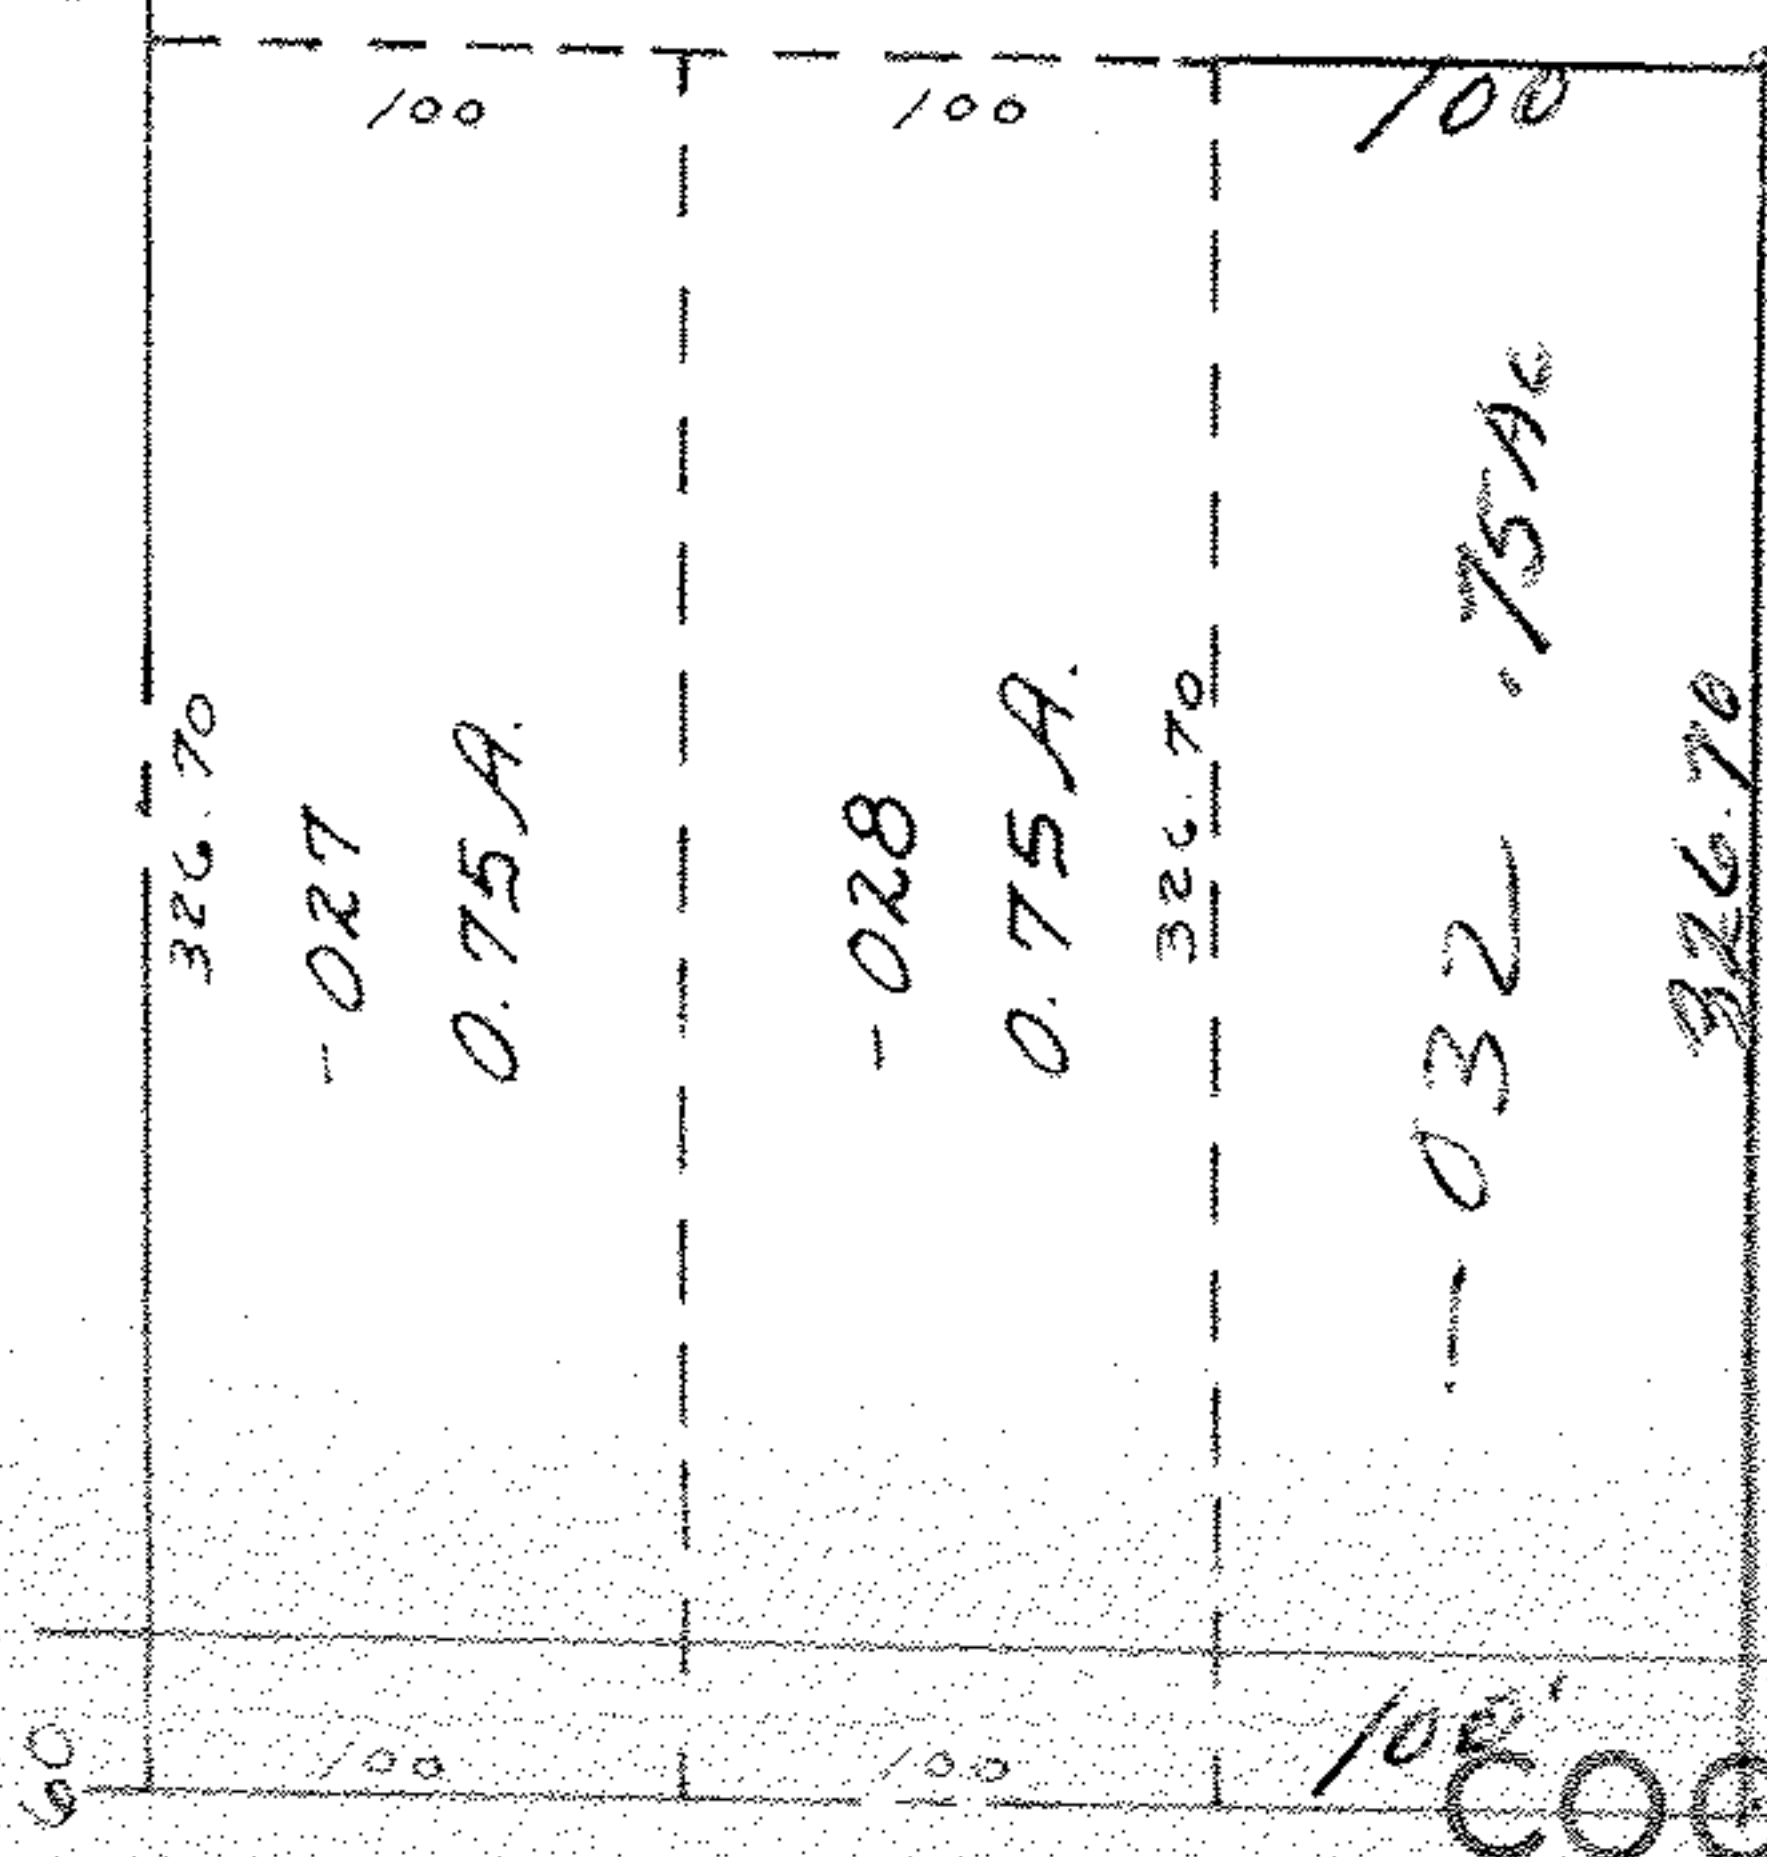

8654

APPROVED	
LORAIN CO.	
MAP DEPT.	
DATE	3-25-75
PAGE	11-00-008A
BY	LW Hall
VOID AFTER	

S.S. 8654-86

60 100 100 100 COOLEY 383.67

MAY 23 1975

SEE



REVISED

W 1/2 LOT

11-00-008-A