
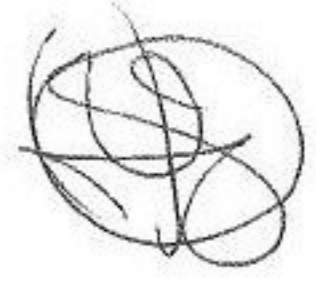


8655

JUL 18 1975

Pt. - 024  
Pt. 37A

634.95  
128.72  
506.23

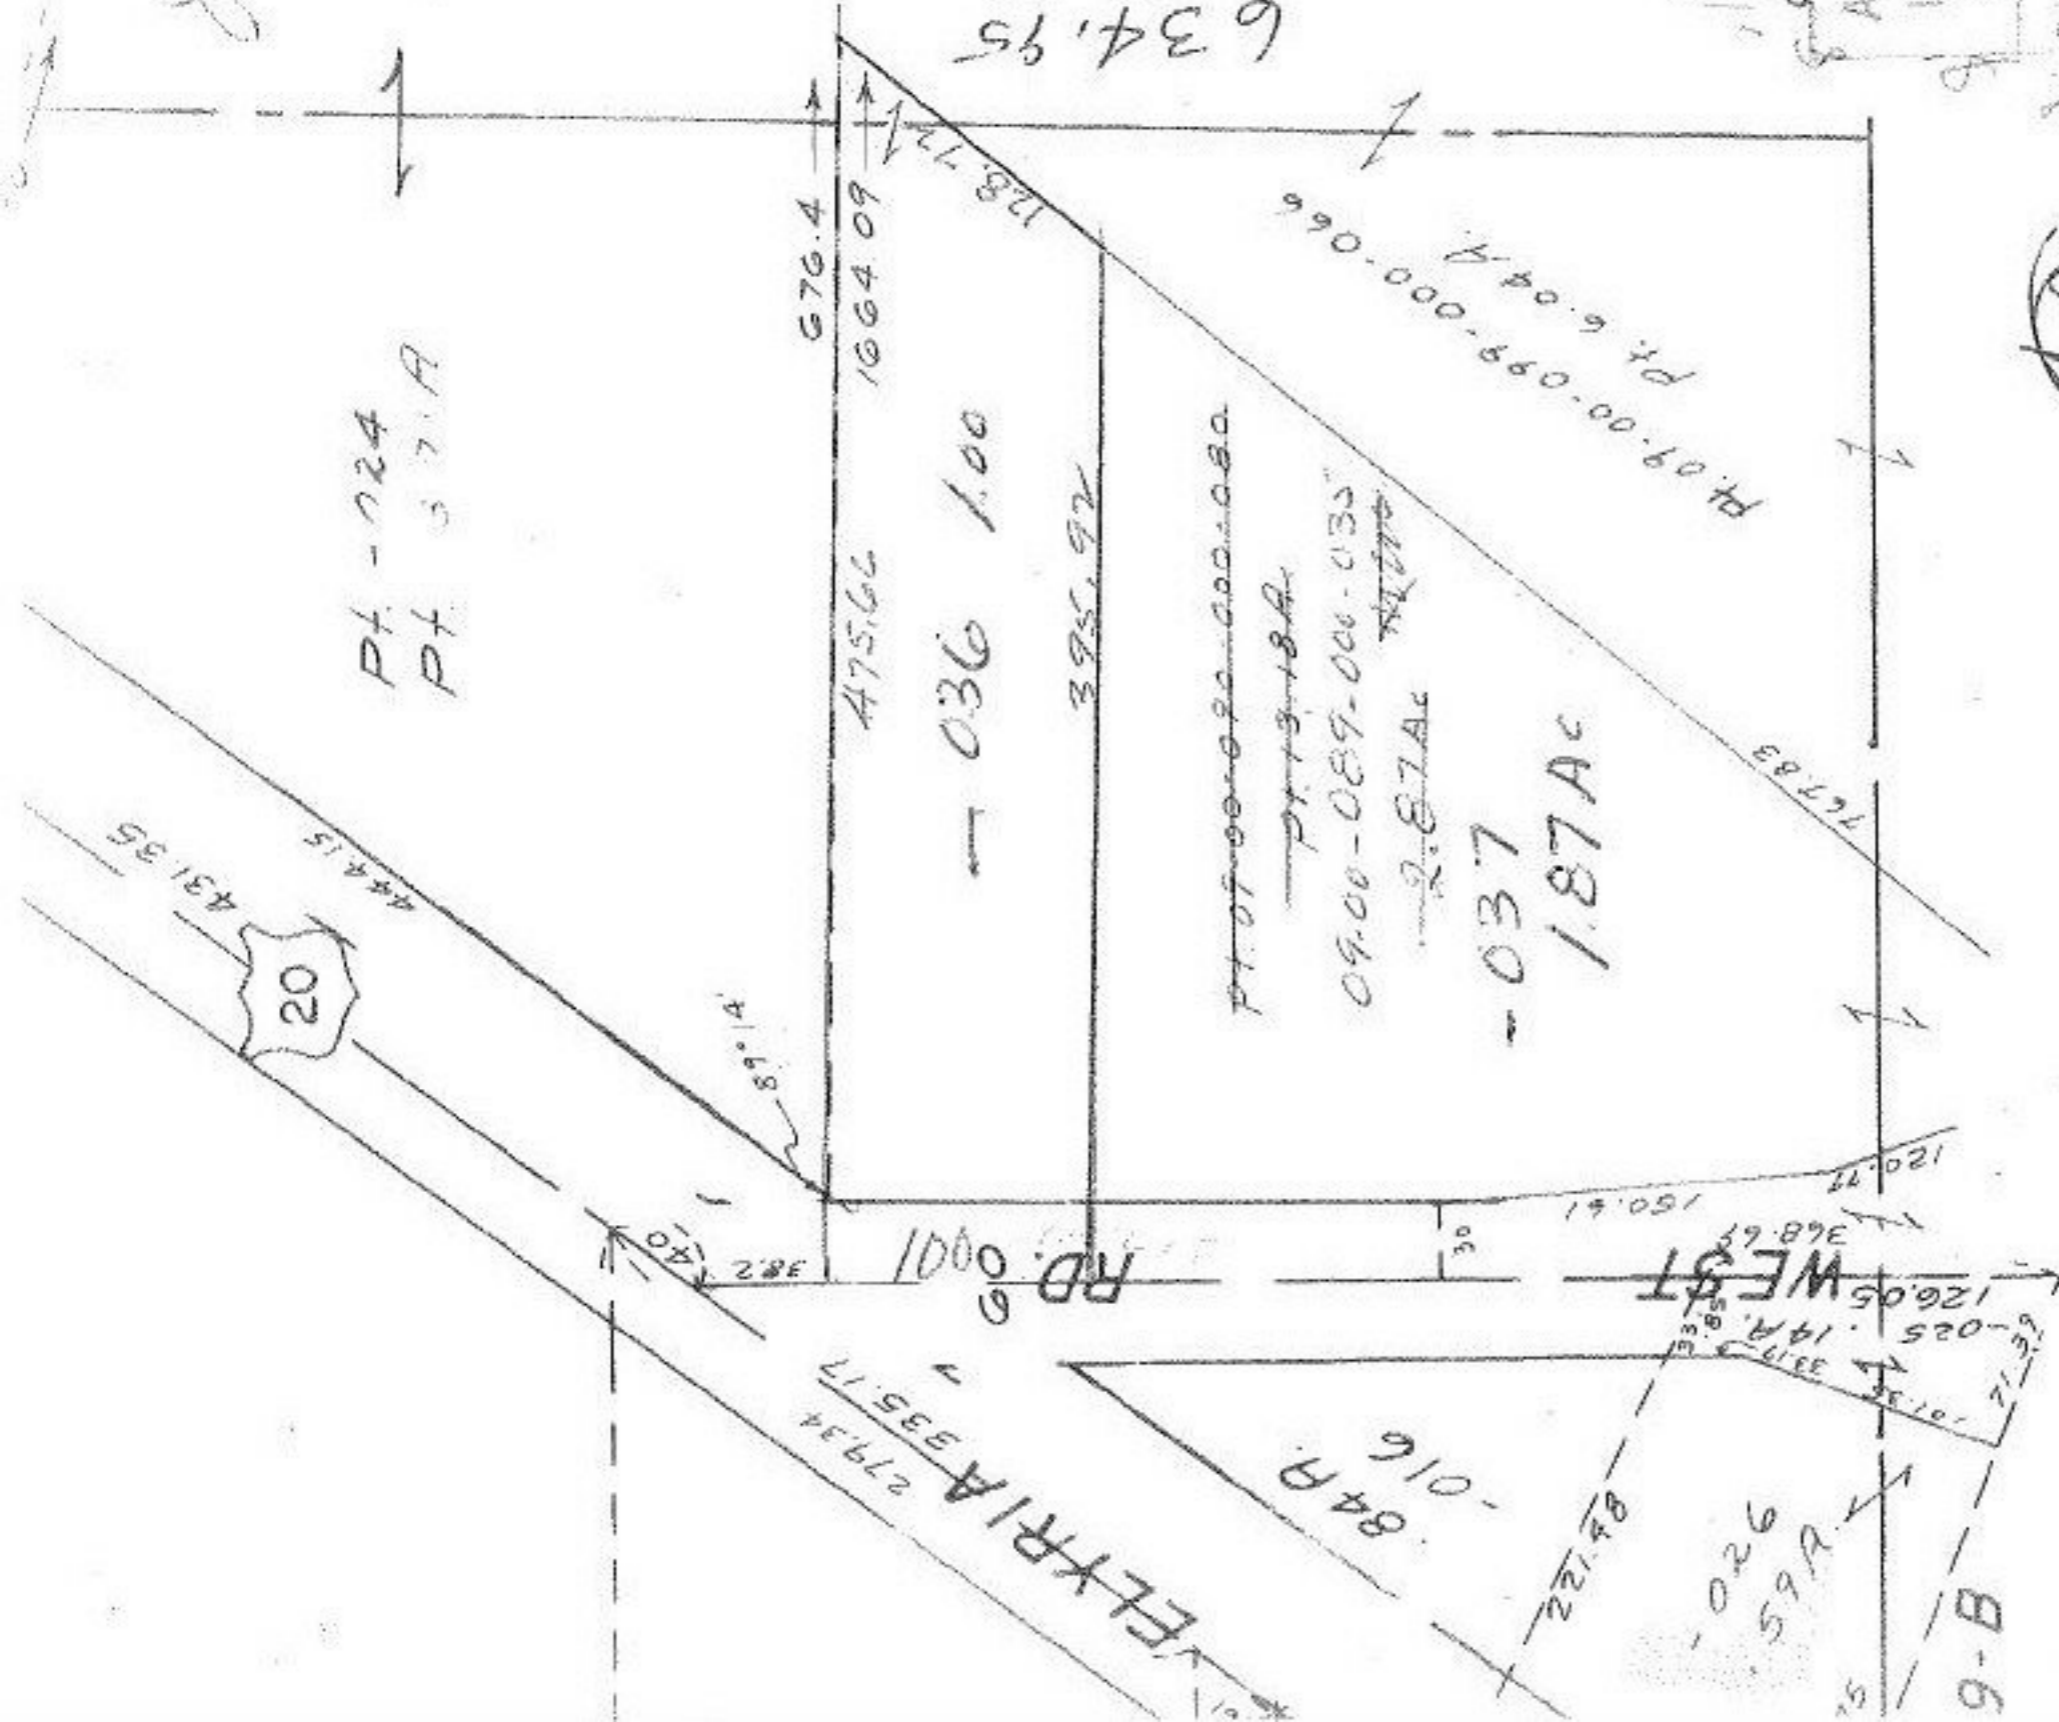

8655

APPROVED
LORAIN CO.
MAP DEPT.
DATE 7-17-75
PL. 09-00-089B
BY L.W. HUBB

OCT 16 1975