

89°08'


EMMONS

2639.01

(50)

Jlass

APR 3 1975

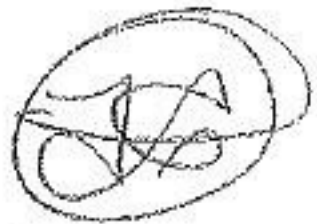

MAY 22 1975

~~001~~
100.00 A.

Jlass

APPROVED
LORAIN CO.
MAP DEPT.
DATE 4-2-75
USE 1214
BY L.V. Hall
VOID AFTER

D 8 10 15 8/5

12

12.12
8.12
30.25
10.25
20.25

399
67.58
134.02

007

2640.03

12.12 Ac

008

~~002~~ 2640.18
30.00 A.

7.88 Ac

006

2640.15

10.00 Ac

004
23.71 A.

005

1481

6.29 A.

556.60

289.60

12.12

14
22.12

30.00
22.12
788

27908

299
185
309.91
164
198
134.02
200

1846

167

200

100

9097

996

70

90