

135

Edo

APR 2 1975

SEE 4-00-007-A


53.13
11.68
1781

MAY 2 1975

46.50
3.50
50.00
1.00
61.00

8660

APPROVED BY	51-027
LORAM CO.	150.76
MAP DEPT.	52-028
DATE	4-2-75
PAGE	4-00-006-D
NO.	
VOID	

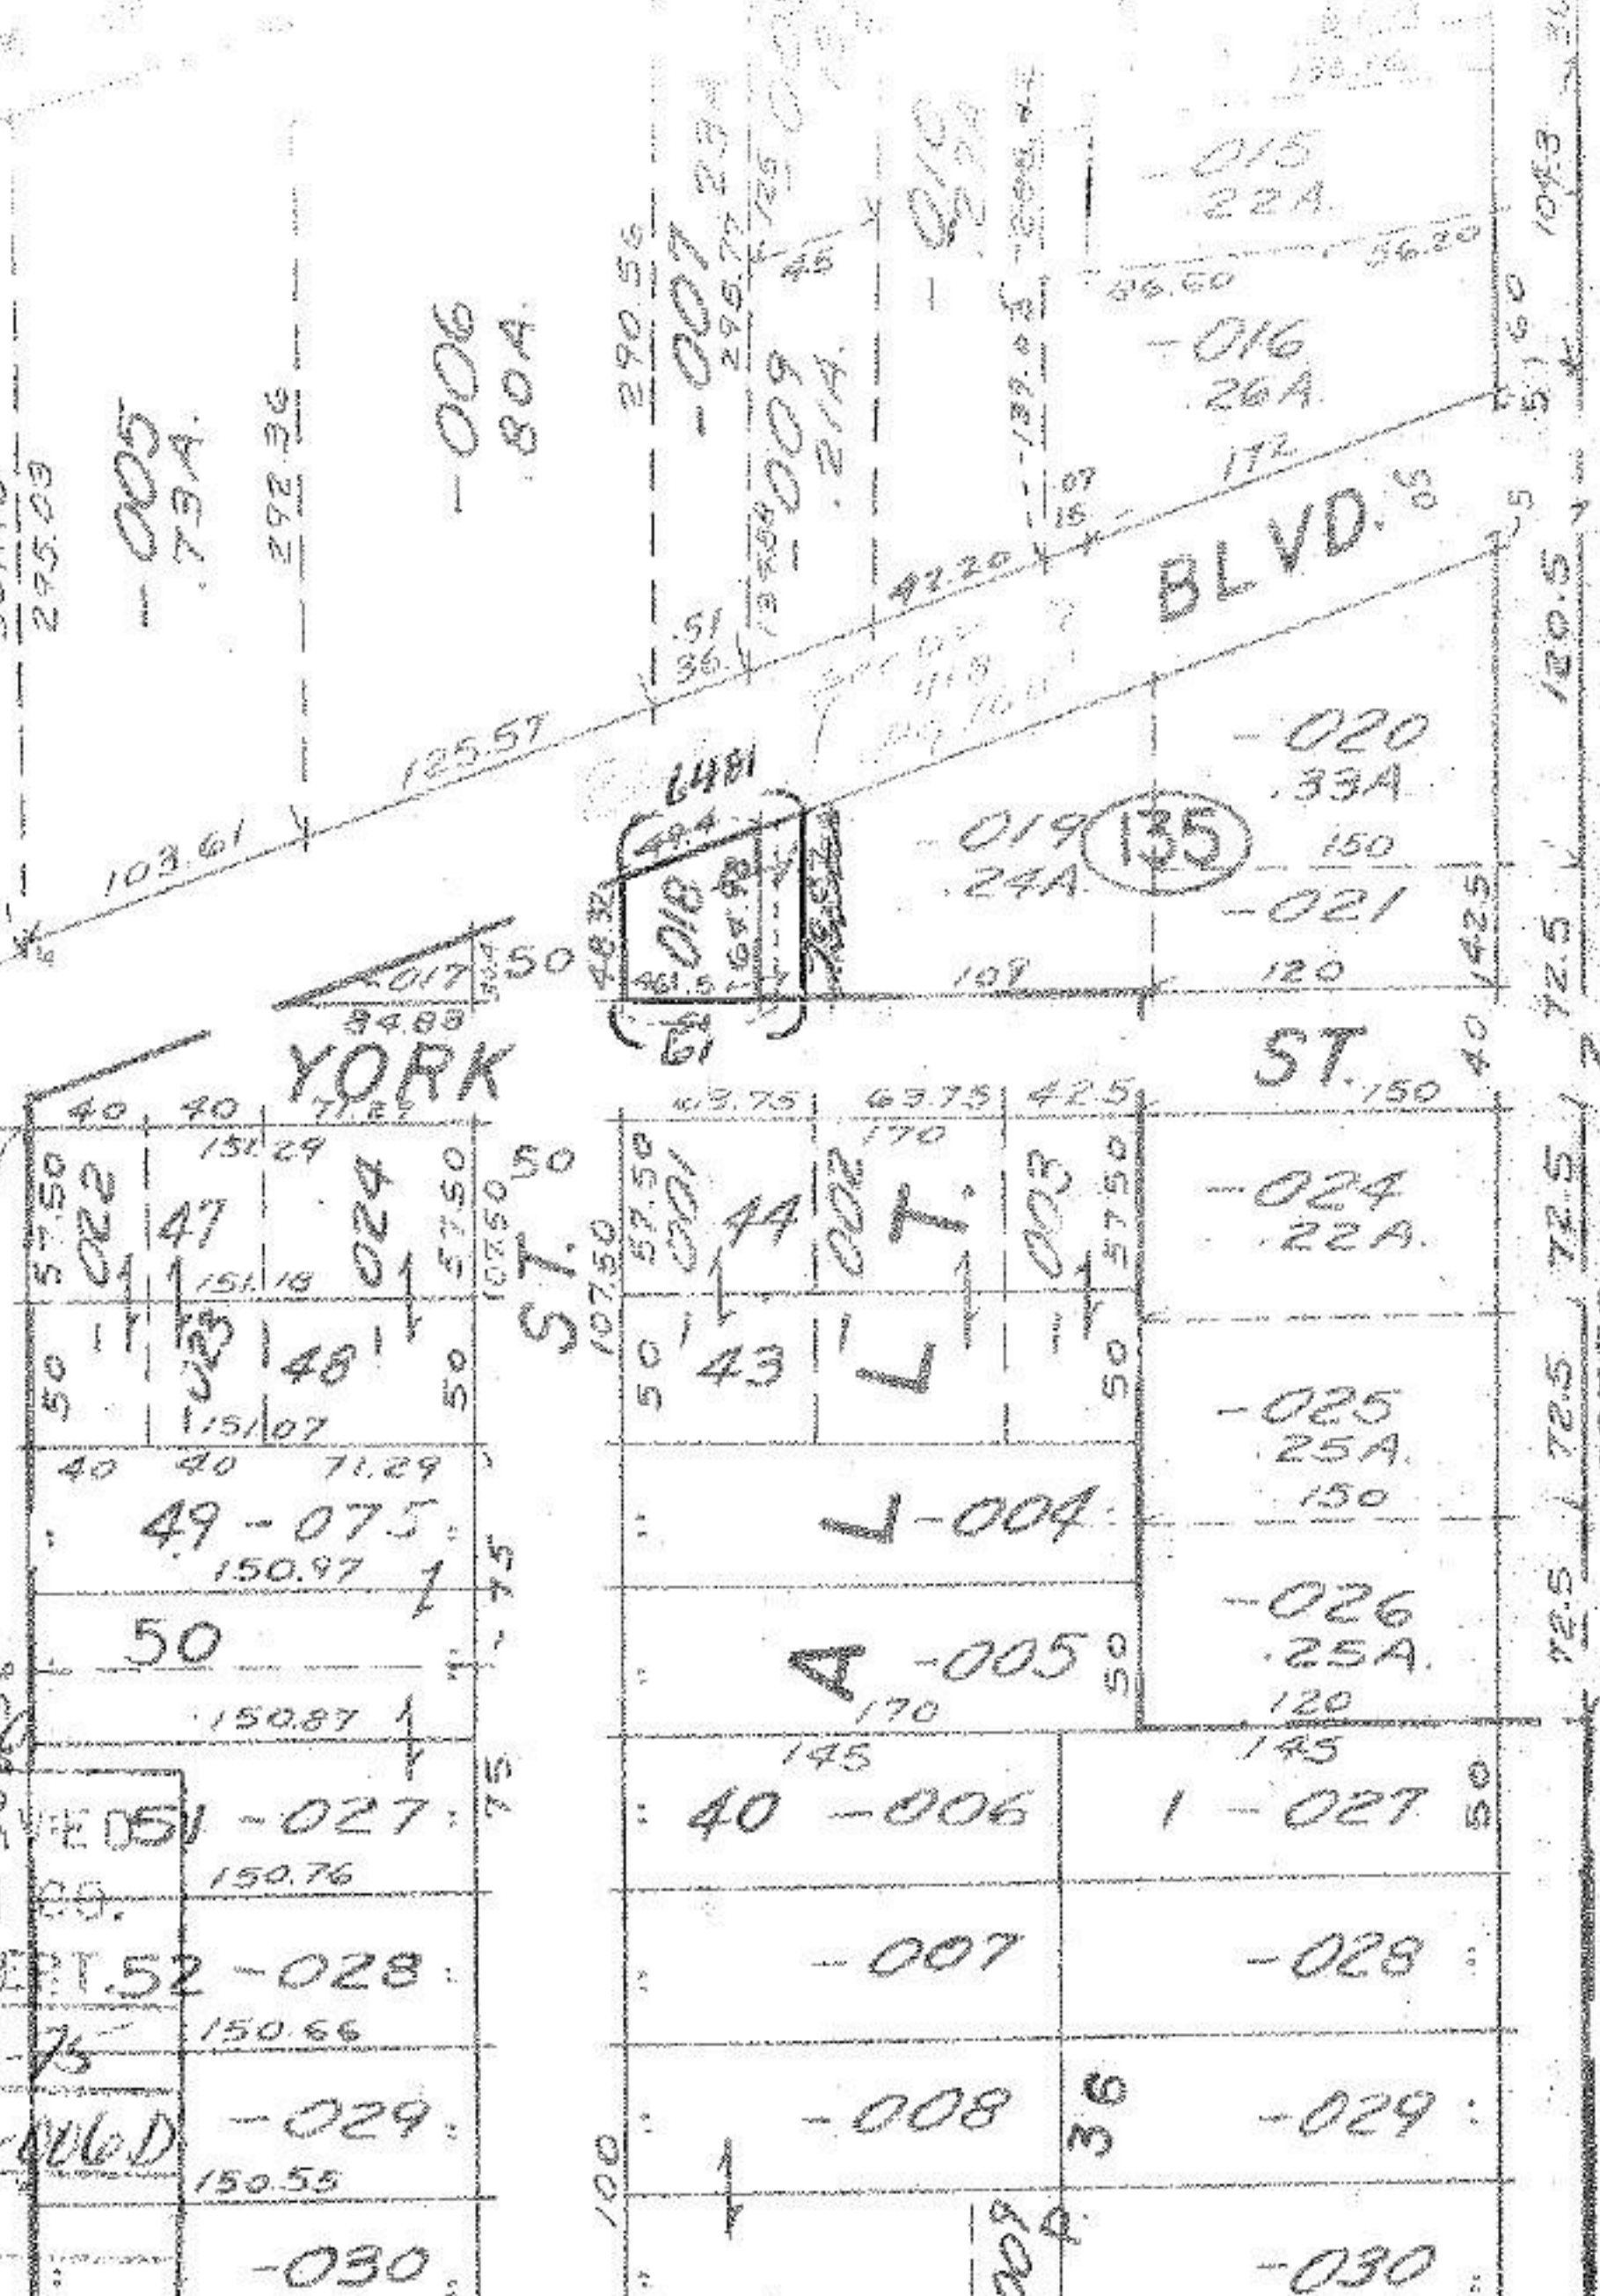

BLVD.

YORK

ST.

018
019

135