


86 84



APR 14 1975


MAY 2 1975

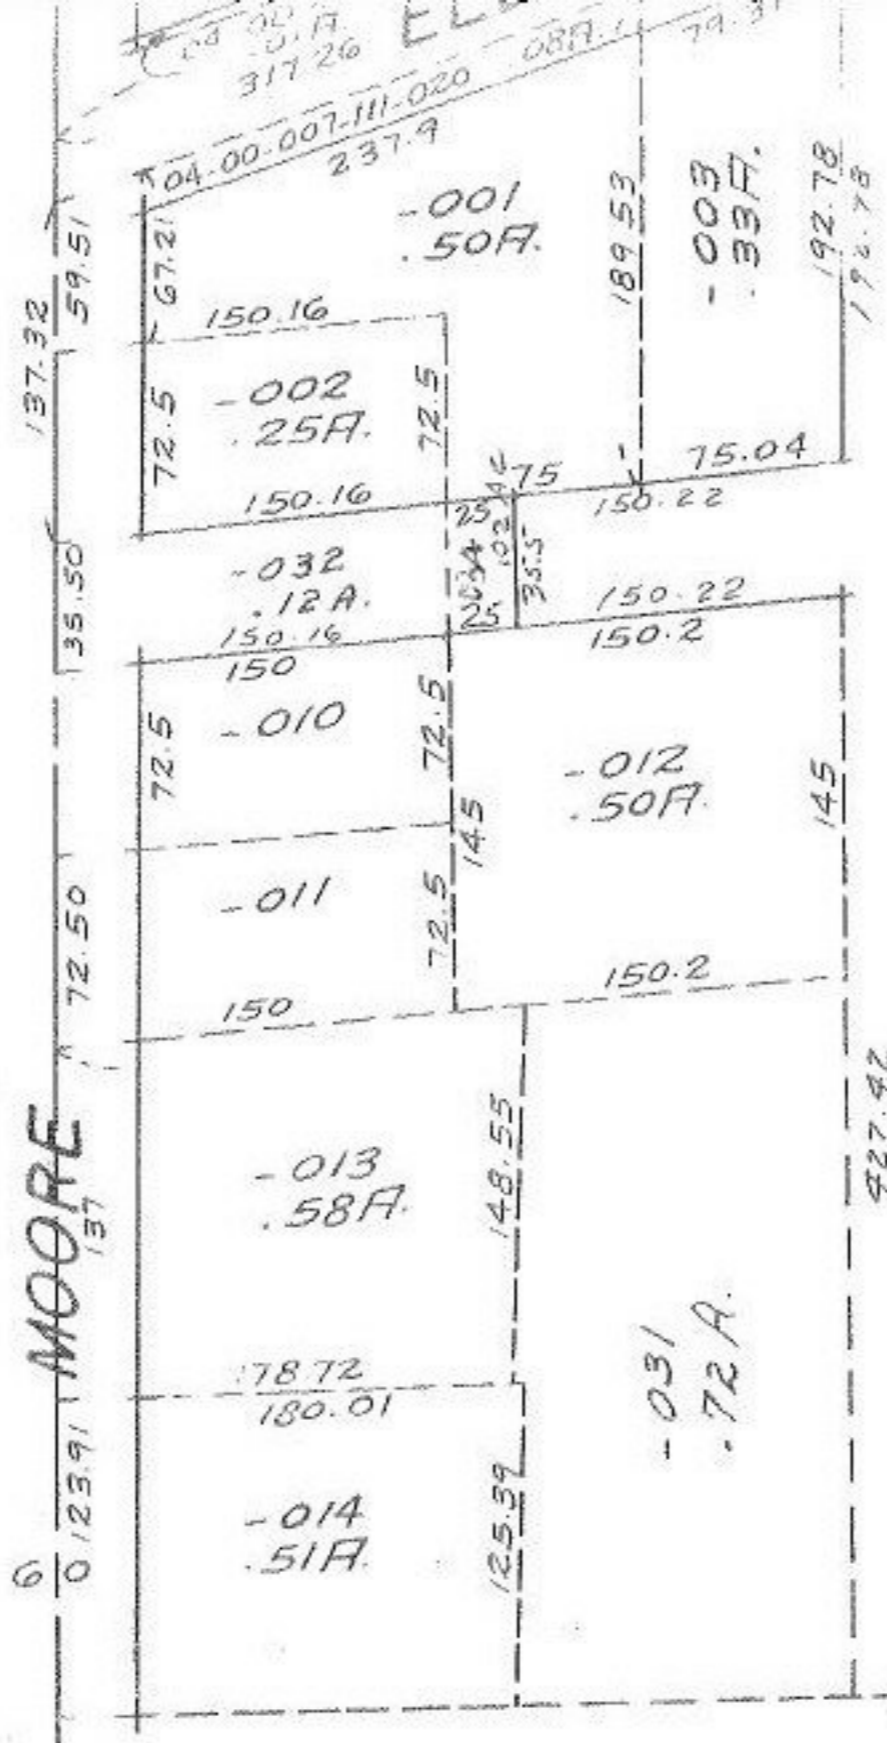

035
~~033~~
8-12-A
8-10-A

86 84

APPROVED
LORAIN CO.
MAP DEPT.
DATE 4-8-75
PAGE 4-00-007A
BY L W Hall
VOID
AFTER

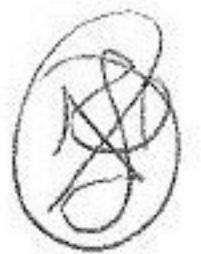

7-798-18

555.14

SEE 4-00

Copyright 1963
REV. 8-21-74

4-00-007-A

AVON LAKE VILLA

SCALE: 1" = 100'