

-050  
5.00 A.

309.88

91.39

-041  
.70

303.40

-044  
.70 A.

303.40

-048  
.70 A.

303.40 ✓

-054

5.50 Ac

~~-049~~  
7.00 A.

86.89

-053 .70 Ac

303.40

-040  
.80 A.

350

-043  
.80 A.

350

-046  
.80 A.

350

-052 .80 Ac

350


-029  
19.00 A.

*S. S. S.*

MAY 22 1975

*8689*

APPROVED
LORAIN CO.
MAP DEPT.
DATE 4-14-75
PAGE 11-00-007B
BY <i>R. W. Hall</i>
VOID AFTER

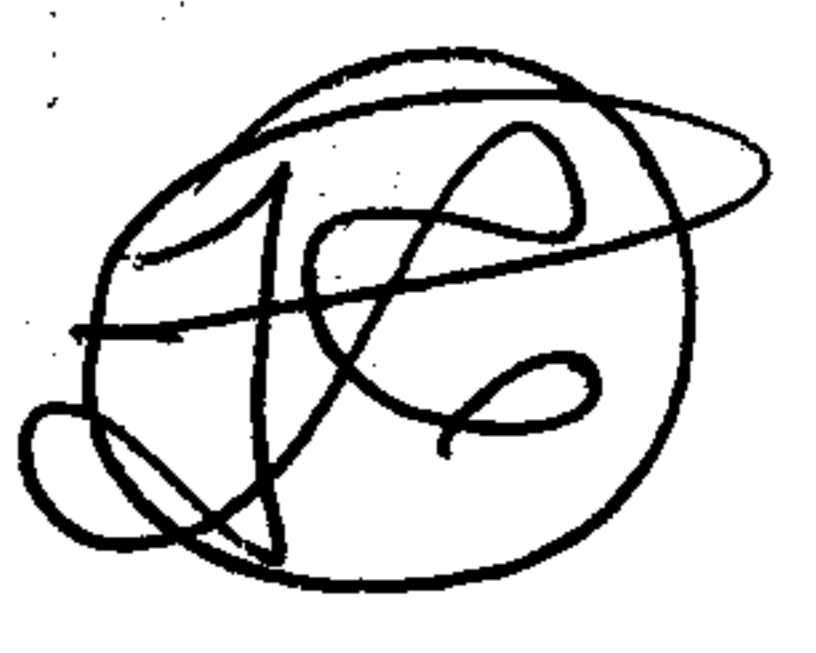

APR 16 1975

8689

HAWKE

16072070