

SEE 2-02-010-B

2305.7

Amherst City Corp. Line

8695

026

34.99 Ac

~~P4-024~~

~~P4-35.62A~~

APR 23 1975

8695

102

DEC 31 1975


*[Handwritten signature]*

8695

APPROVED LORAIN CO. MAP DEPT.
DATE 4-15-75
PAGE 2-02-001B
BY L W Hall
VOID AFTER

*[Handwritten notes: 8695, 8695]*

142.33

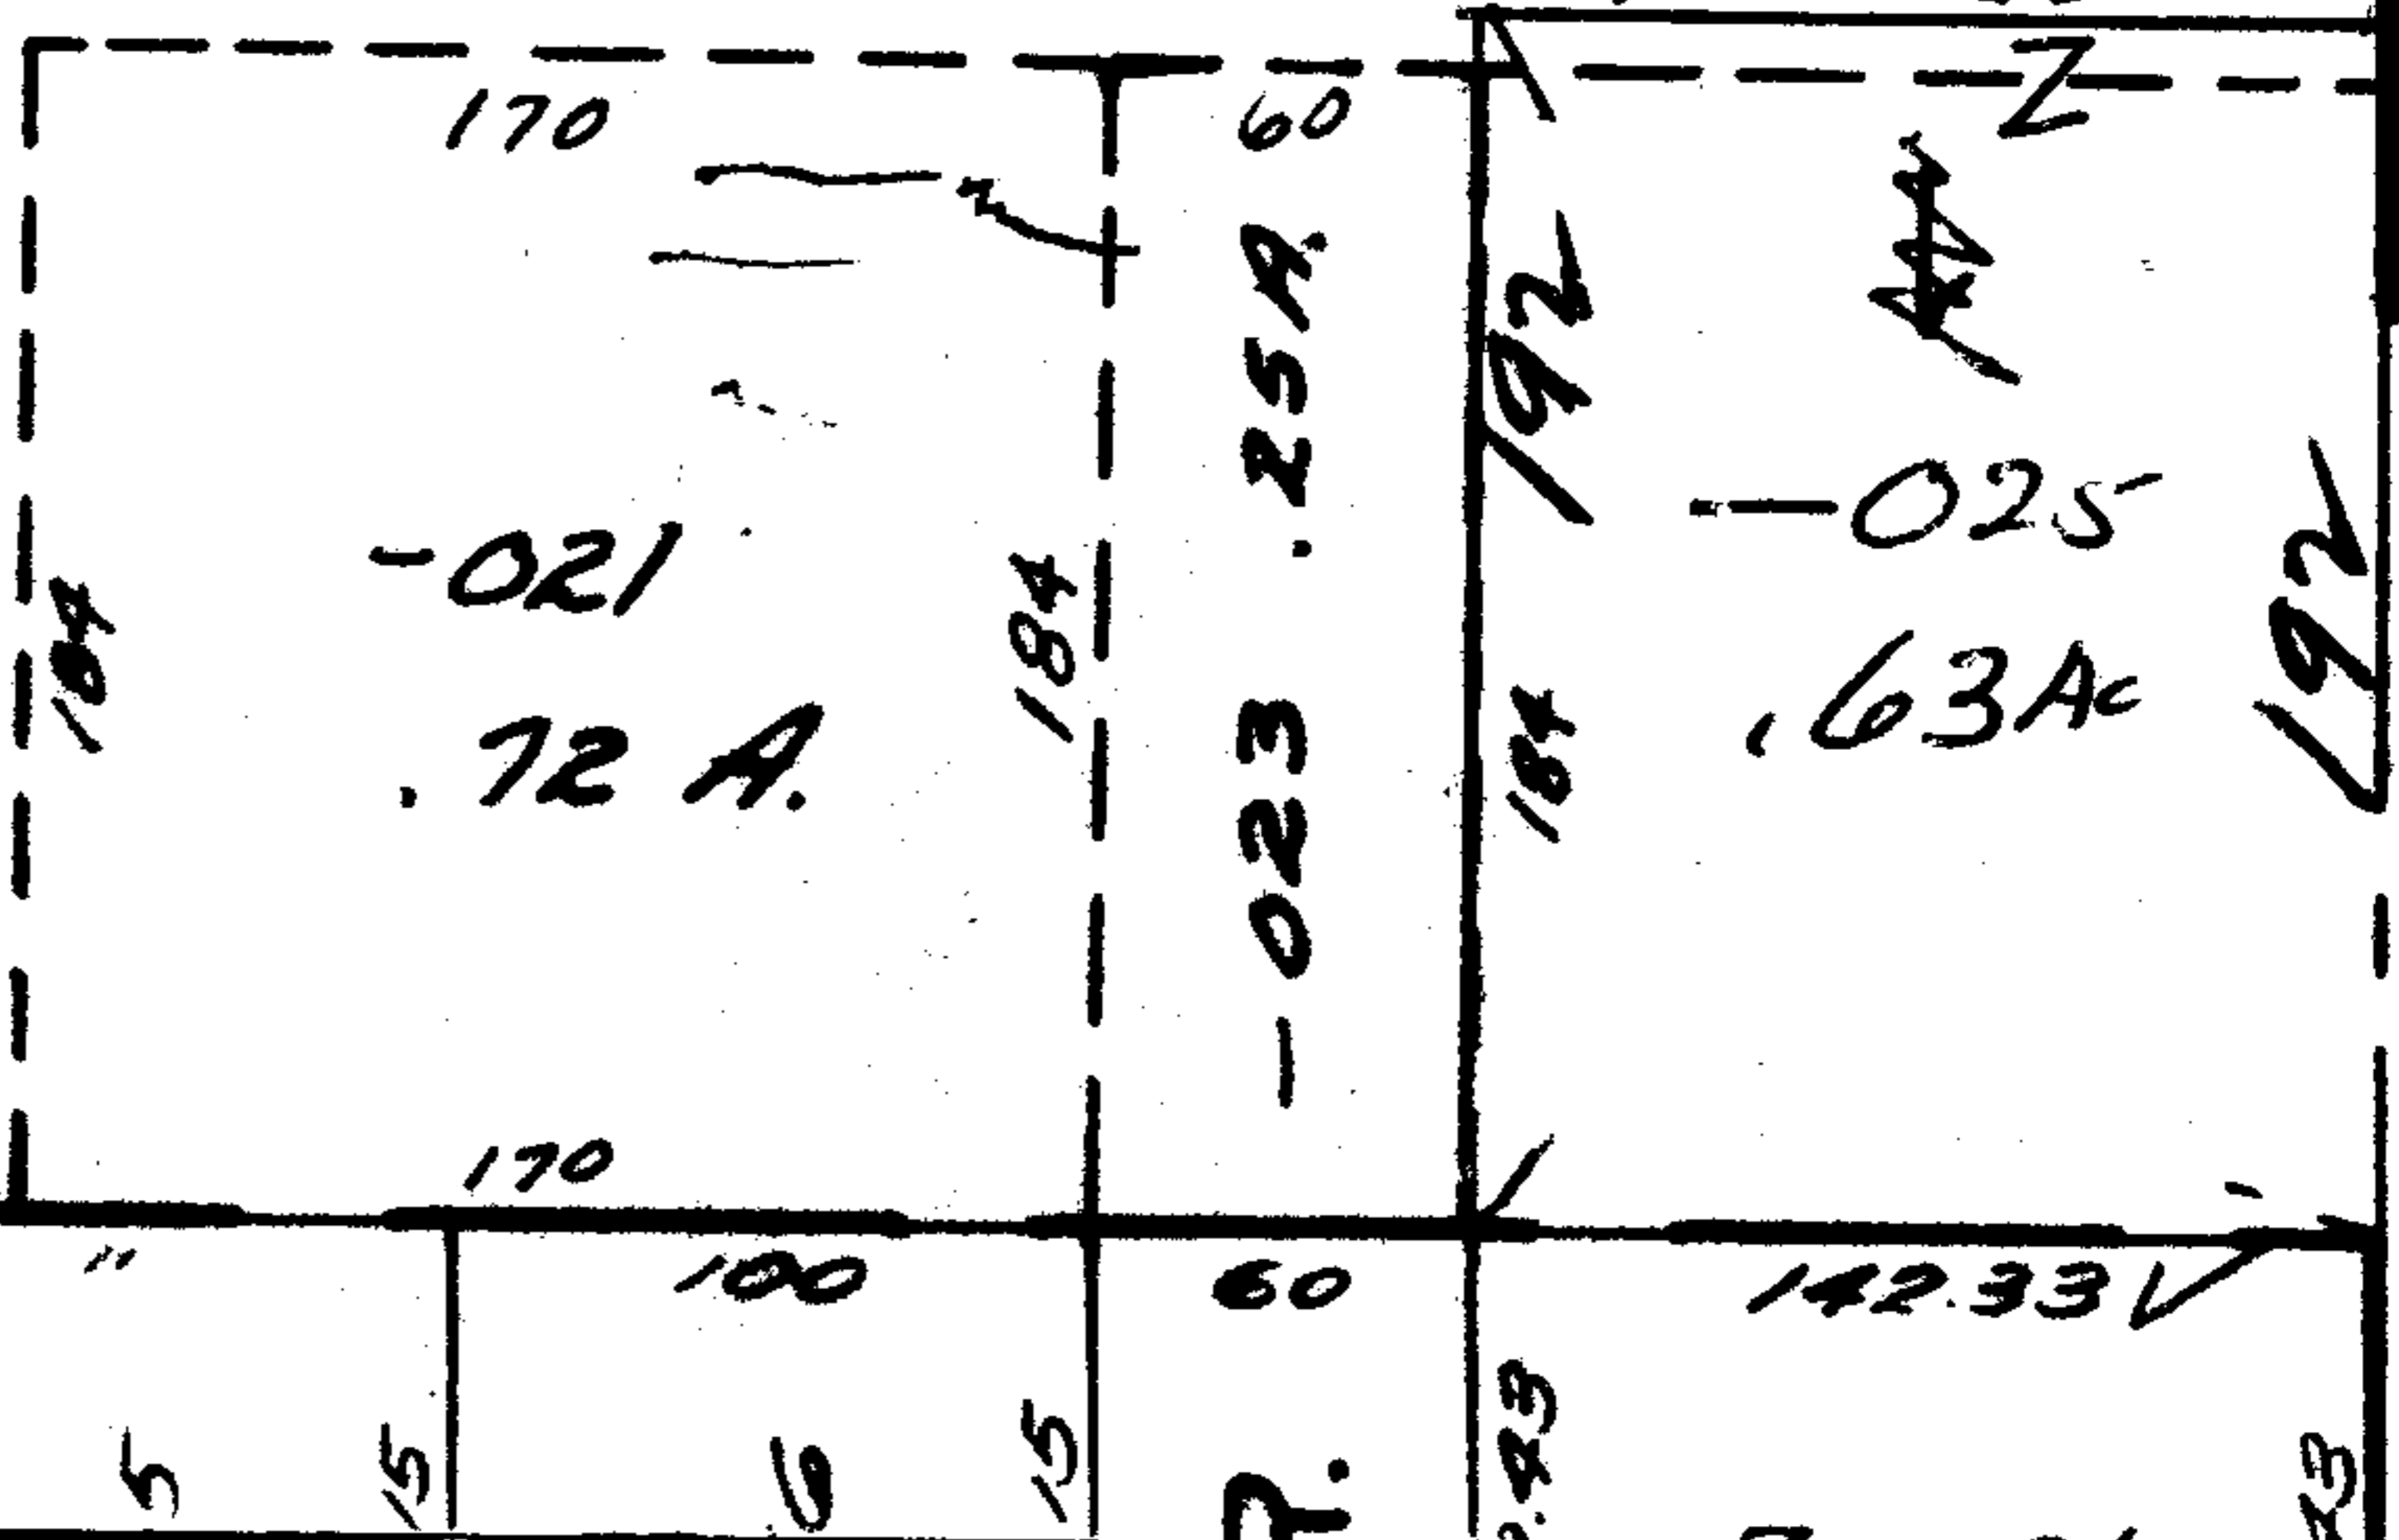

Amherst City Corp. Line

Amherst 1000

192

83