


MAY 12 1975

8750

SEE 6-16

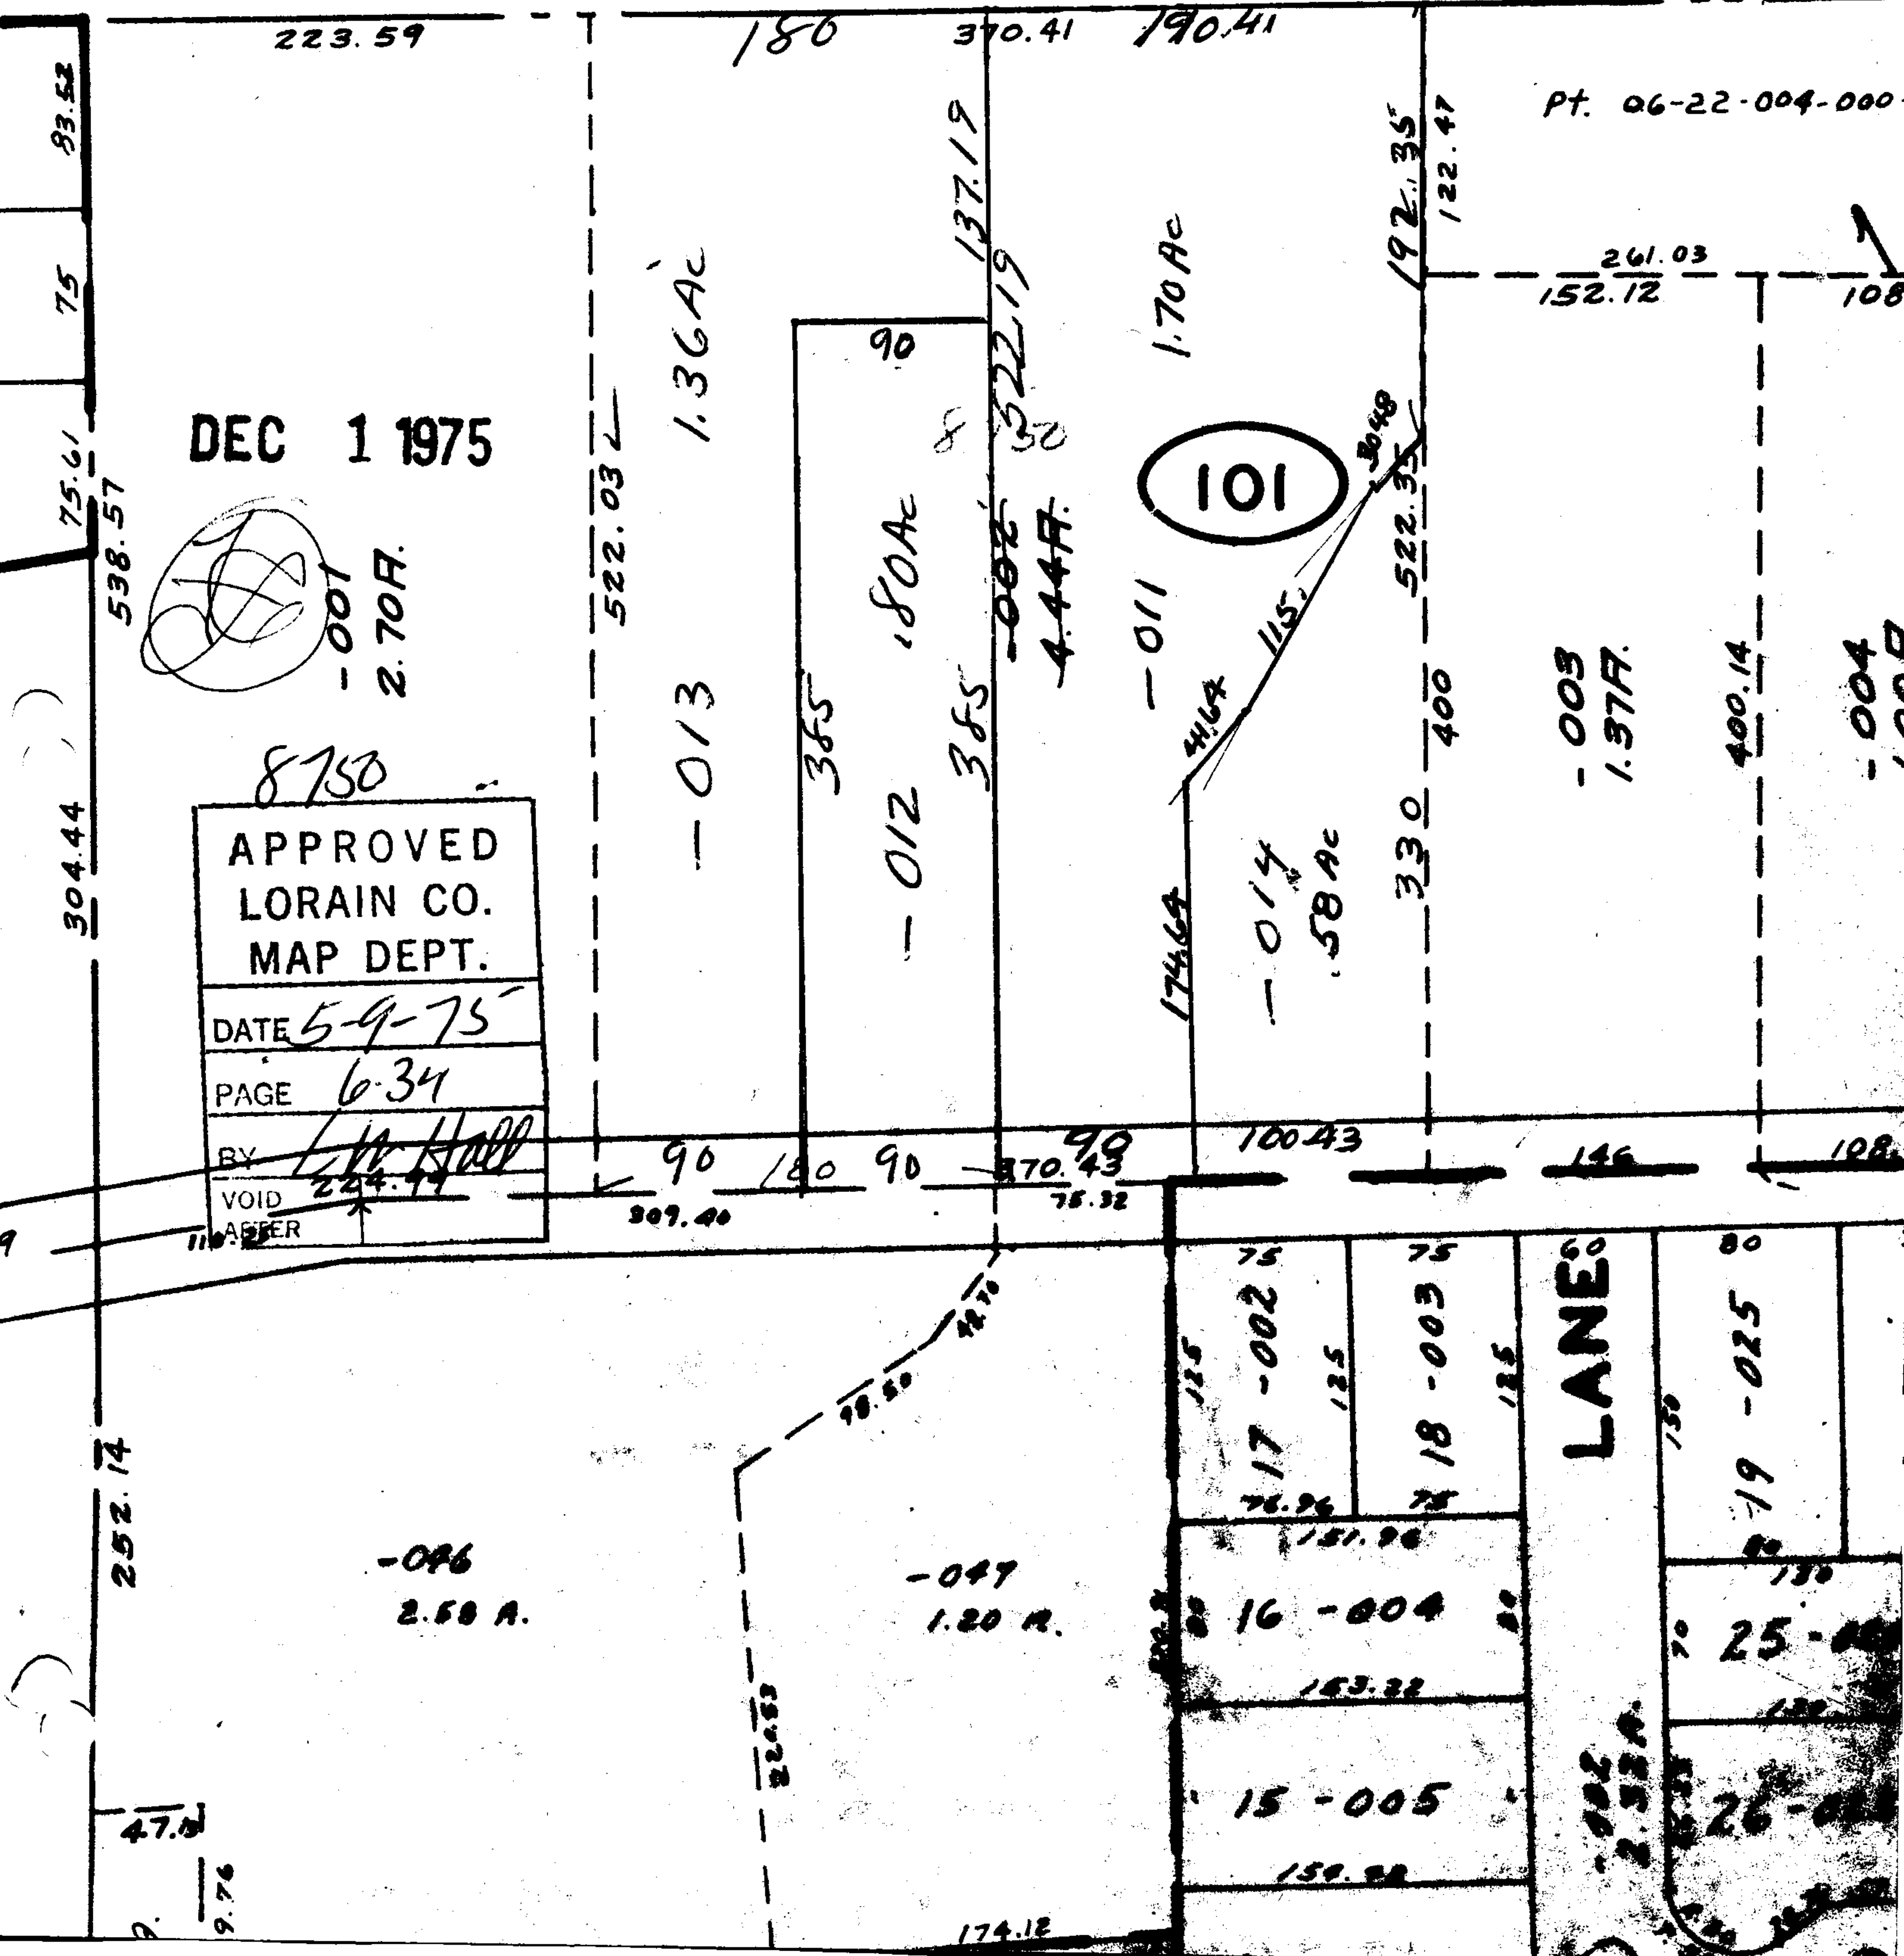

DEC 1 1975

APPROVED
LORAIN CO.
MAP DEPT.

DATE 5-9-75

PAGE 6-34

BY *L. W. Hall*

VOID AFTER 224.74

LANE