


MAY 19 1975

8758

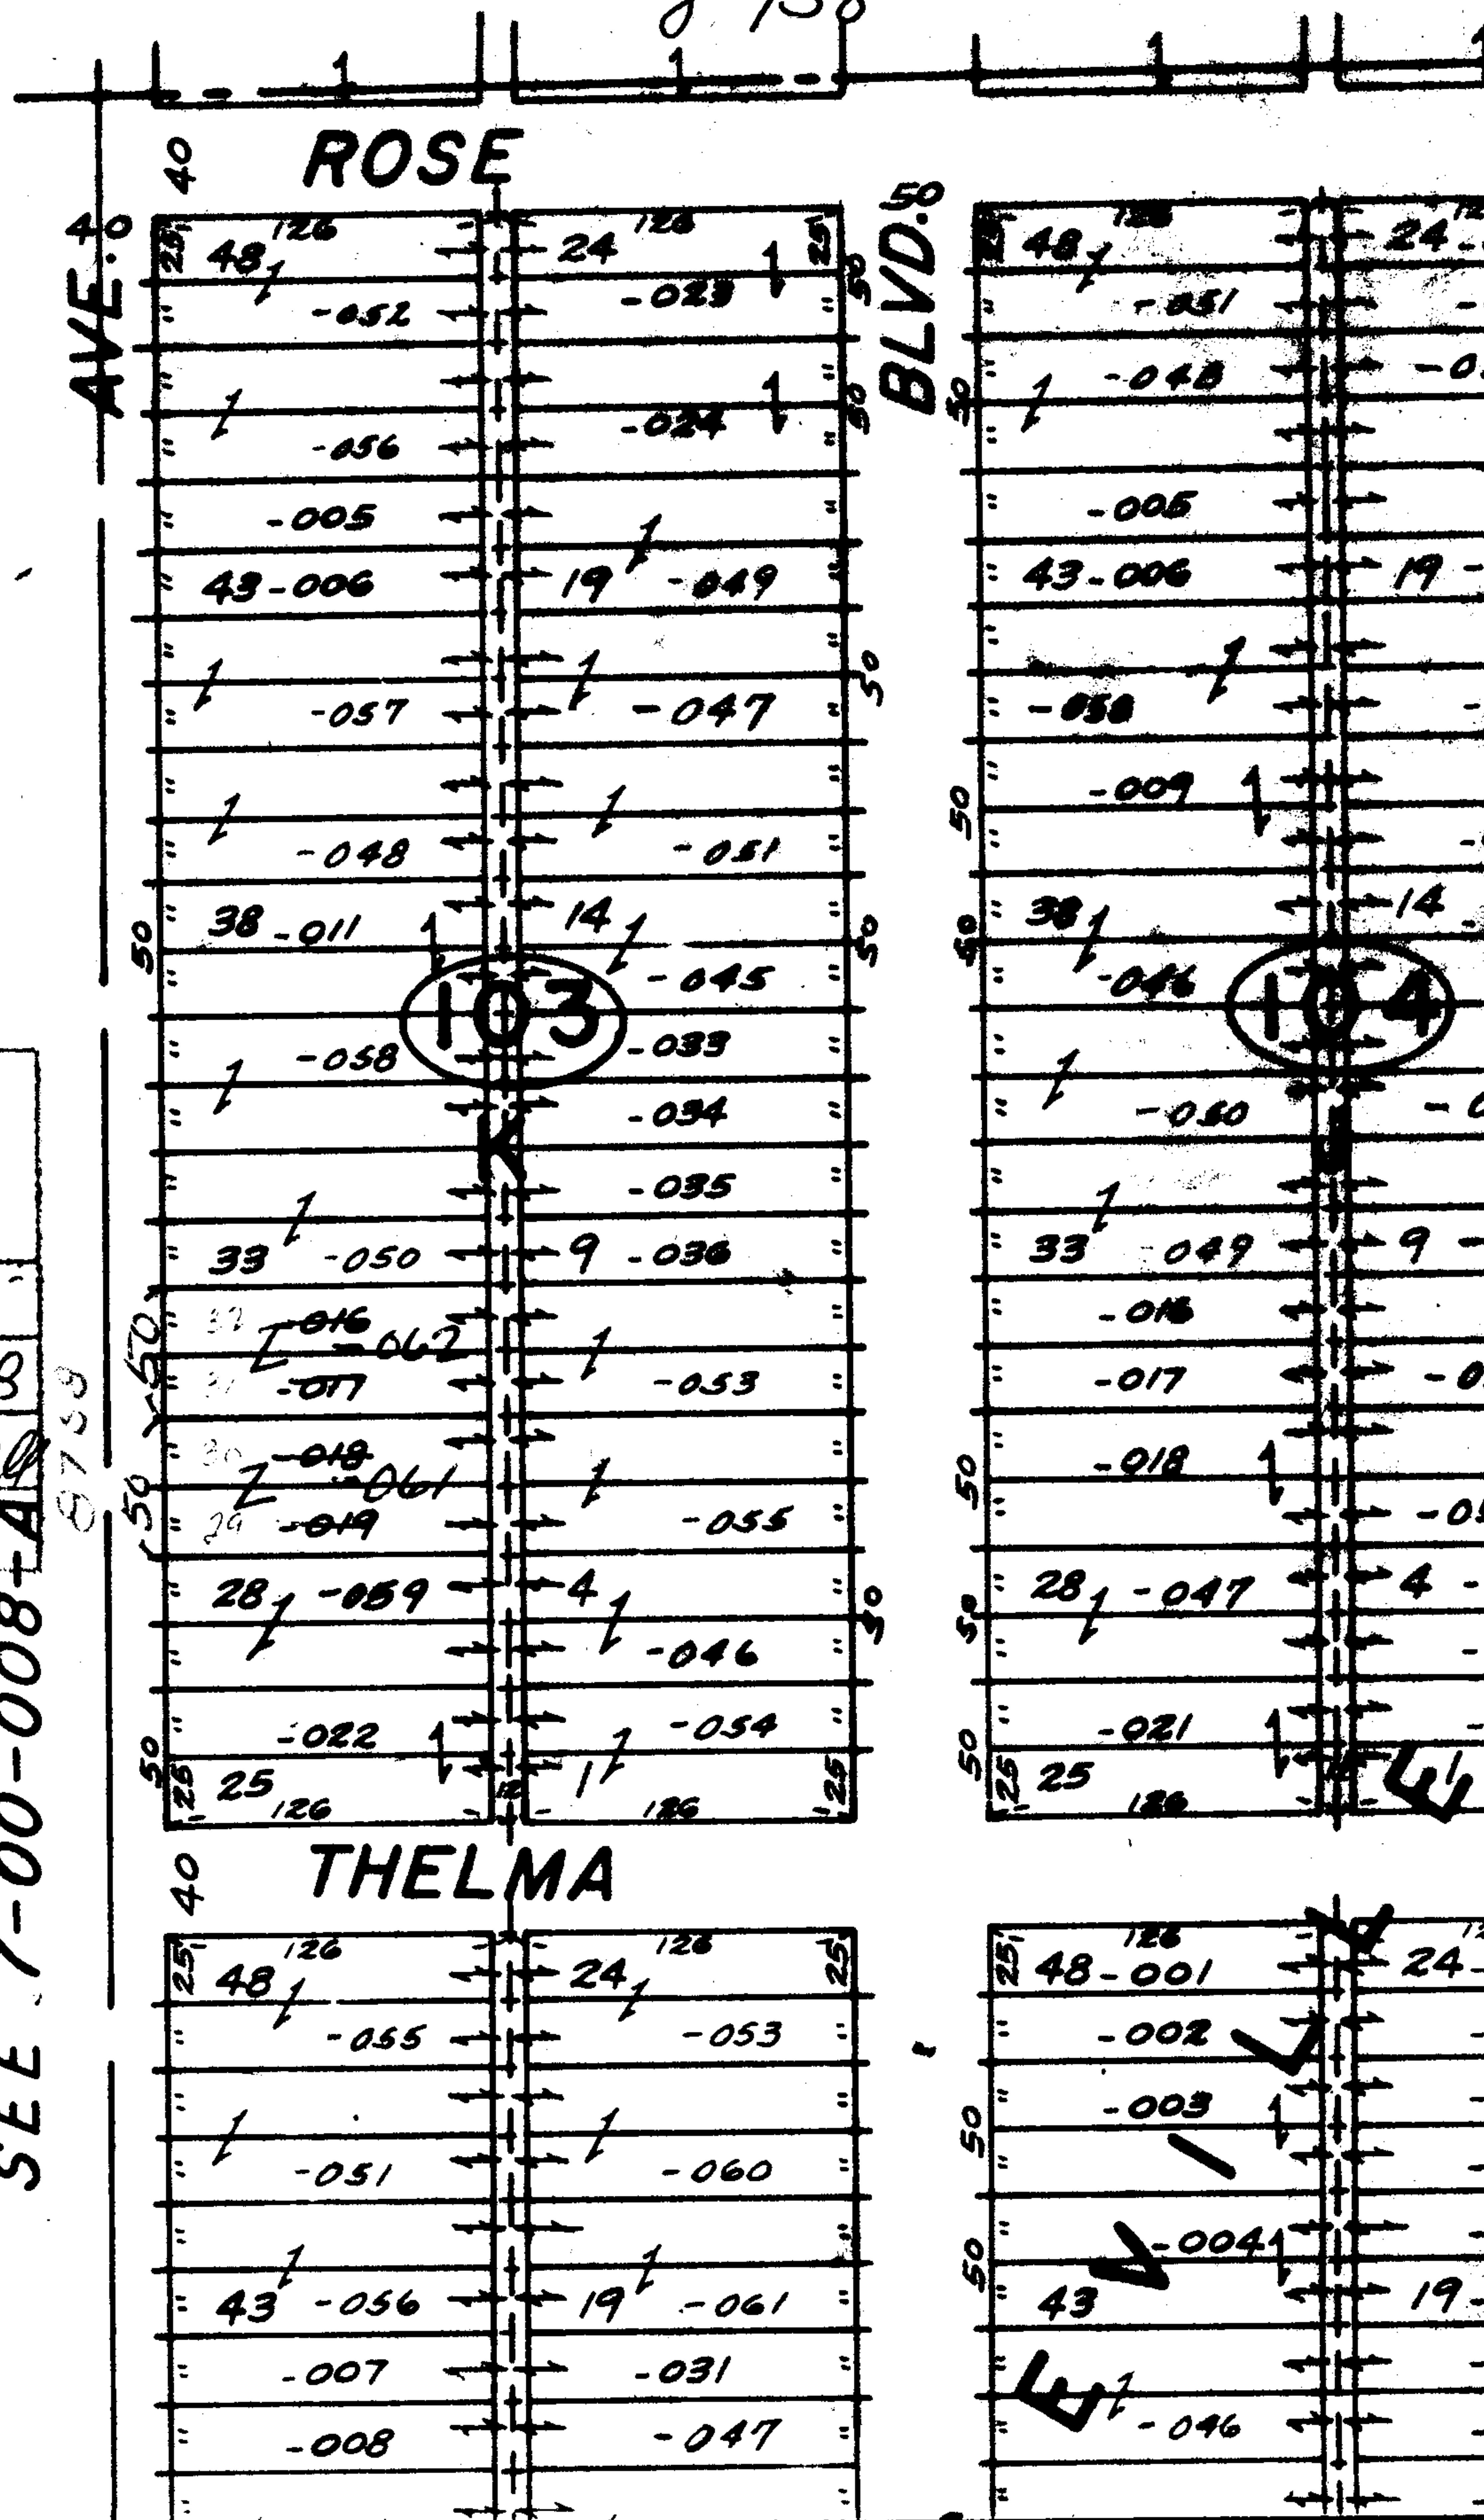

8758

APPROVED LORAIN CO. MAP DEPT.	
DATE 5-15-75	
PAGE 7-00-008B	
BY L.W. Hall	
VOID AFTER	

*Chonalex*  
*Collected*  
*LWH*

MAY 19 1975

SEE 7-00-008-A