

JUN 11 1975

04
135

1221.7


914.7

-001
28.93 A.

8814

APPROVED	
LORAIN CO.	
MAP DEPT.	
DATE	6-11-75
PAGE	1-E South
BY	<i>F. Schubert</i>
VOID AFTER	

SEP 25 1975

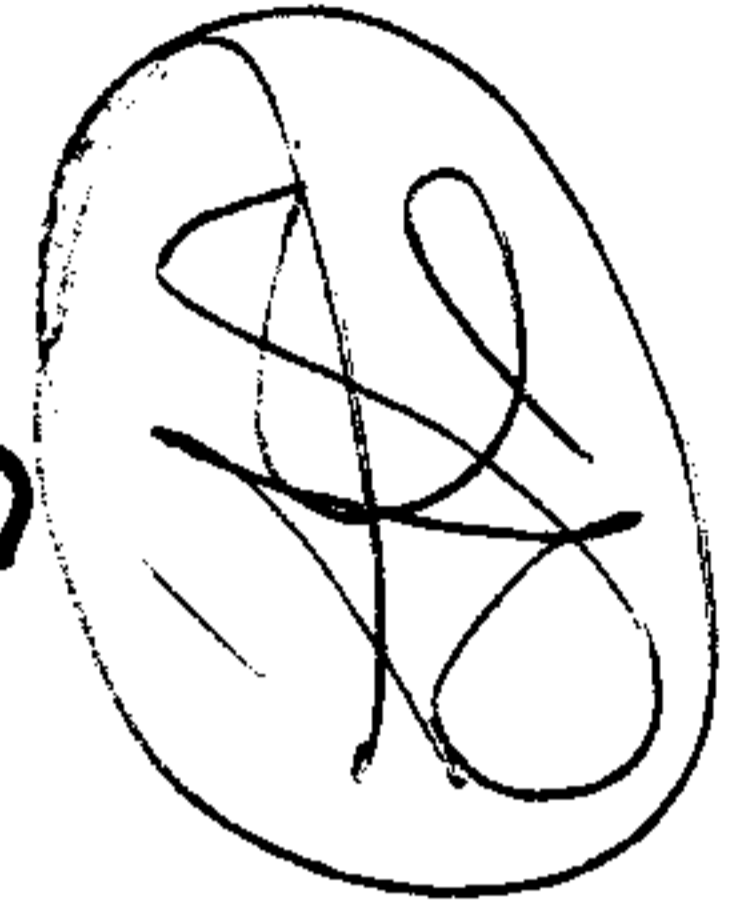

500

-035
4.38 A

500

99

Pt. ~~134~~
-136
Pt. 52.44 A
51.50 Ac.

11-00-099-B

SEE

Correct

-003
17.00 A.

345

251.70

-004
4.75 A.

609.91

345

NOVAK

226.72
899.91

1132.20

SEE

BUGHOLZ A
V. 24 P. 48

768.50

768.50

175.00

175.00

.72

.75

.70

1860.10

(60)

11-00-082-900-001
.56 A.