

SEE 9-G

RD. 0  
9

458 04


JUN 18 1975

- 052

4.50 A.

425

427

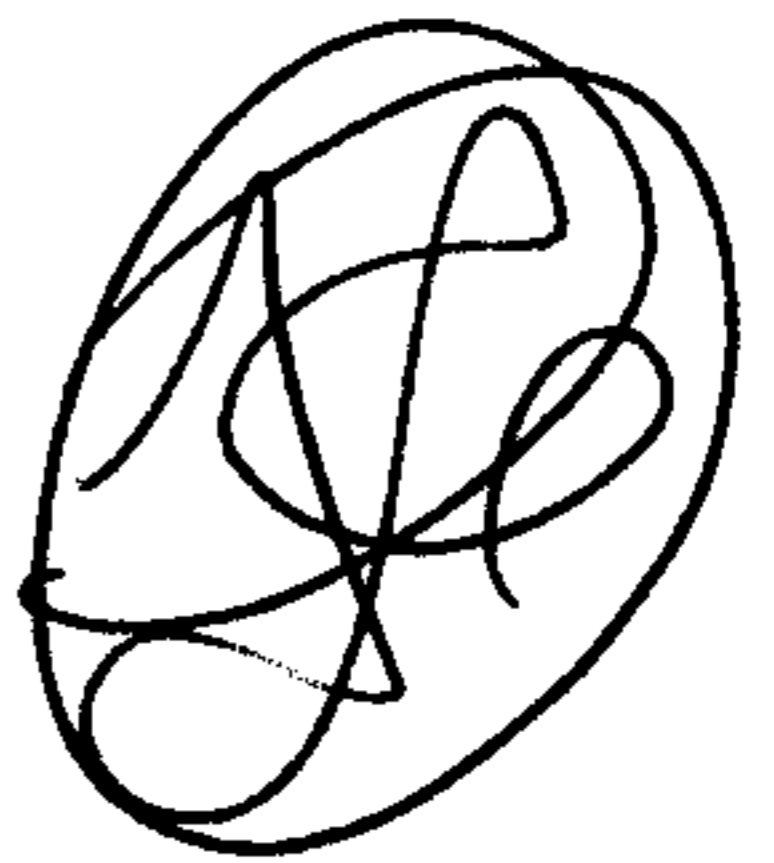

Ditch

458.04

020

1.16 Ac.

458.04

110

110

110

990

66.28  
1.16  
65.12

|                                      |  |
|--------------------------------------|--|
| 8846                                 |  |
| APPROVED.<br>LORAIN CO.<br>MAP DEPT. |  |
| DATE 6-12-75                         |  |
| PAGE 9-00-067A                       |  |
| BY <i>J. Collett</i>                 |  |
| VOID<br>AFTER                        |  |

OCT 15 1975  
90  
817-84

- 021

~~- 019~~

~~66.28 Ac.~~

65.12 Ac.