


JUN 23 1975

8848

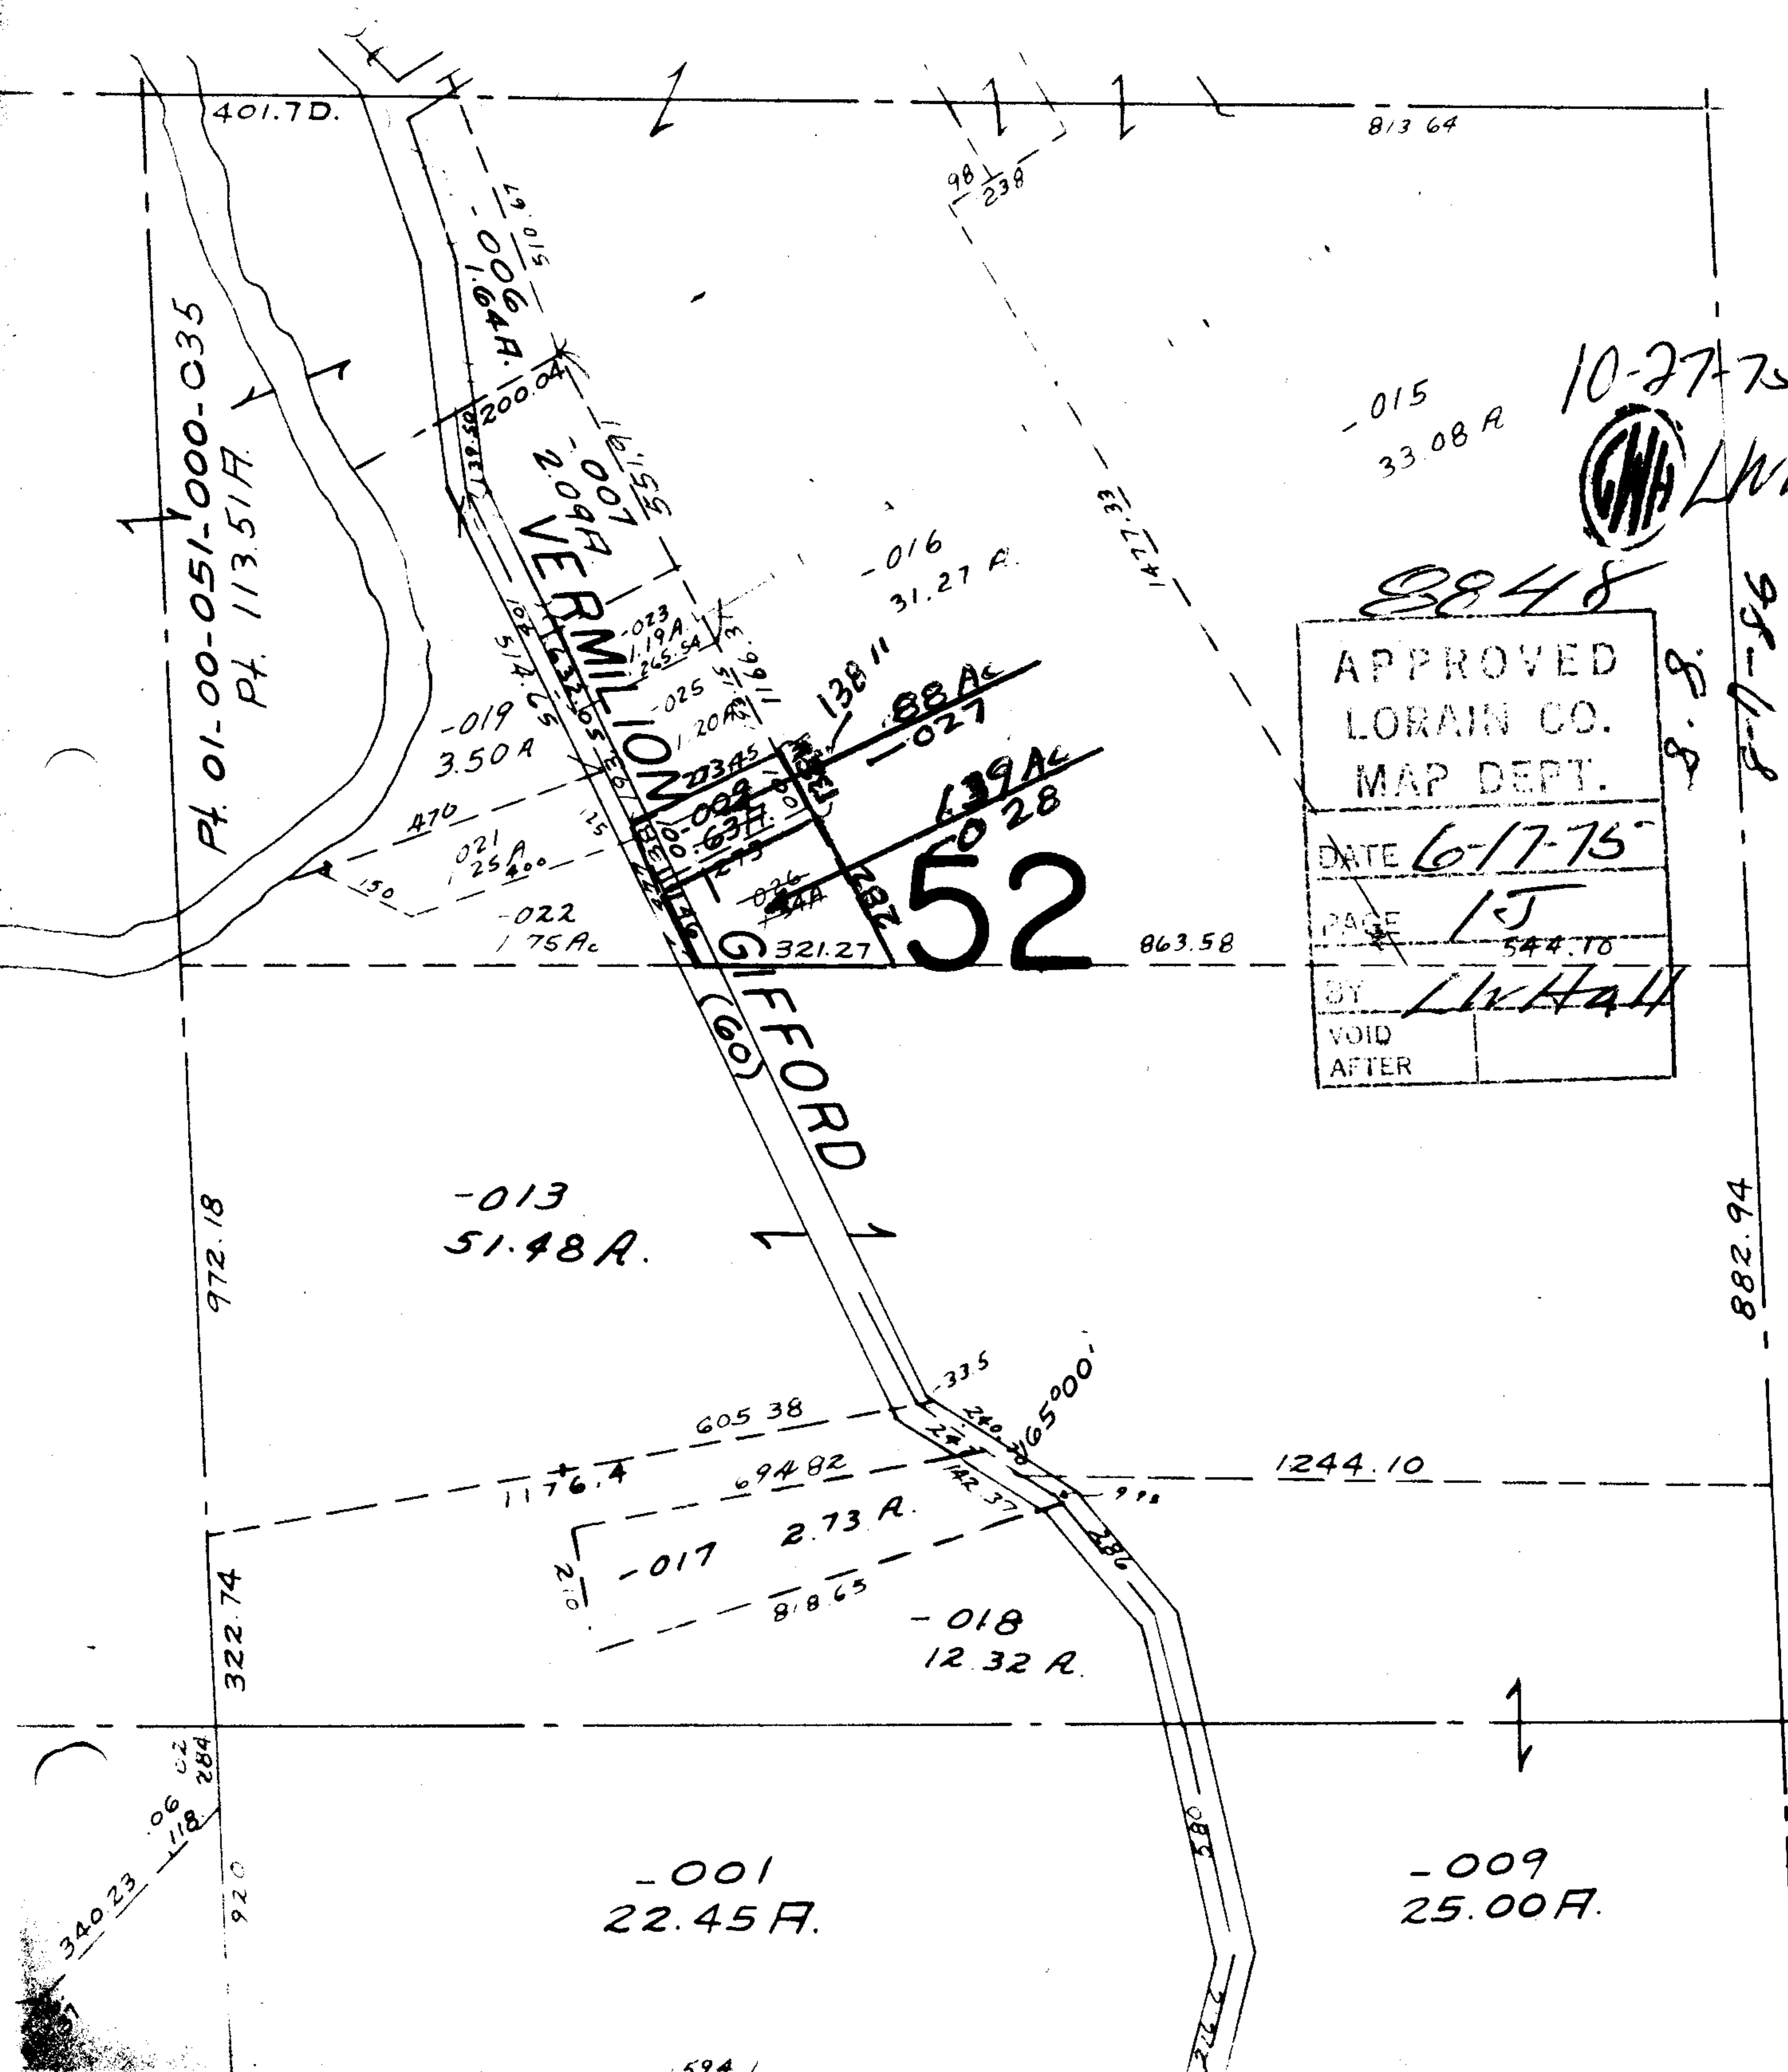

10-27-75
 -015
 33.08 A
 LWA
 8848
 S.S.
 8-1-86

APPROVED	
LORAIN CO.	
MAP DEPT.	
DATE	6-17-75
PAGE	15
BY	LWA
VOID	
AFTER	

34023
 06 02
 118 284
 920

594