

5.50 A.

JFS

-009
1.00 A.

990

JUN 20 1975

- 001
41.75 A.

011
41.50 AC
~~-009~~
~~51.50 A.~~

335.44

13

2220.77

- 010
10.00 AC
2220.77

- 008
10.00 A.
2220.77

- 003
10.00 A.

196.07/16.07

196.07/16.07

- 004
20.00 A.

1775

- 006
8.50 A.


- 005
10.00 A.

250

- 007
5.00 A.

1470

APPROVED
LORAIN CO.
MAP DEPT.

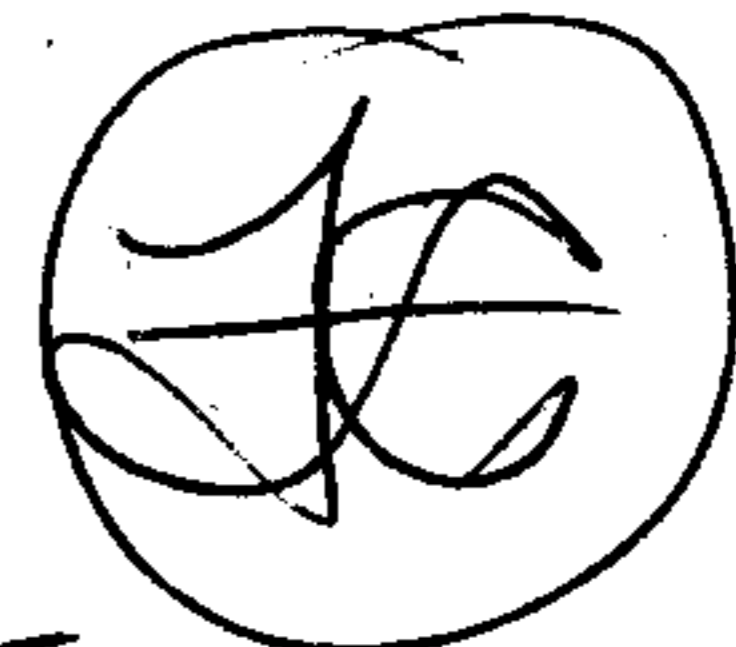

DATE *6-20-75*

SEP 11 1975

PAGE *15D*

BY *LW Hall*

VOID
AFTER

15D

-005
35.50 A.

390.42
-004 1.00 A.
390.46