


Alleys outlined SEE 10-00-004-A  
Valuated By Ord 75741 Dated June 2-75

FULLER RD

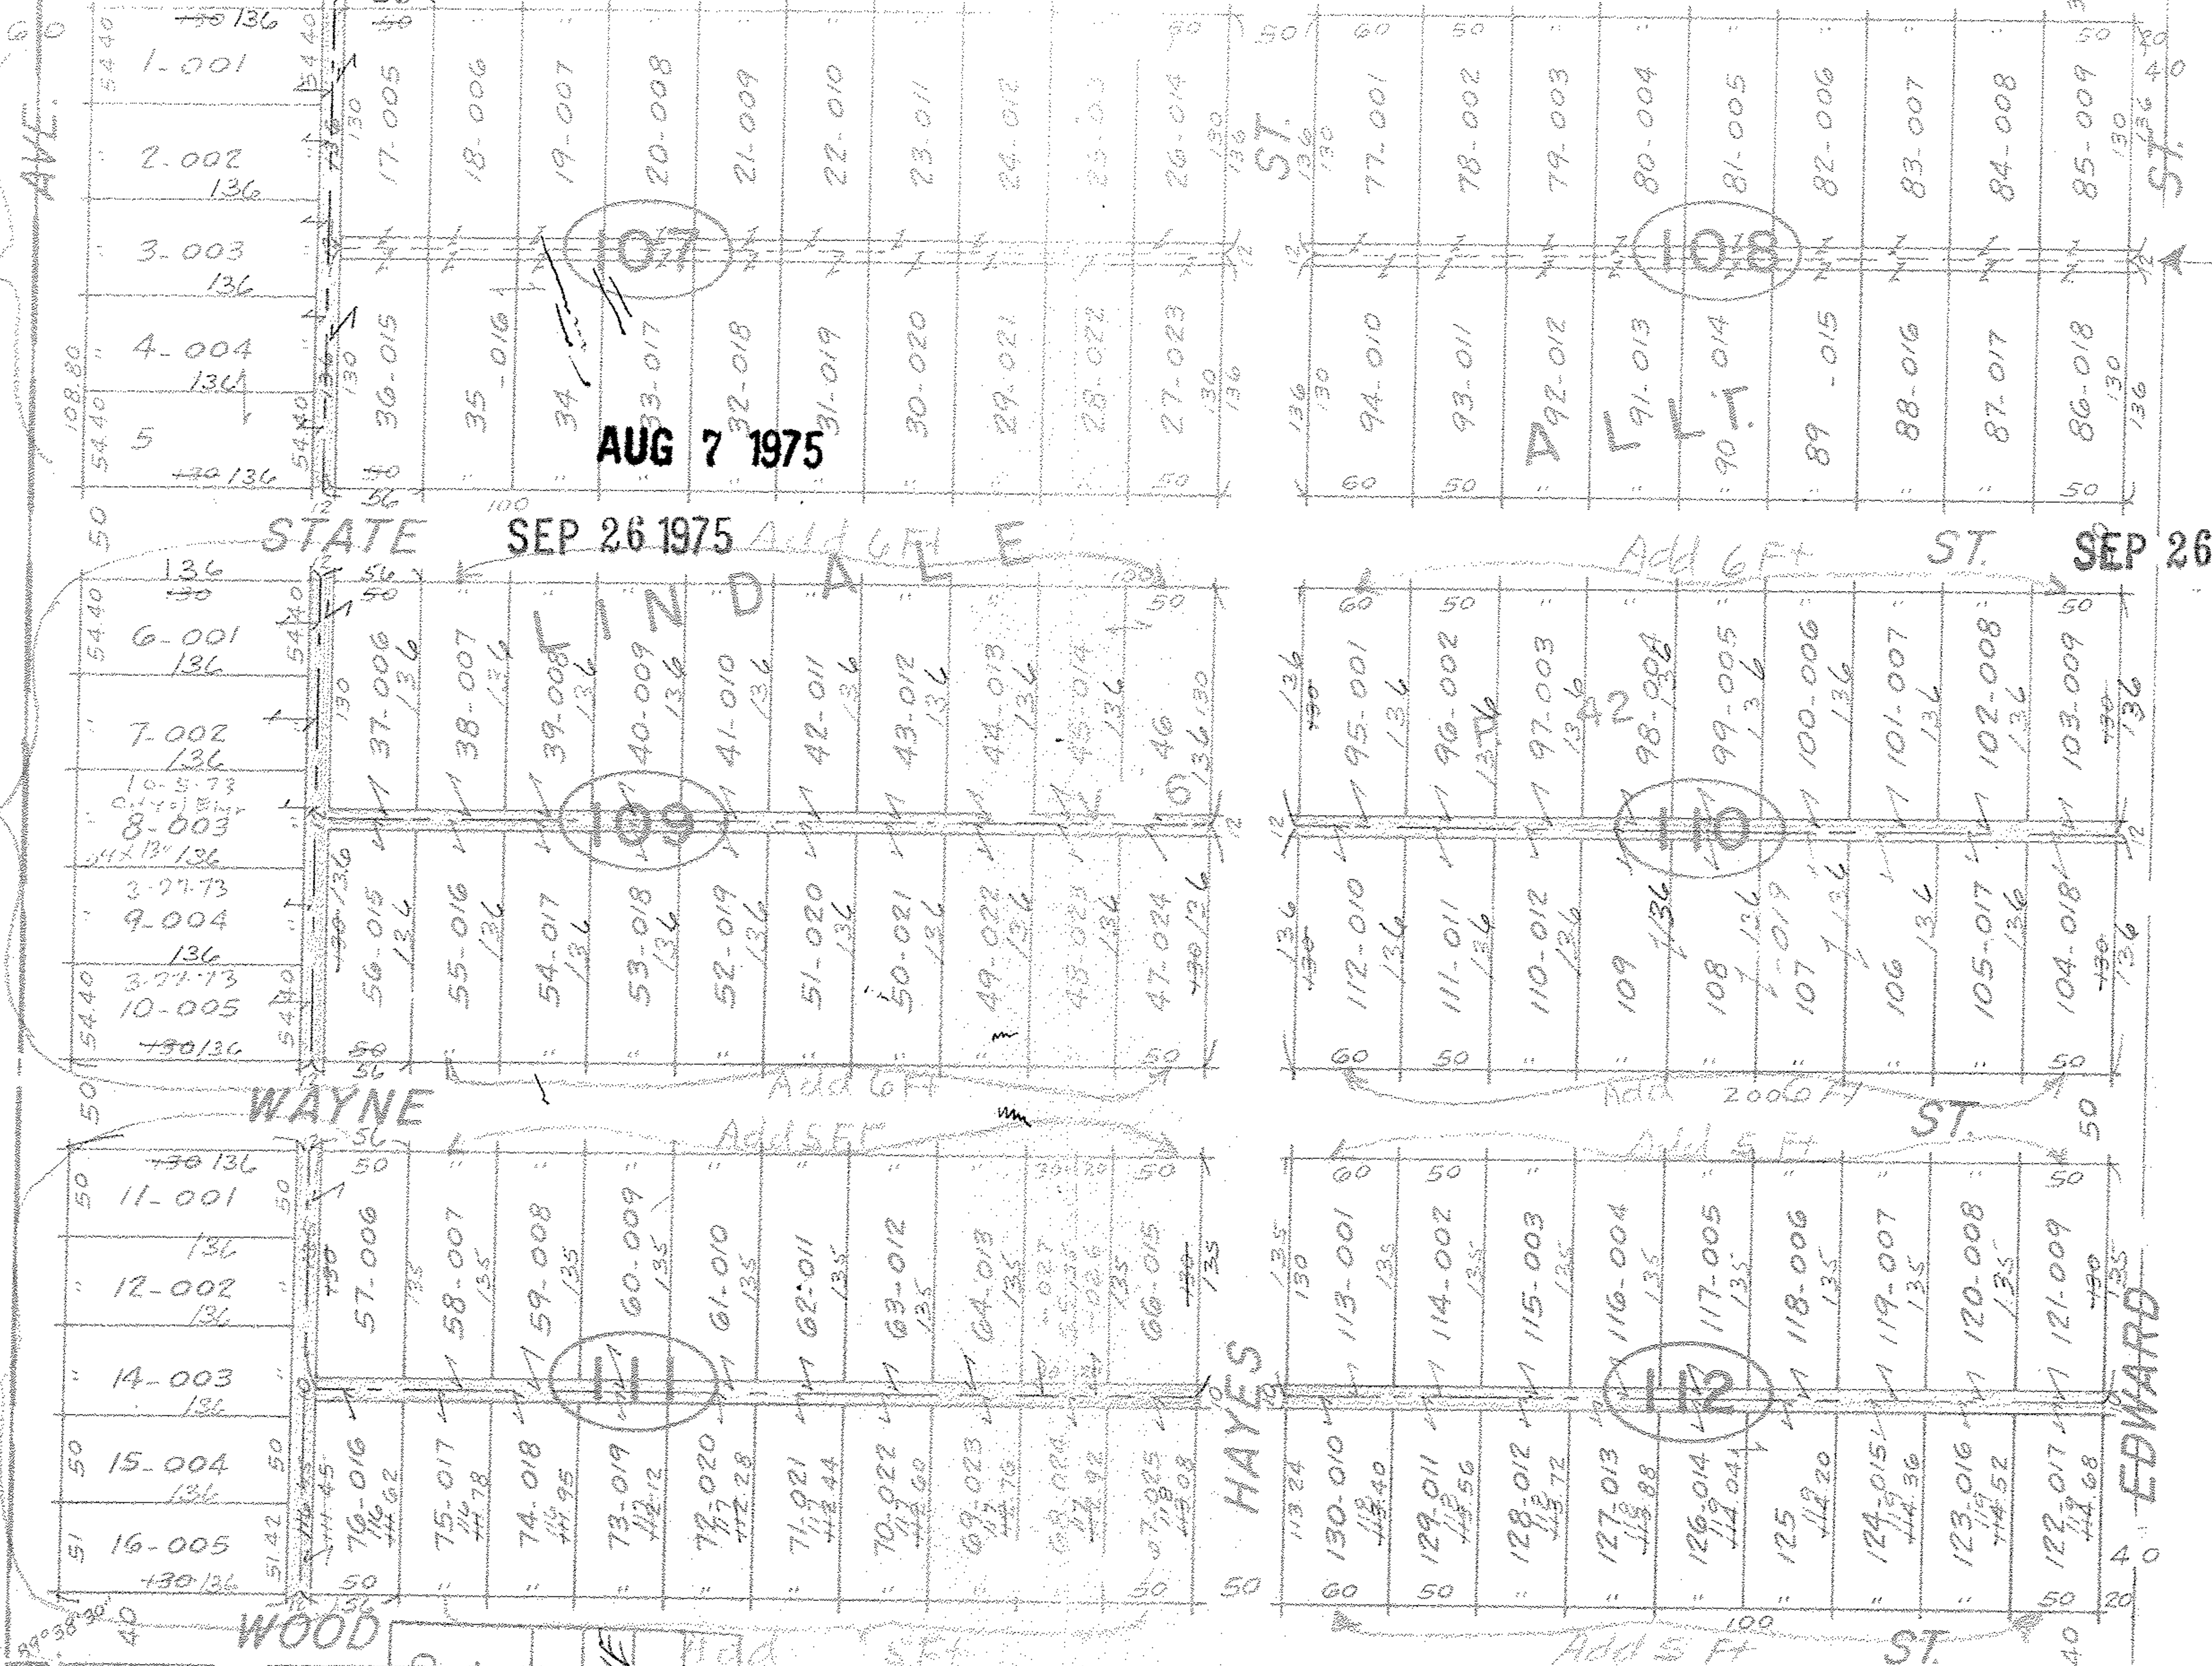

AUG 7 1975

SEP 26 1975

SEP 26 1975

Add 6 Ft

Add 6 Ft

Add 6 Ft

Add 6 Ft

VACATED  
11-2  
TRAS

PROMED  
IN CO  
DEPT  
14-75  
10-004  
10-004

PK - 010 PK 72 90

10-00-004-E 1980  
1172.52