


8901

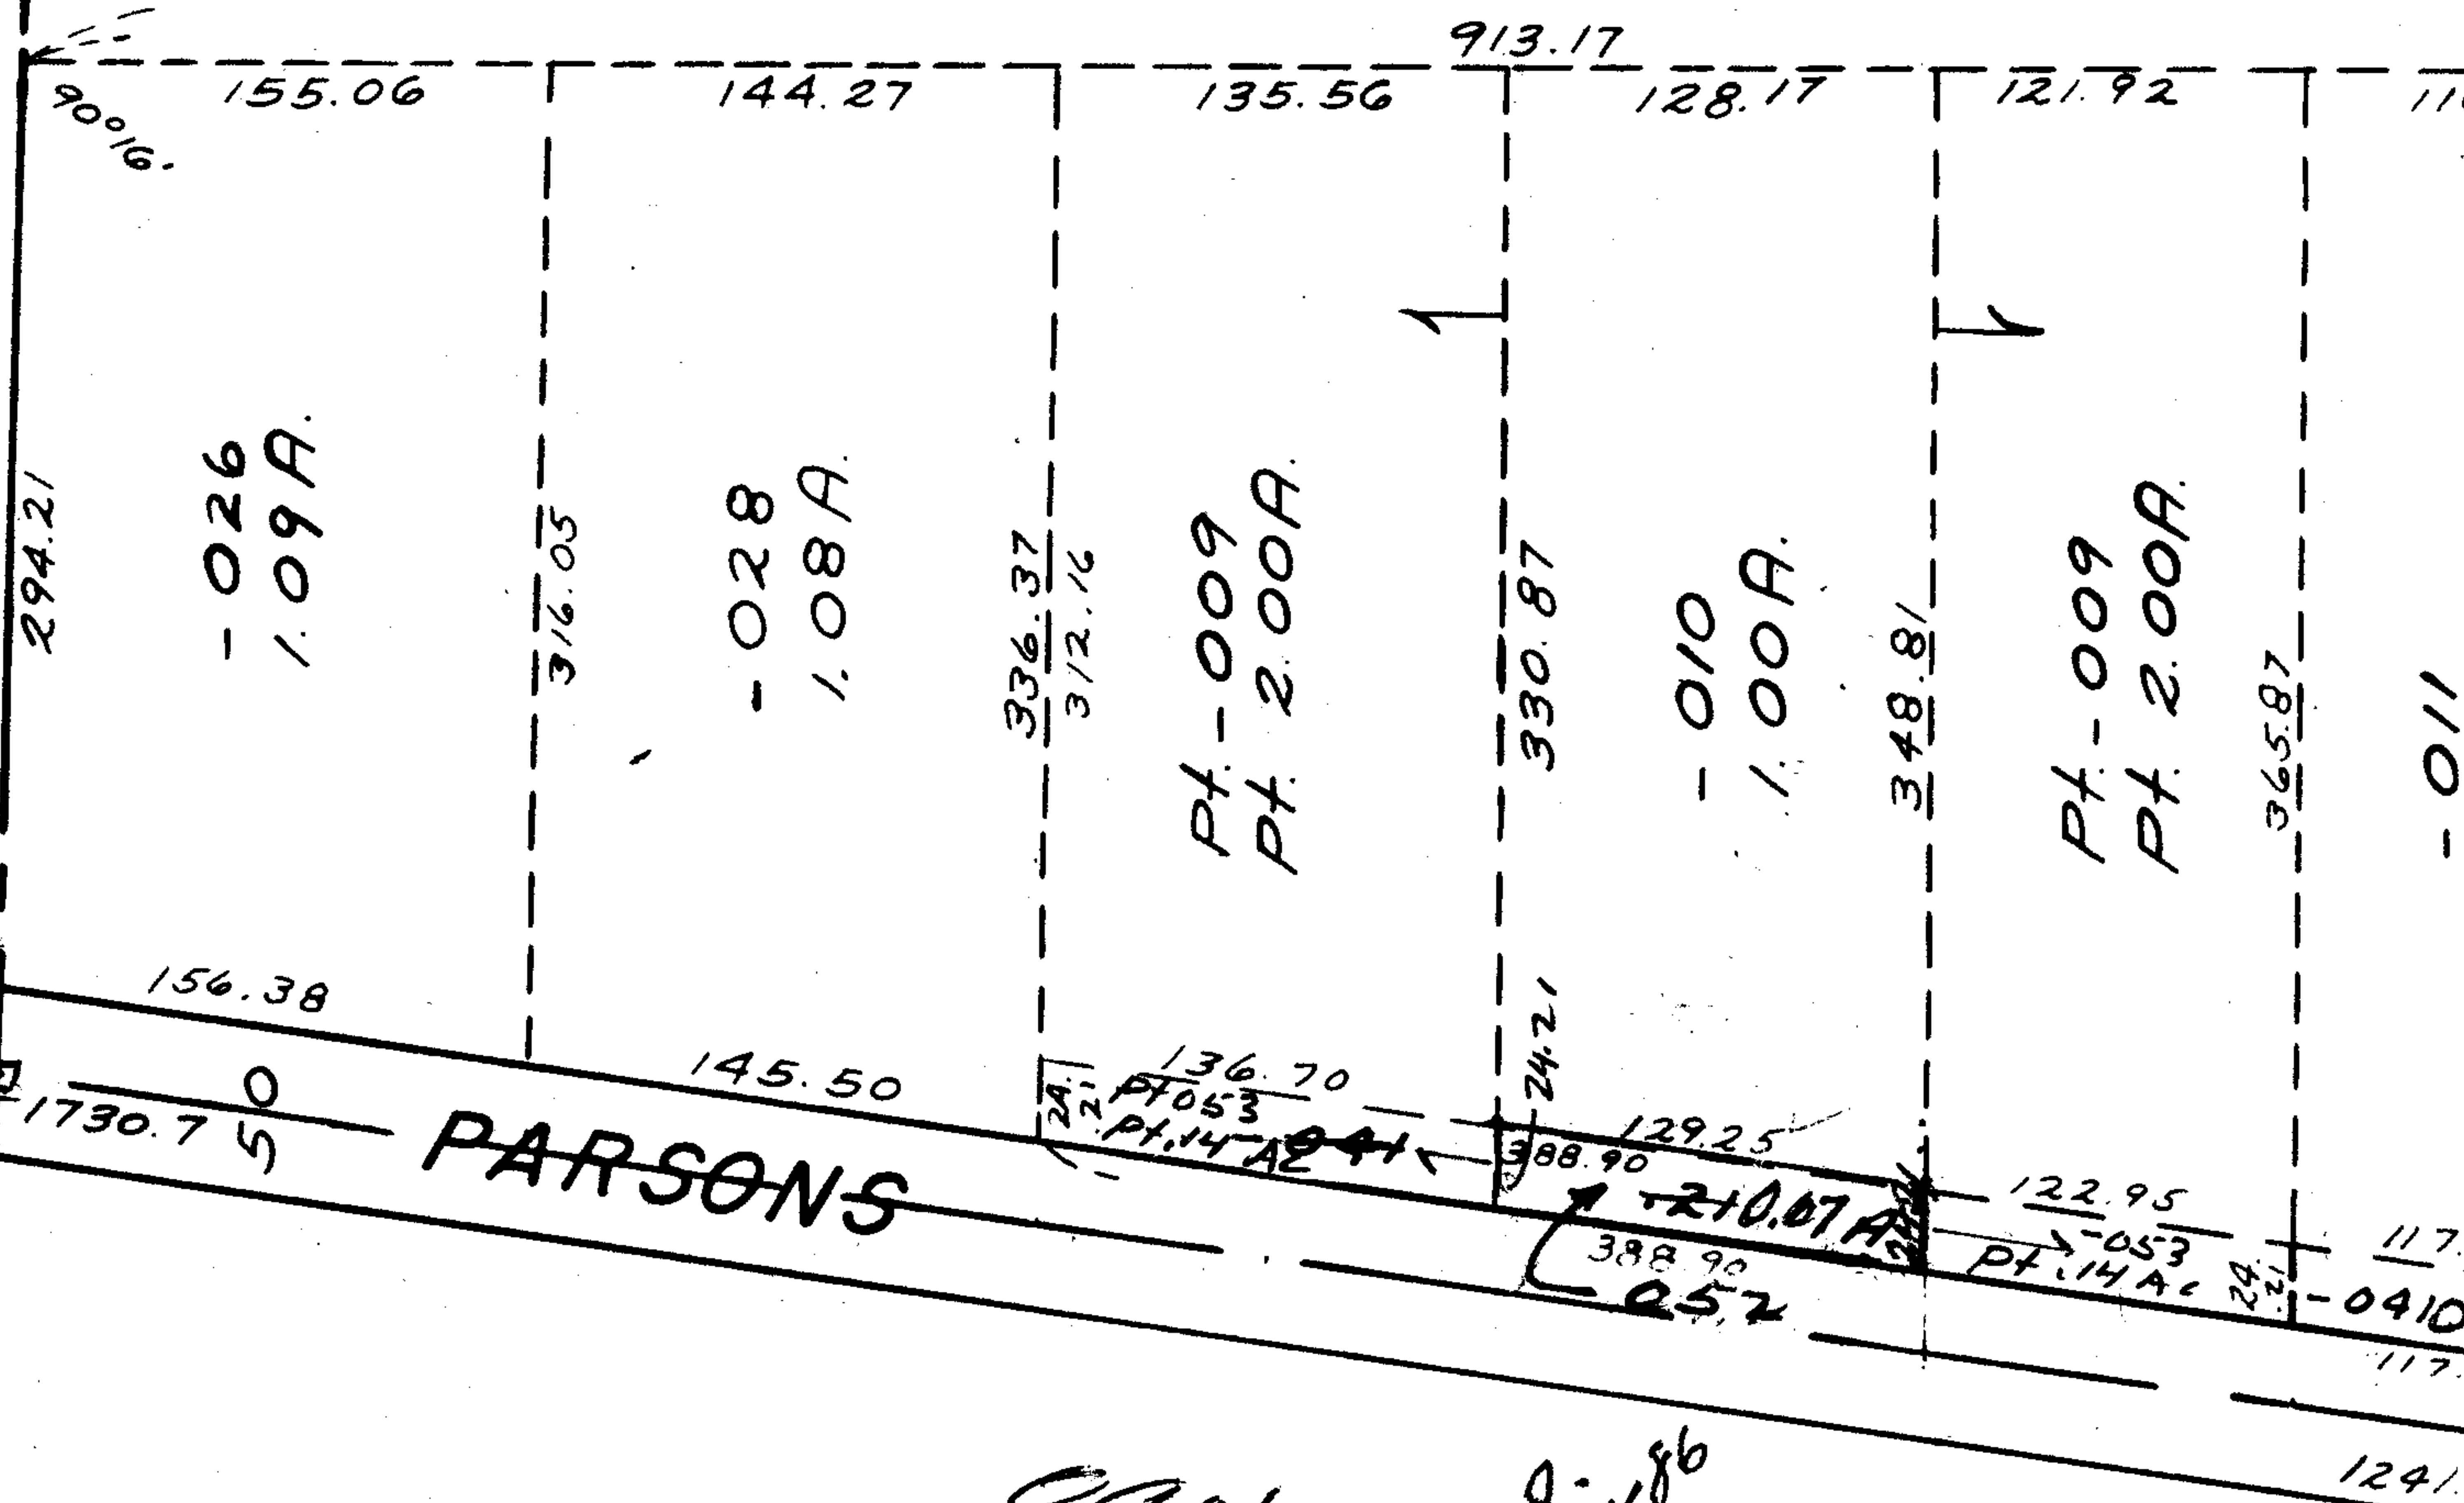

8901

APPROVED
LORAIN CO.
MAP DEPT.
DATE 12-9-75
PAGE 9-00-100A
BY L.W. Hill
VOID AFTER

8-8-86  
8-1-86

330.87  
x 128.17  
42,407.60 ✓  
1149.68 ✓  
43557.28 ✓  
113560 = 100Ac

DEC 29 1975

179.47 x 128.17 = 1149.68

*[Handwritten signature]*

129.25  
x 24.21  
3129.14 = .07Ac  
113560

348.81  
330.87  
17.94

-019  
15.60A.