

SEE 7-00-014-B

526.02

8945

-011  
3.65 A

APPROVED.  
LORAIN CO.  
MAP DEPT.


E 7-21-75

E 7-00-011 A

BY *[Signature]*

VOID  
AFTER

OCT 22 1975

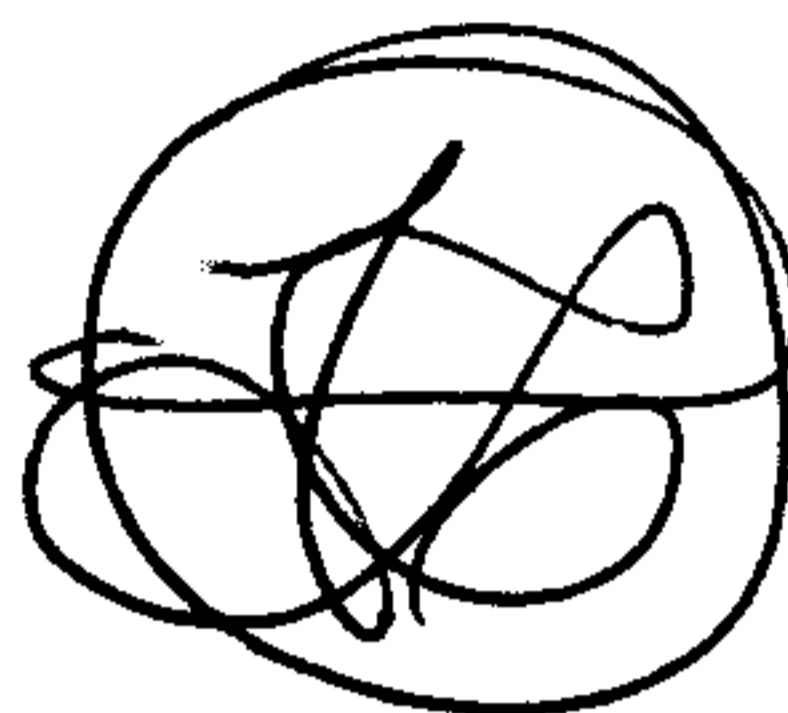

3220.62  
214.59  
-06.03

499.67 Q-1-86 L.L.

185

~~504.05~~ 319.05

~~022~~  
135 A  
-024  
77 A  
-023  
58 A

236.11

214.59  
220.62  
90

125.72

78.5  
-002  
0.30 A

-03 A  
1.17 A

Pt. 07-00-014-104-011  
Pt. 016  
Pt. 75 A

BUTTERNUT RIDGE

82.5  
198.50  
106.03  
89.57

214.59  
90

-063

-064

365.01  
365.16

1.04 A

Pt. 07-00-014-104-010

87.9

220.69

0008  
0.63 A

292.33  
291.95

-062

75 A

365.15

1.04 A

1.45  
2.55  
48.03

1.45  
2.55  
48.03

JUL 21 1975

328.6

485.46

54.27

97.42

237.69

499.83