

JUL 29 1975

SEE 18

GROVE ST.

ST.

ST.


ST. A D

ST. D

ST. A D

ST. A D

COURTLAND

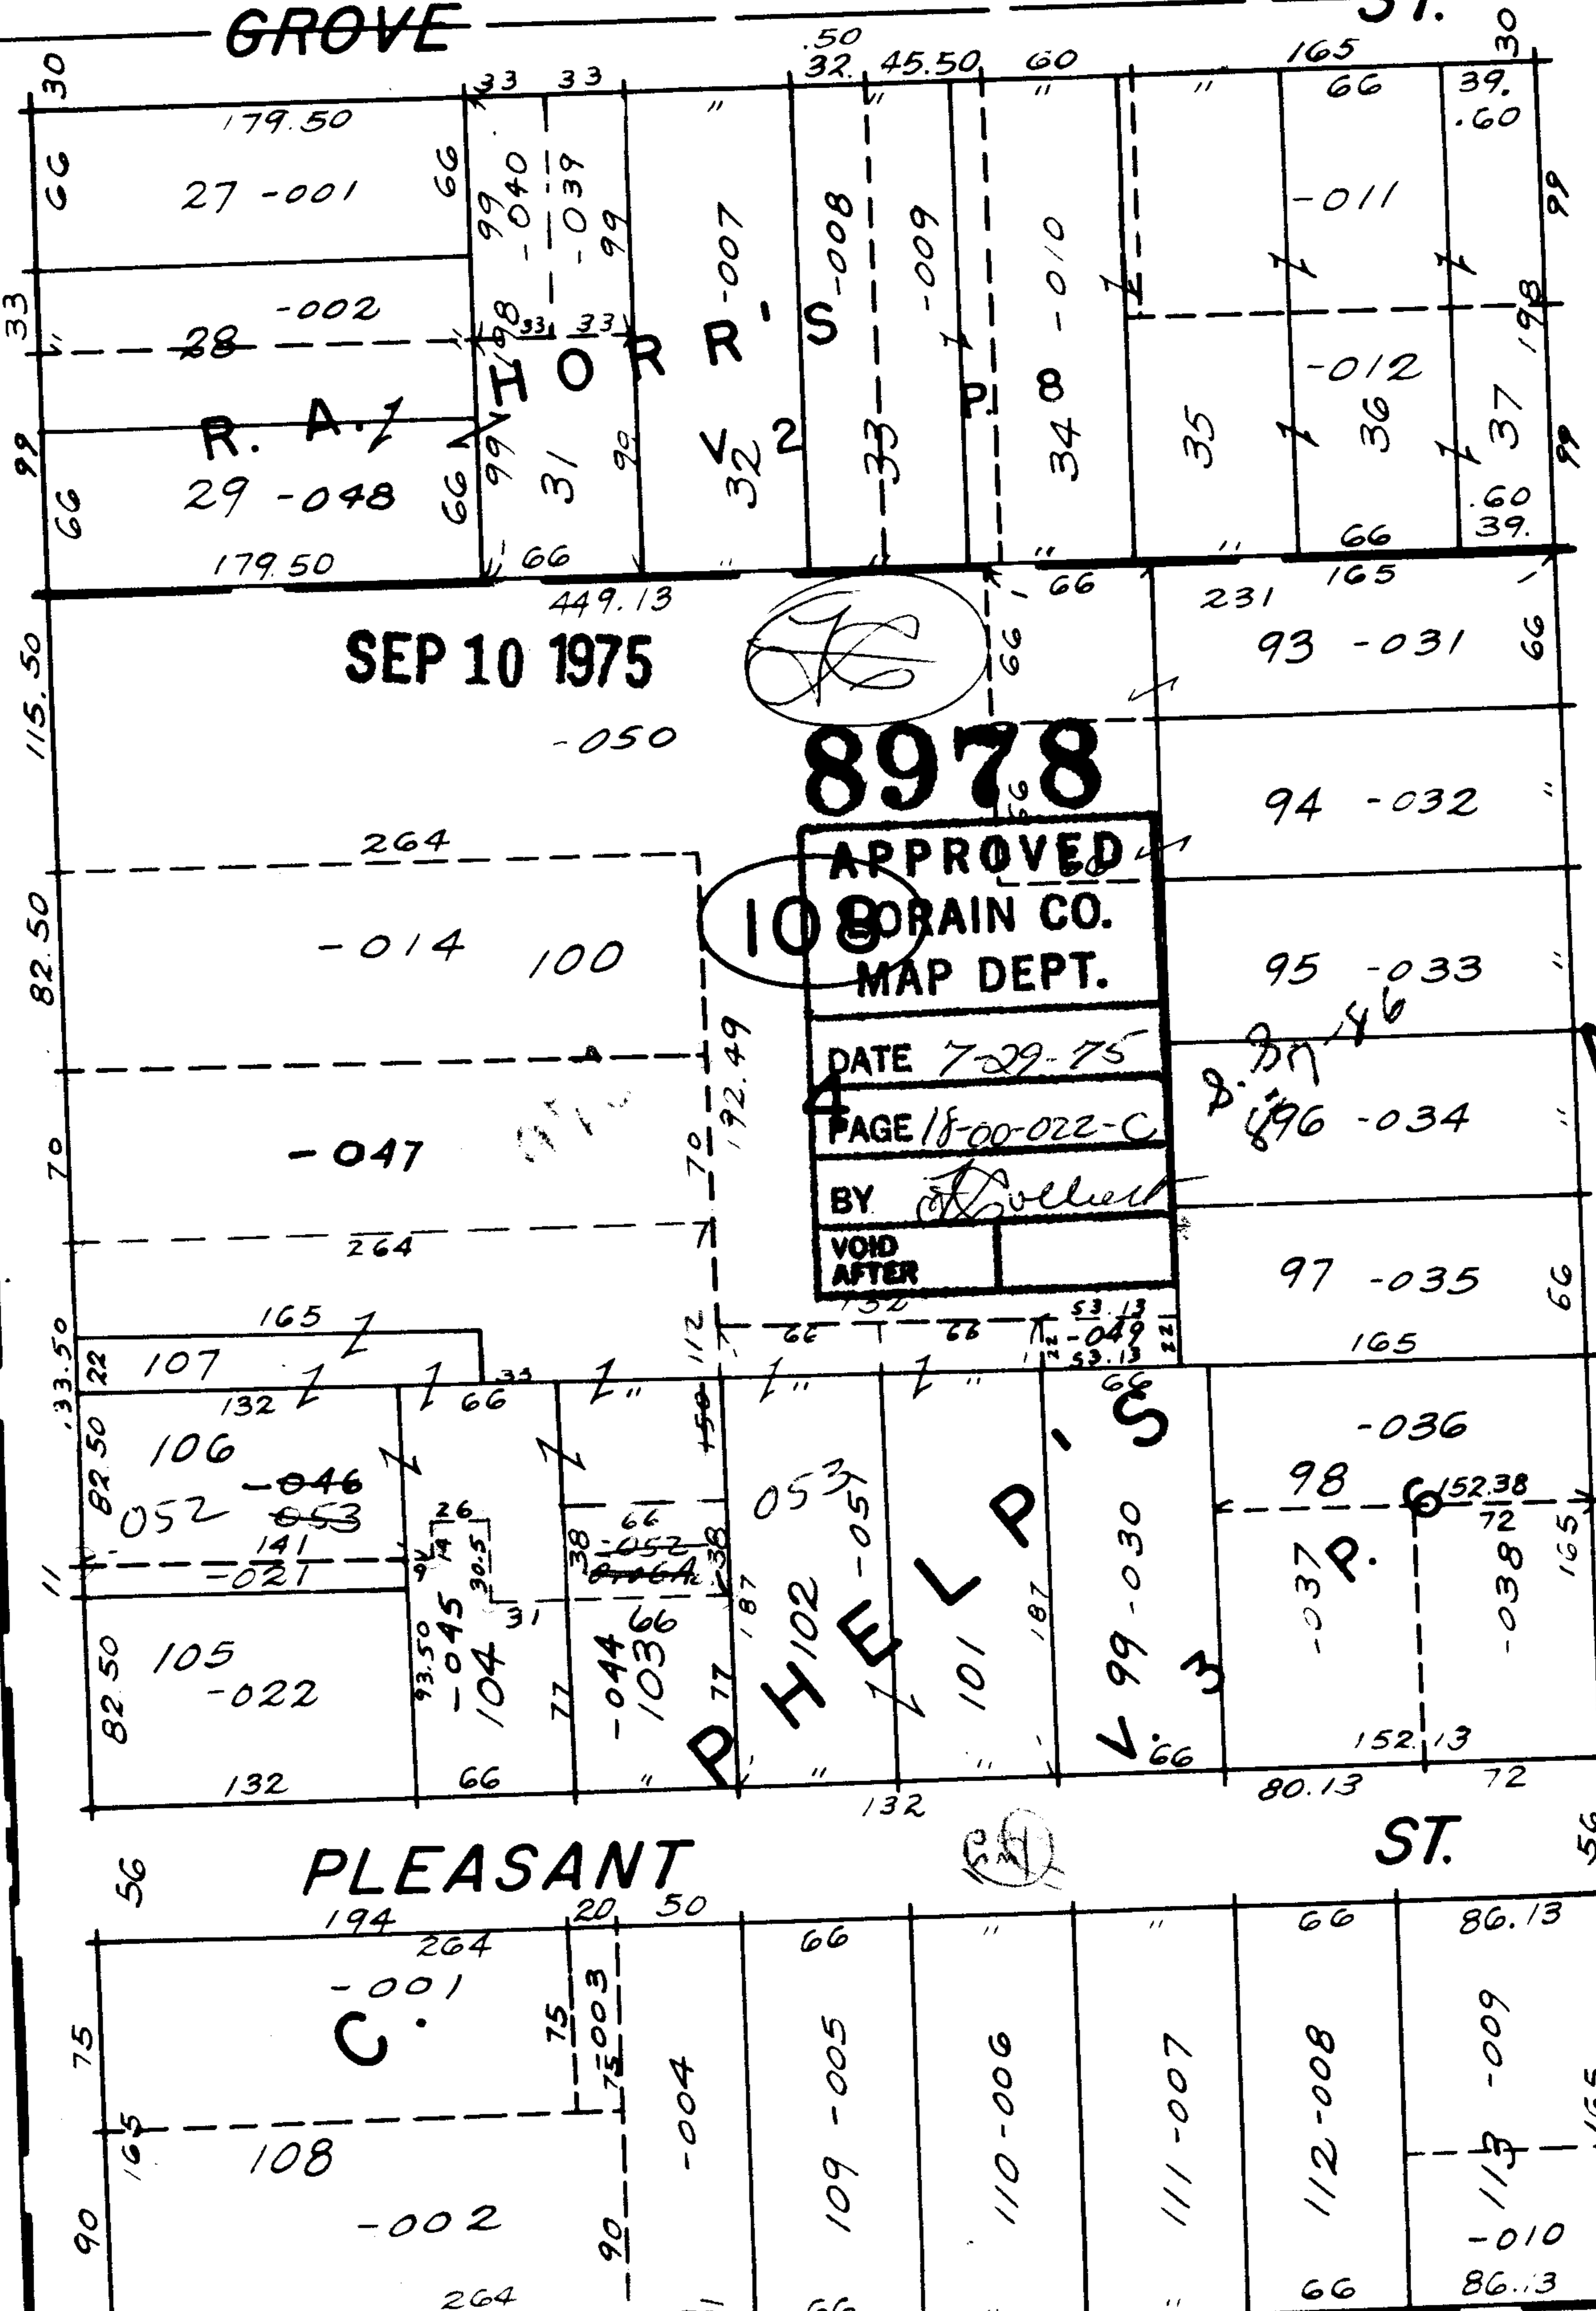

SEP 10 1975

8978

APPROVED
 BOBRAIN CO.
 MAP DEPT.
 DATE 7-29-75
 PAGE 18-00-022-C
 BY [Signature]
 VOID AFTER

20-027-D

PLEASANT ST.

ST.

COURTLAND