

9047

Capel Rd East

-012 600A

305 75
100 4
305 75

329.20
164.6

RD.

AUG 20 1975

98622

-016
~~-014~~
78.25 A
76.15A L

1896 291.02
-004
1.00A
-015 291.02
2.10A
460

Map Correction Here

1311.92

83

9047

APPROVED
DRAIN CO.
MAP DEPT.

DATE 8-18-75

PAGE 11 EN ~~11~~ SOUTH

BY L W Hall


VOID
STAMP

330
-005
0.76A
-006
0.61A

400
-013
2.38A
400

-007
44.28 A.

SEP 25 1975

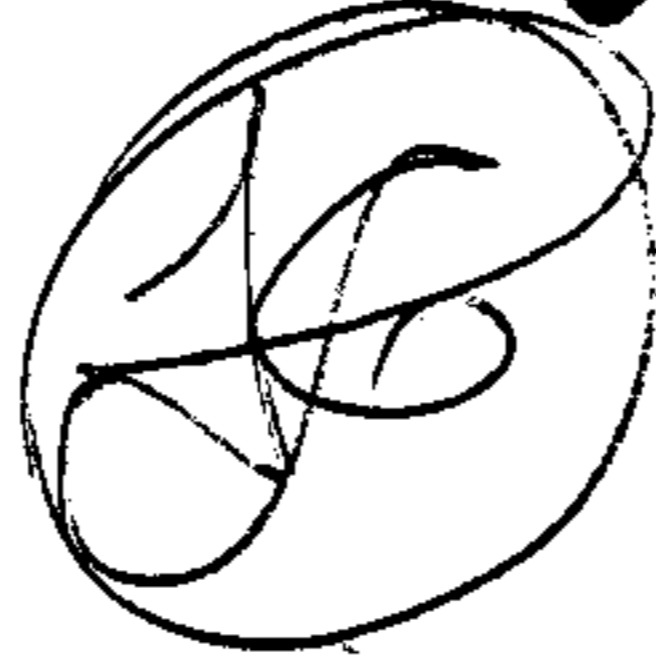

1185.61

311.70
-009
0.72
0.50A

-008 4.50 A. 1350.61

610.23
-128.65
-182

82

326
325