

47.61 A

1056 83

100.70

669.90

656.7

188.7
311.01
-004
1.39 Ac.
300


Max
Bot
100.64
-001
7.70 A

610

423
-002
2.19 A
423.7

9057

APPROVED LORAIN CO. MAP DEPT.
DATE 8-20-75
PAGE 19-D
BY <i>J. Doucet</i>
VOID AFTER

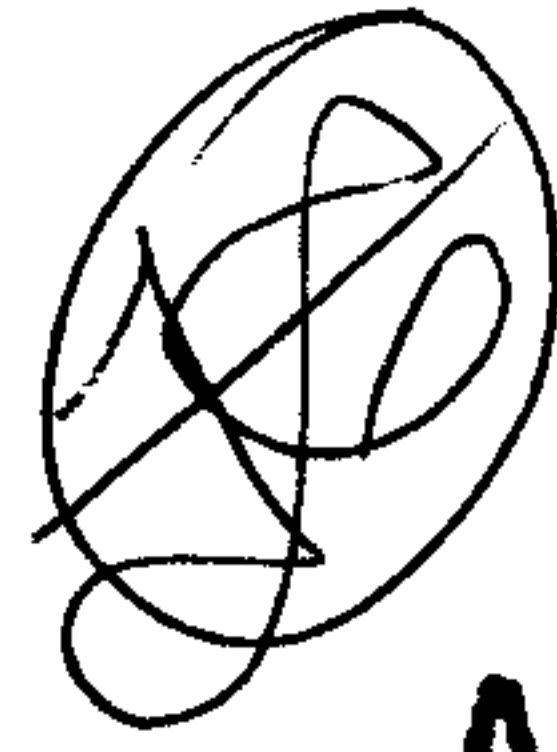

AUG 21 1975

SEP 10 1975

T

-001
56.50 A

36

3811.50
3778.50

-002
55.92 A

3778.50

48

C

A

-005
~~-003~~
~~-001~~

~~134.40 A~~
~~132.95 A~~
131.56 Ac.

R

T

132.95
1.39
131.56

6435

VERMONT 3027.85

(60)

260
-008
260
-009
260
260
260
260

(50)

MEDINA - NORWALK

TRACT 4 LOTS 36, 48, 49