



7A.

321.60
321.60

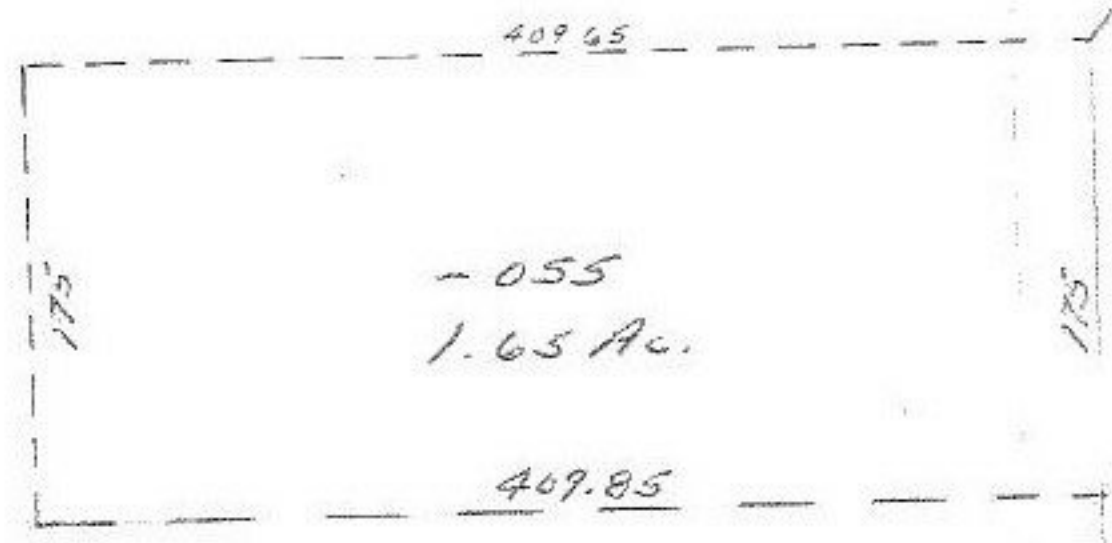

AUG 28 1975

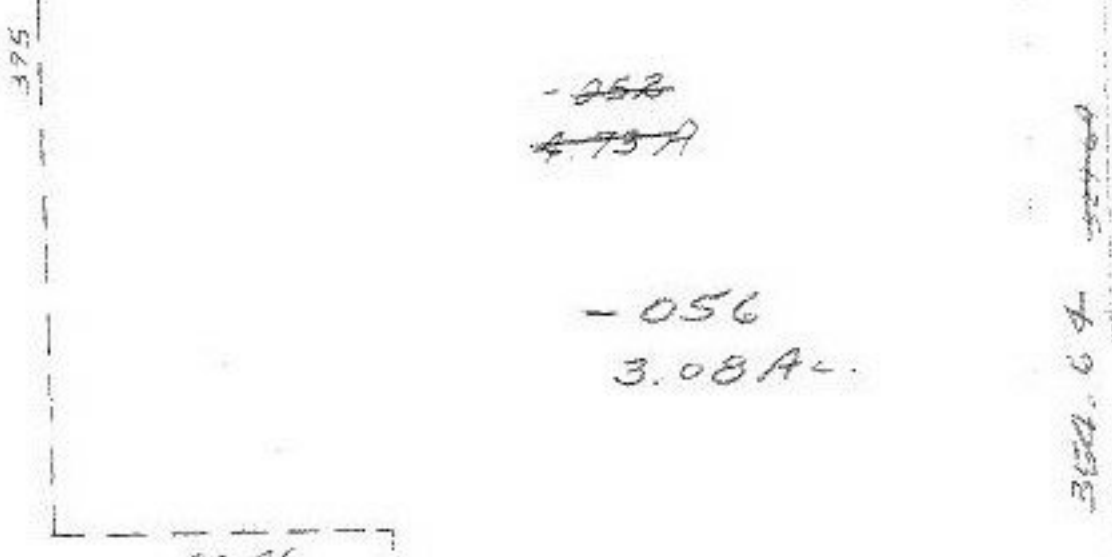

352.64

628.53

DEC 31 1975

~~4.73~~
~~1.65~~
~~3.08~~
~~529.64~~
~~175~~
~~354.64~~

8-5-86

9076

APPROVED
LORAIN CO.
MAP DEPT.

DATE 8-27-75

PAGE 4-00-016B

BY *Holland*

VOID AFTER 9076

-009
4.50 Ac.

WOOSTER AVON LAKE

528.40