


9129

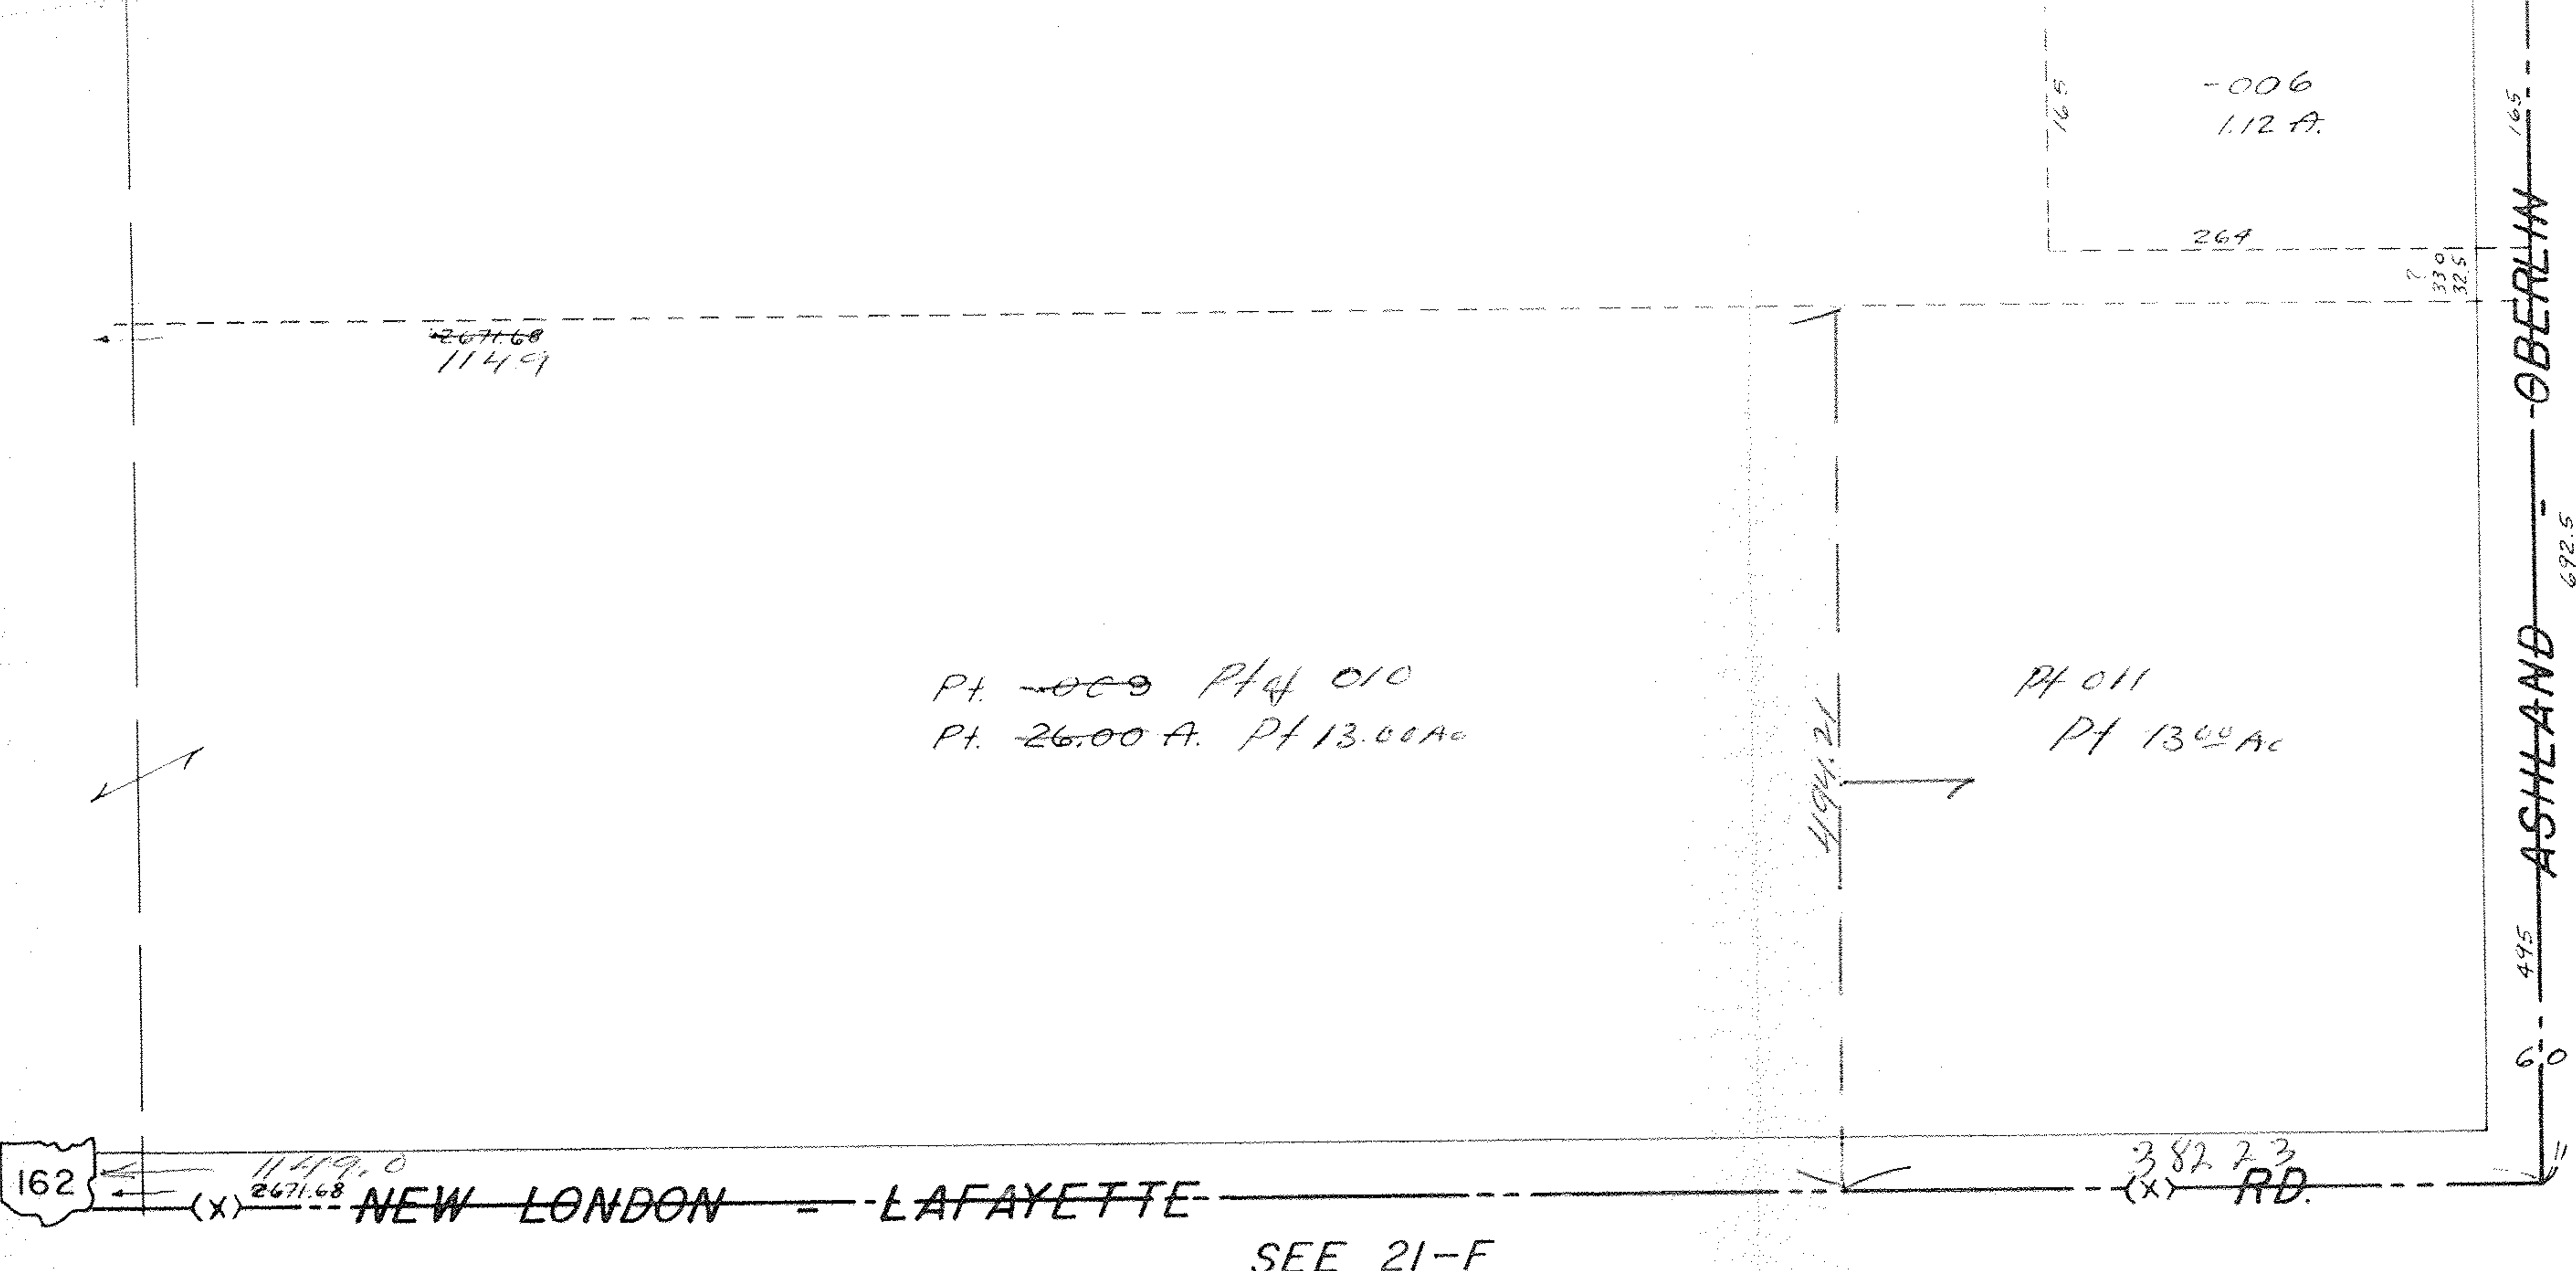

9129

APPROVED
LORAIN CO.
MAP DEPT.
DATE 9-19-75
PAGE 21-05-001B
BY L.W. Hall
VOID AFTER

(Signature)

OCT 8 1975
SEP 23 1975

162

HUNTINGTON TWP.

SCALE: 1" = 100'

TRACT 5 ELY. PT. LOT 1

21-05-001-B

Copyright 1962